RASTER

PARENT PARCEL: 12-00-050-000-028
CHILD PARCEL: 12-00-050-000-032, -033 12-00-051-000-070, -071
STARTING POINT: CENTERLINE OF COLUMBIA WEST RIVER RD & LORAIN COUNTY LINE

06-02151

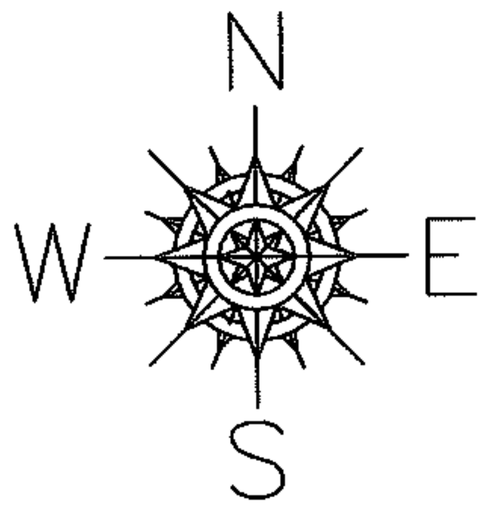


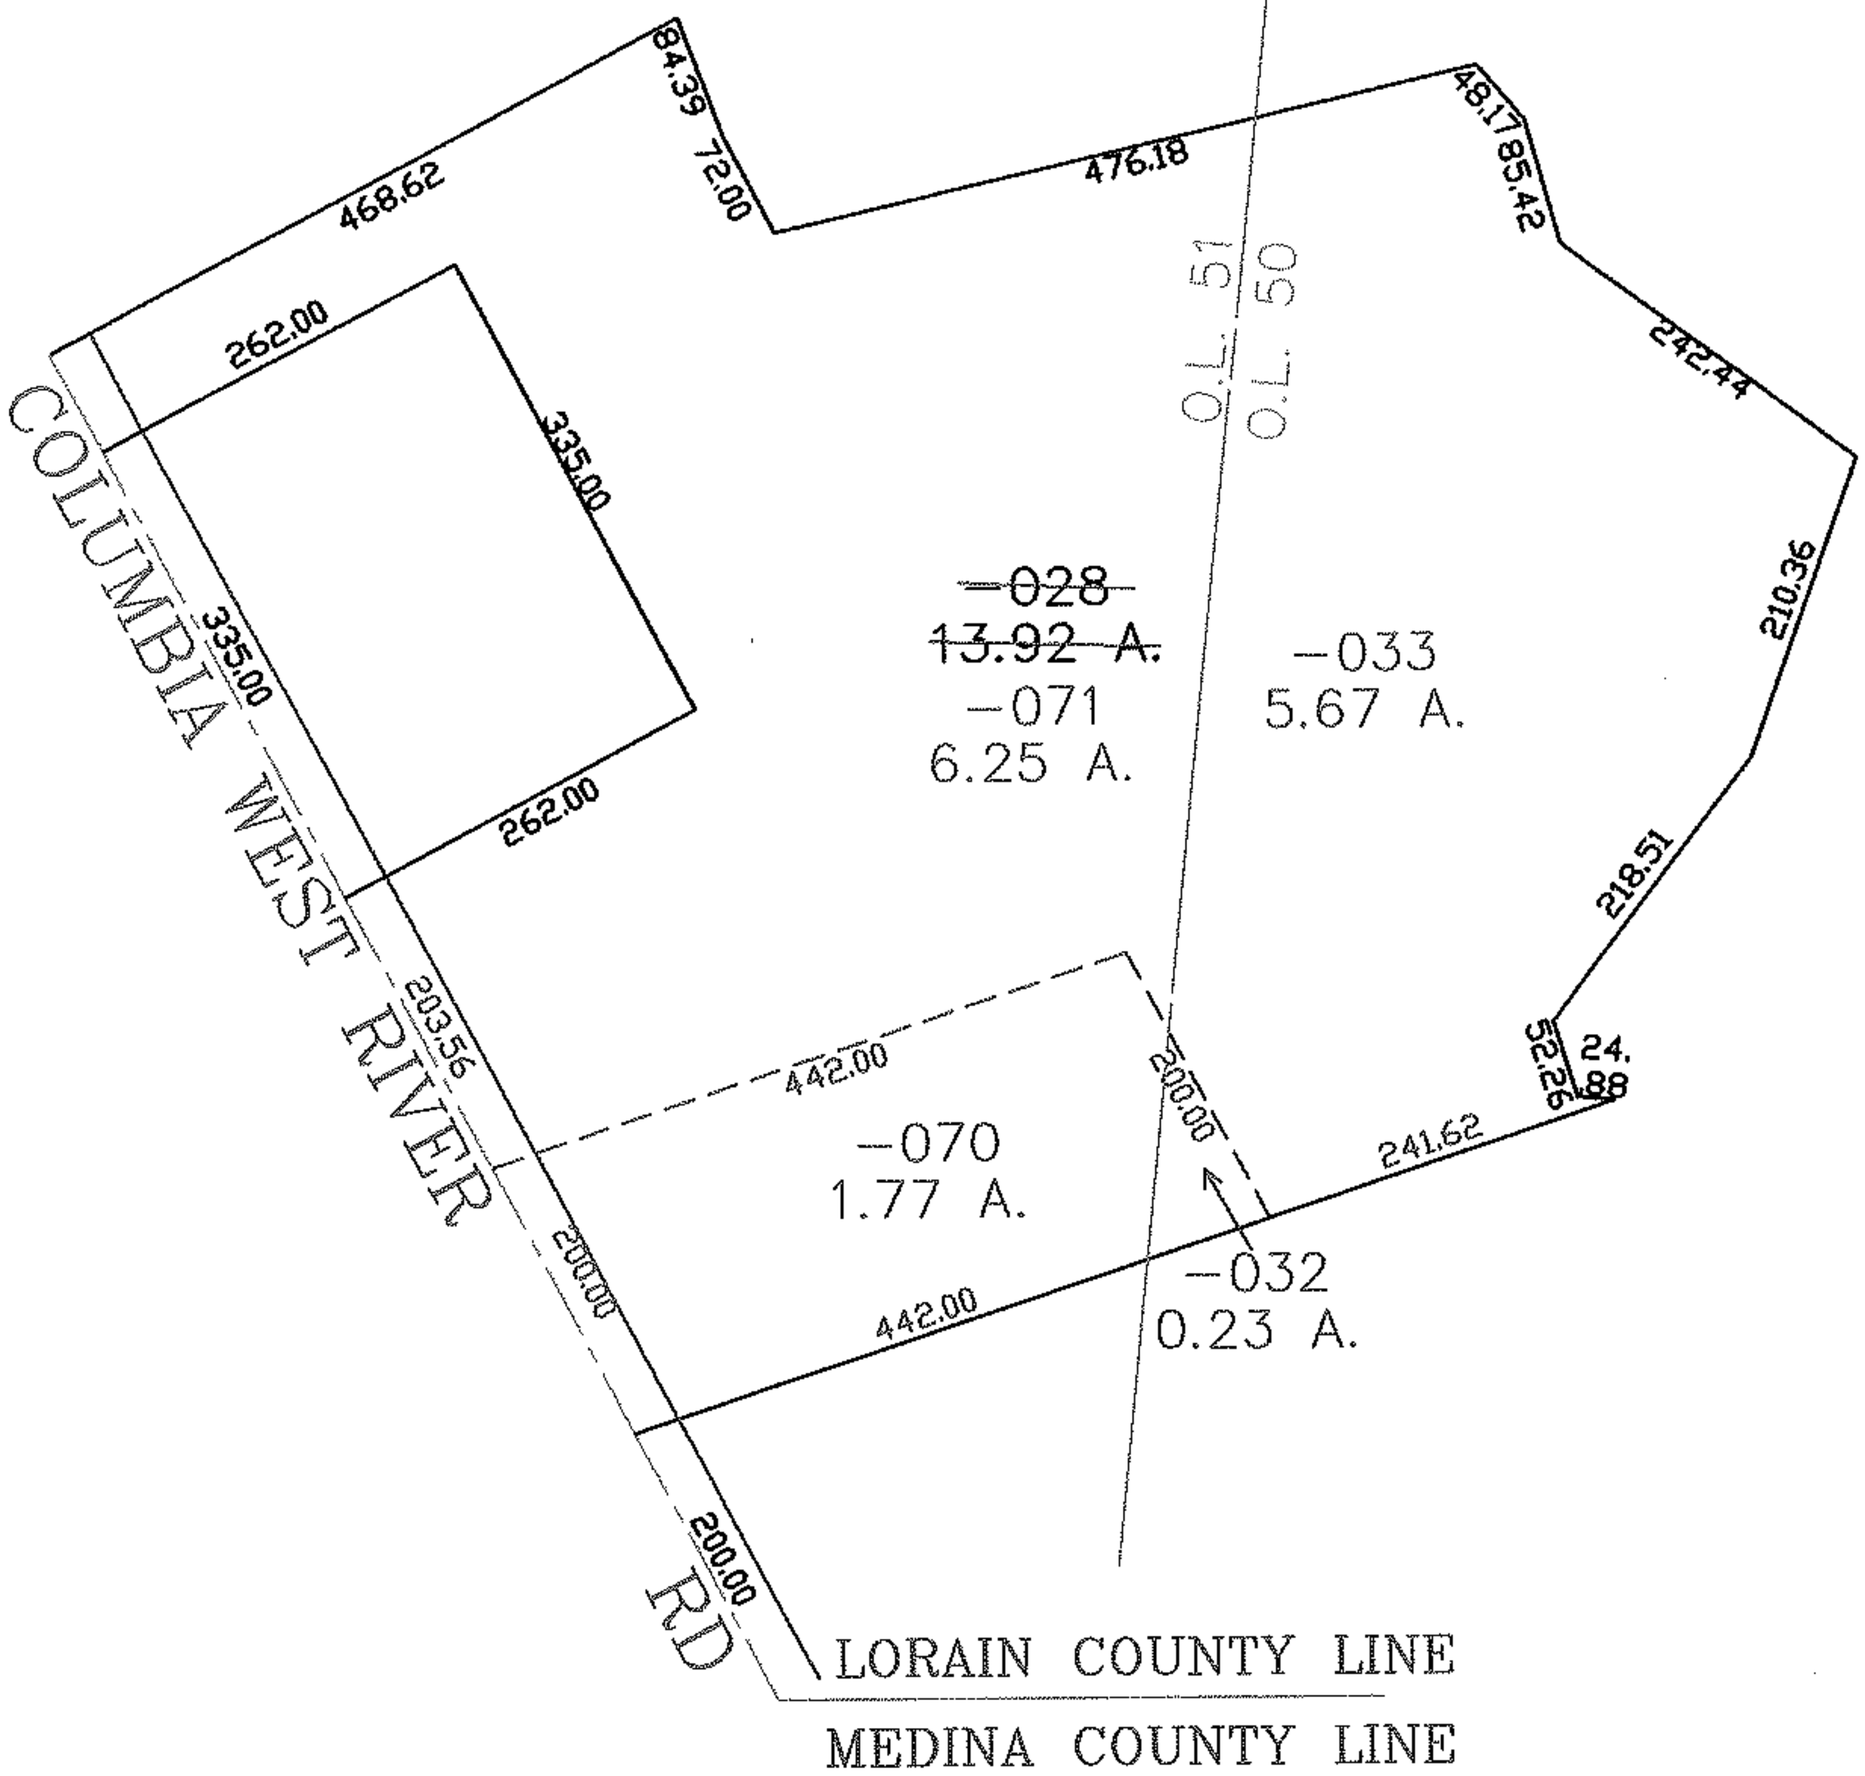


SPLITS/DEEDS PROCESSED

LORAIN COUNTY TAX MAP DEPARTMENT
226 MIDDLE AVE. ELYRIA, OHIO

SURVEYED BY: JAMES ROOT
CLOSURE: 0.00 : 10,000
MAP PAGE(S): 12-G
APPROVED BY: JAH DATE: 5-23-06
SCALE: 1"= 200 PRIOR INSTRUMENT: DV 1396/992