PARENT PARCEL: 02-02-021-101-032

CHILD PARCEL: 02-02-021-101-051 THRU -054 02-02-020-102-019, -020

STARTING POINT: CENTERLINE OF PUEBLO RD & O.L. 21

06-02153

N

W E

S

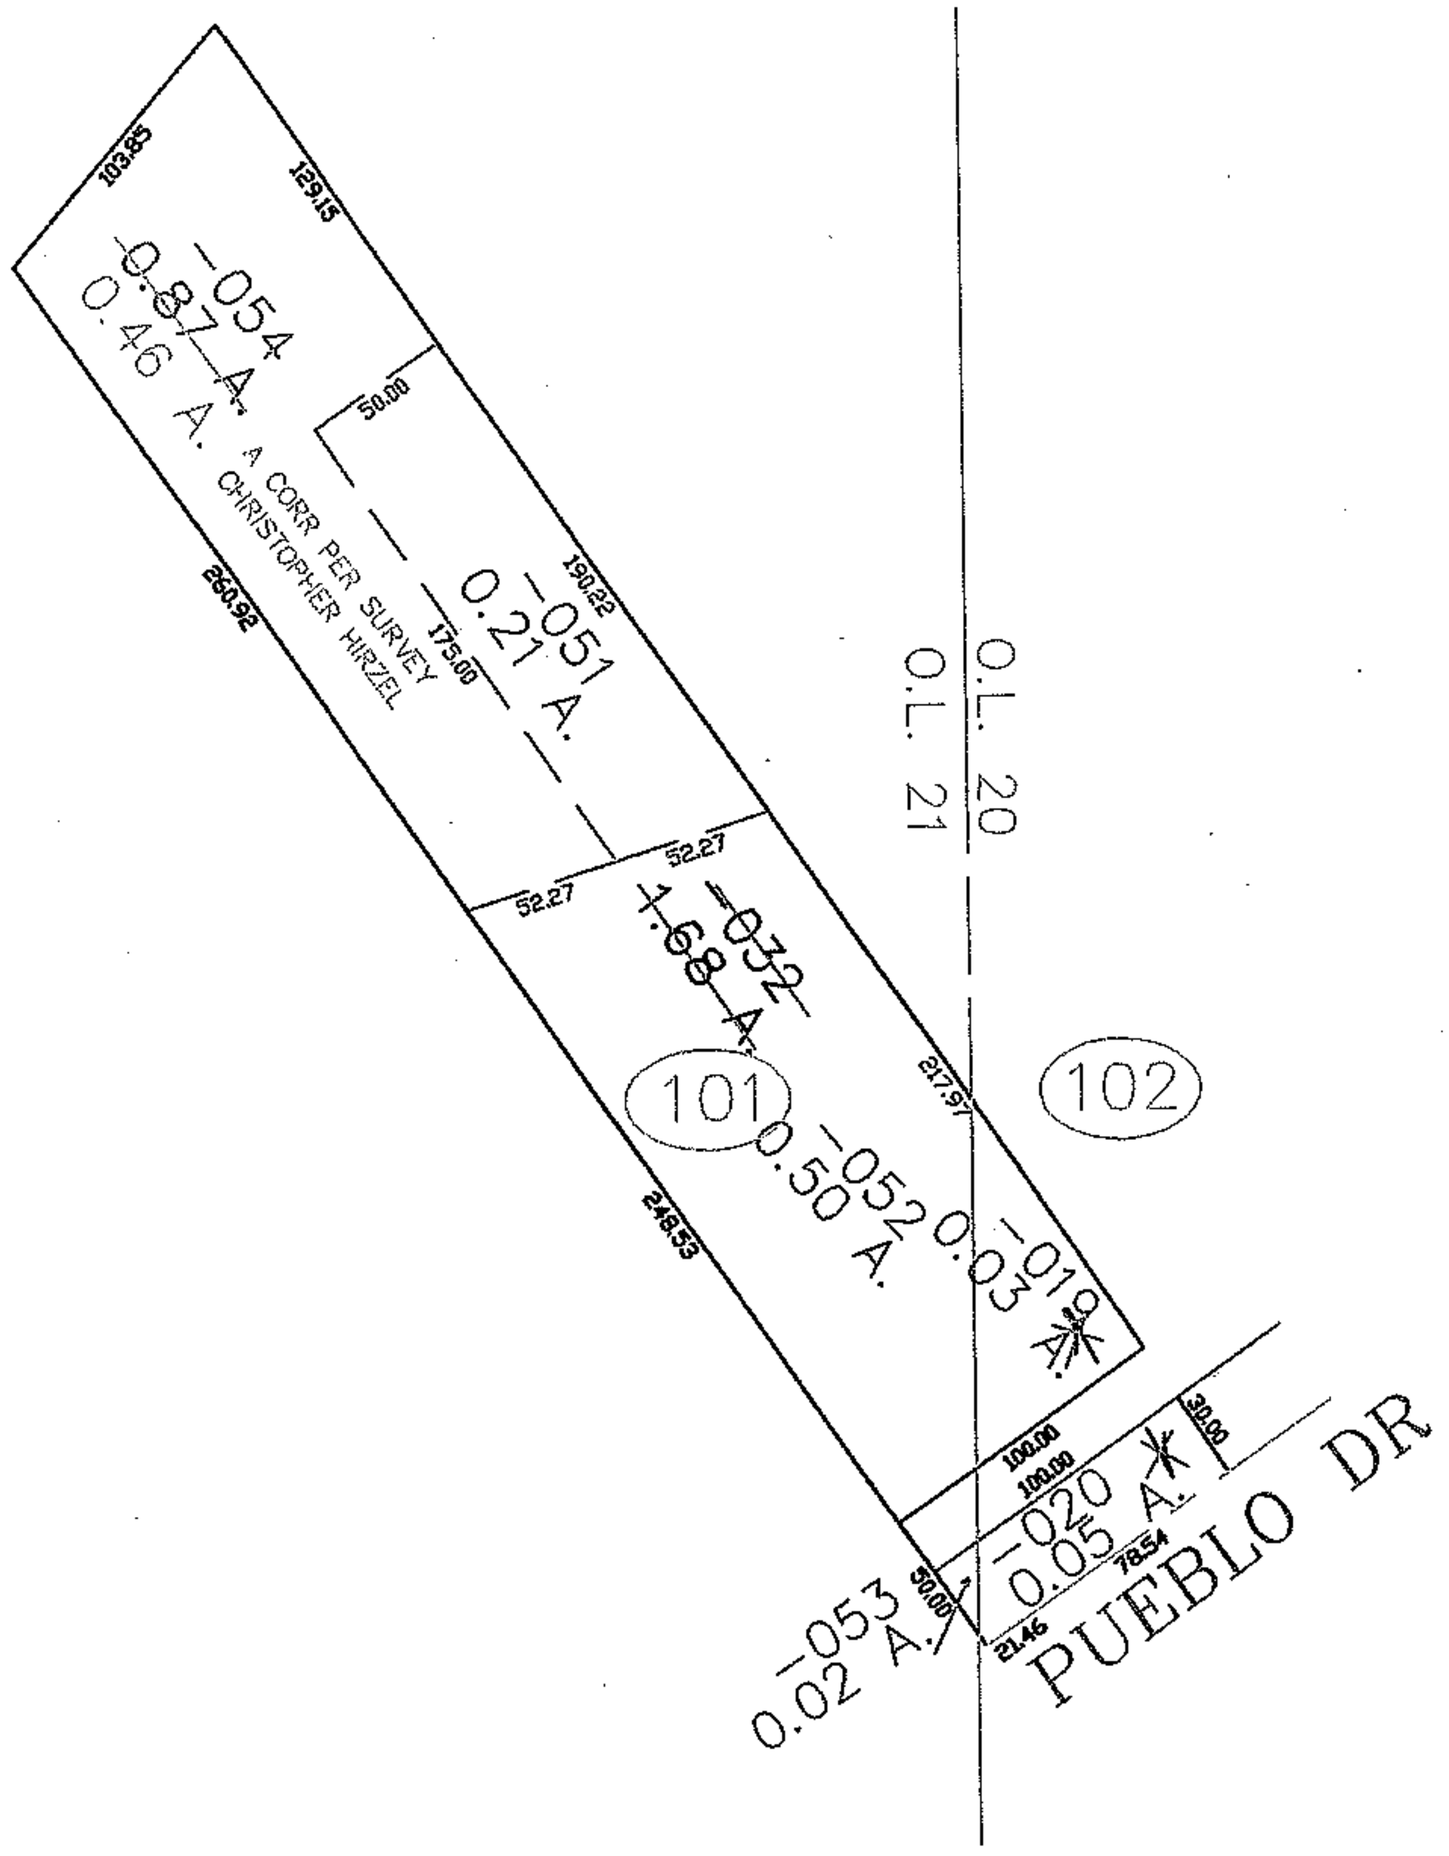

SPLITS/DEEDS PROCESSED

LORAIN COUNTY TAX MAP DEPARTMENT
226 MIDDLE AVE. ELYRIA, OHIO

SURVEYED BY: CHRISTOPHER HIRZEL

CLOSURE: 0.00 : 10,000

MAP PAGE(S): 02-02-021-B

APPROVED BY: JAH DATE: 5-17-06

SCALE: 1"= 100 PRIOR INSTRUMENT: 20000684263