RASTER

PARENT PARCEL: 12-00-001-000-027, -026
CHILD PARCEL: 12-00-001-000-030 THRU -037
STARTING POINT: CENTERLINE OF SPRAGUE RD & MARKS RD

06-02172

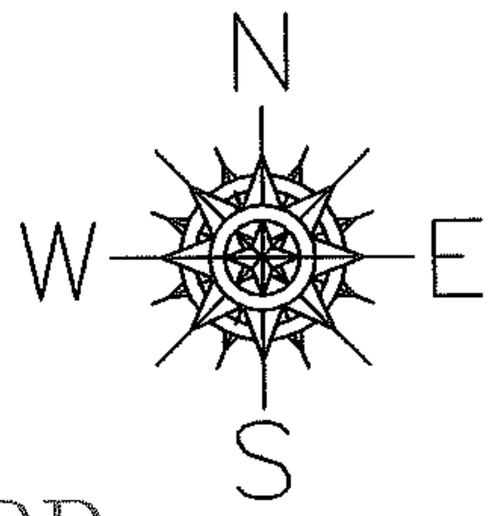

SPRAGUE RD

259.18

365.82

~~-033~~
~~2.03 A.~~
~~1.88 A.~~
A CORR PER SURVEY
JOHN POZYWAK

325.00

300.50

~~-027~~
~~4.81 A.~~

~~-031~~
~~4.55 A.~~

-032
2.52 A.

300.50

MARKS RD

-037
~~2.48 A.~~
2.46 A.
A CORR PER SURVEY
JOHN POZYWAK

460.30

~~-030~~ ~~0.26 A.~~

24.50

24.50

164.78

460.15

~~-026~~ ~~-035~~
~~1.80 A.~~ ~~1.20 A.~~

-036
~~1.46 A.~~
1.47 A.
A CORR PER SURVEY
JOHN POZYWAK

~~-034~~
~~0.60 A.~~

121.94

172.40

190.29

190.00

96.00

41.91

31.71

40.00 62.77

SPLITS/DEEDS PROCESSED

LORAIN COUNTY TAX MAP DEPARTMENT
226 MIDDLE AVE. ELYRIA, OHIO

SURVEYED BY: JOHN POZYWAK
CLOSURE: 0.00 : 10,000
MAP PAGE(S): 12-00-001-B
APPROVED BY: JAH DATE: 6-19-06
SCALE: 1"= 100 PRIOR INSTRUMENT: OR 649/264