PARENT PARCEL: 09-00-094-102-009, -018, -022, -023, -024, -026, -027

CHILD PARCEL:

STARTING POINT: S/L'S 92 THRU 95 IN ILIPHALET FOLLETT'S SUB. NO. 2(VOL.3 PG.9)

11-02184-D

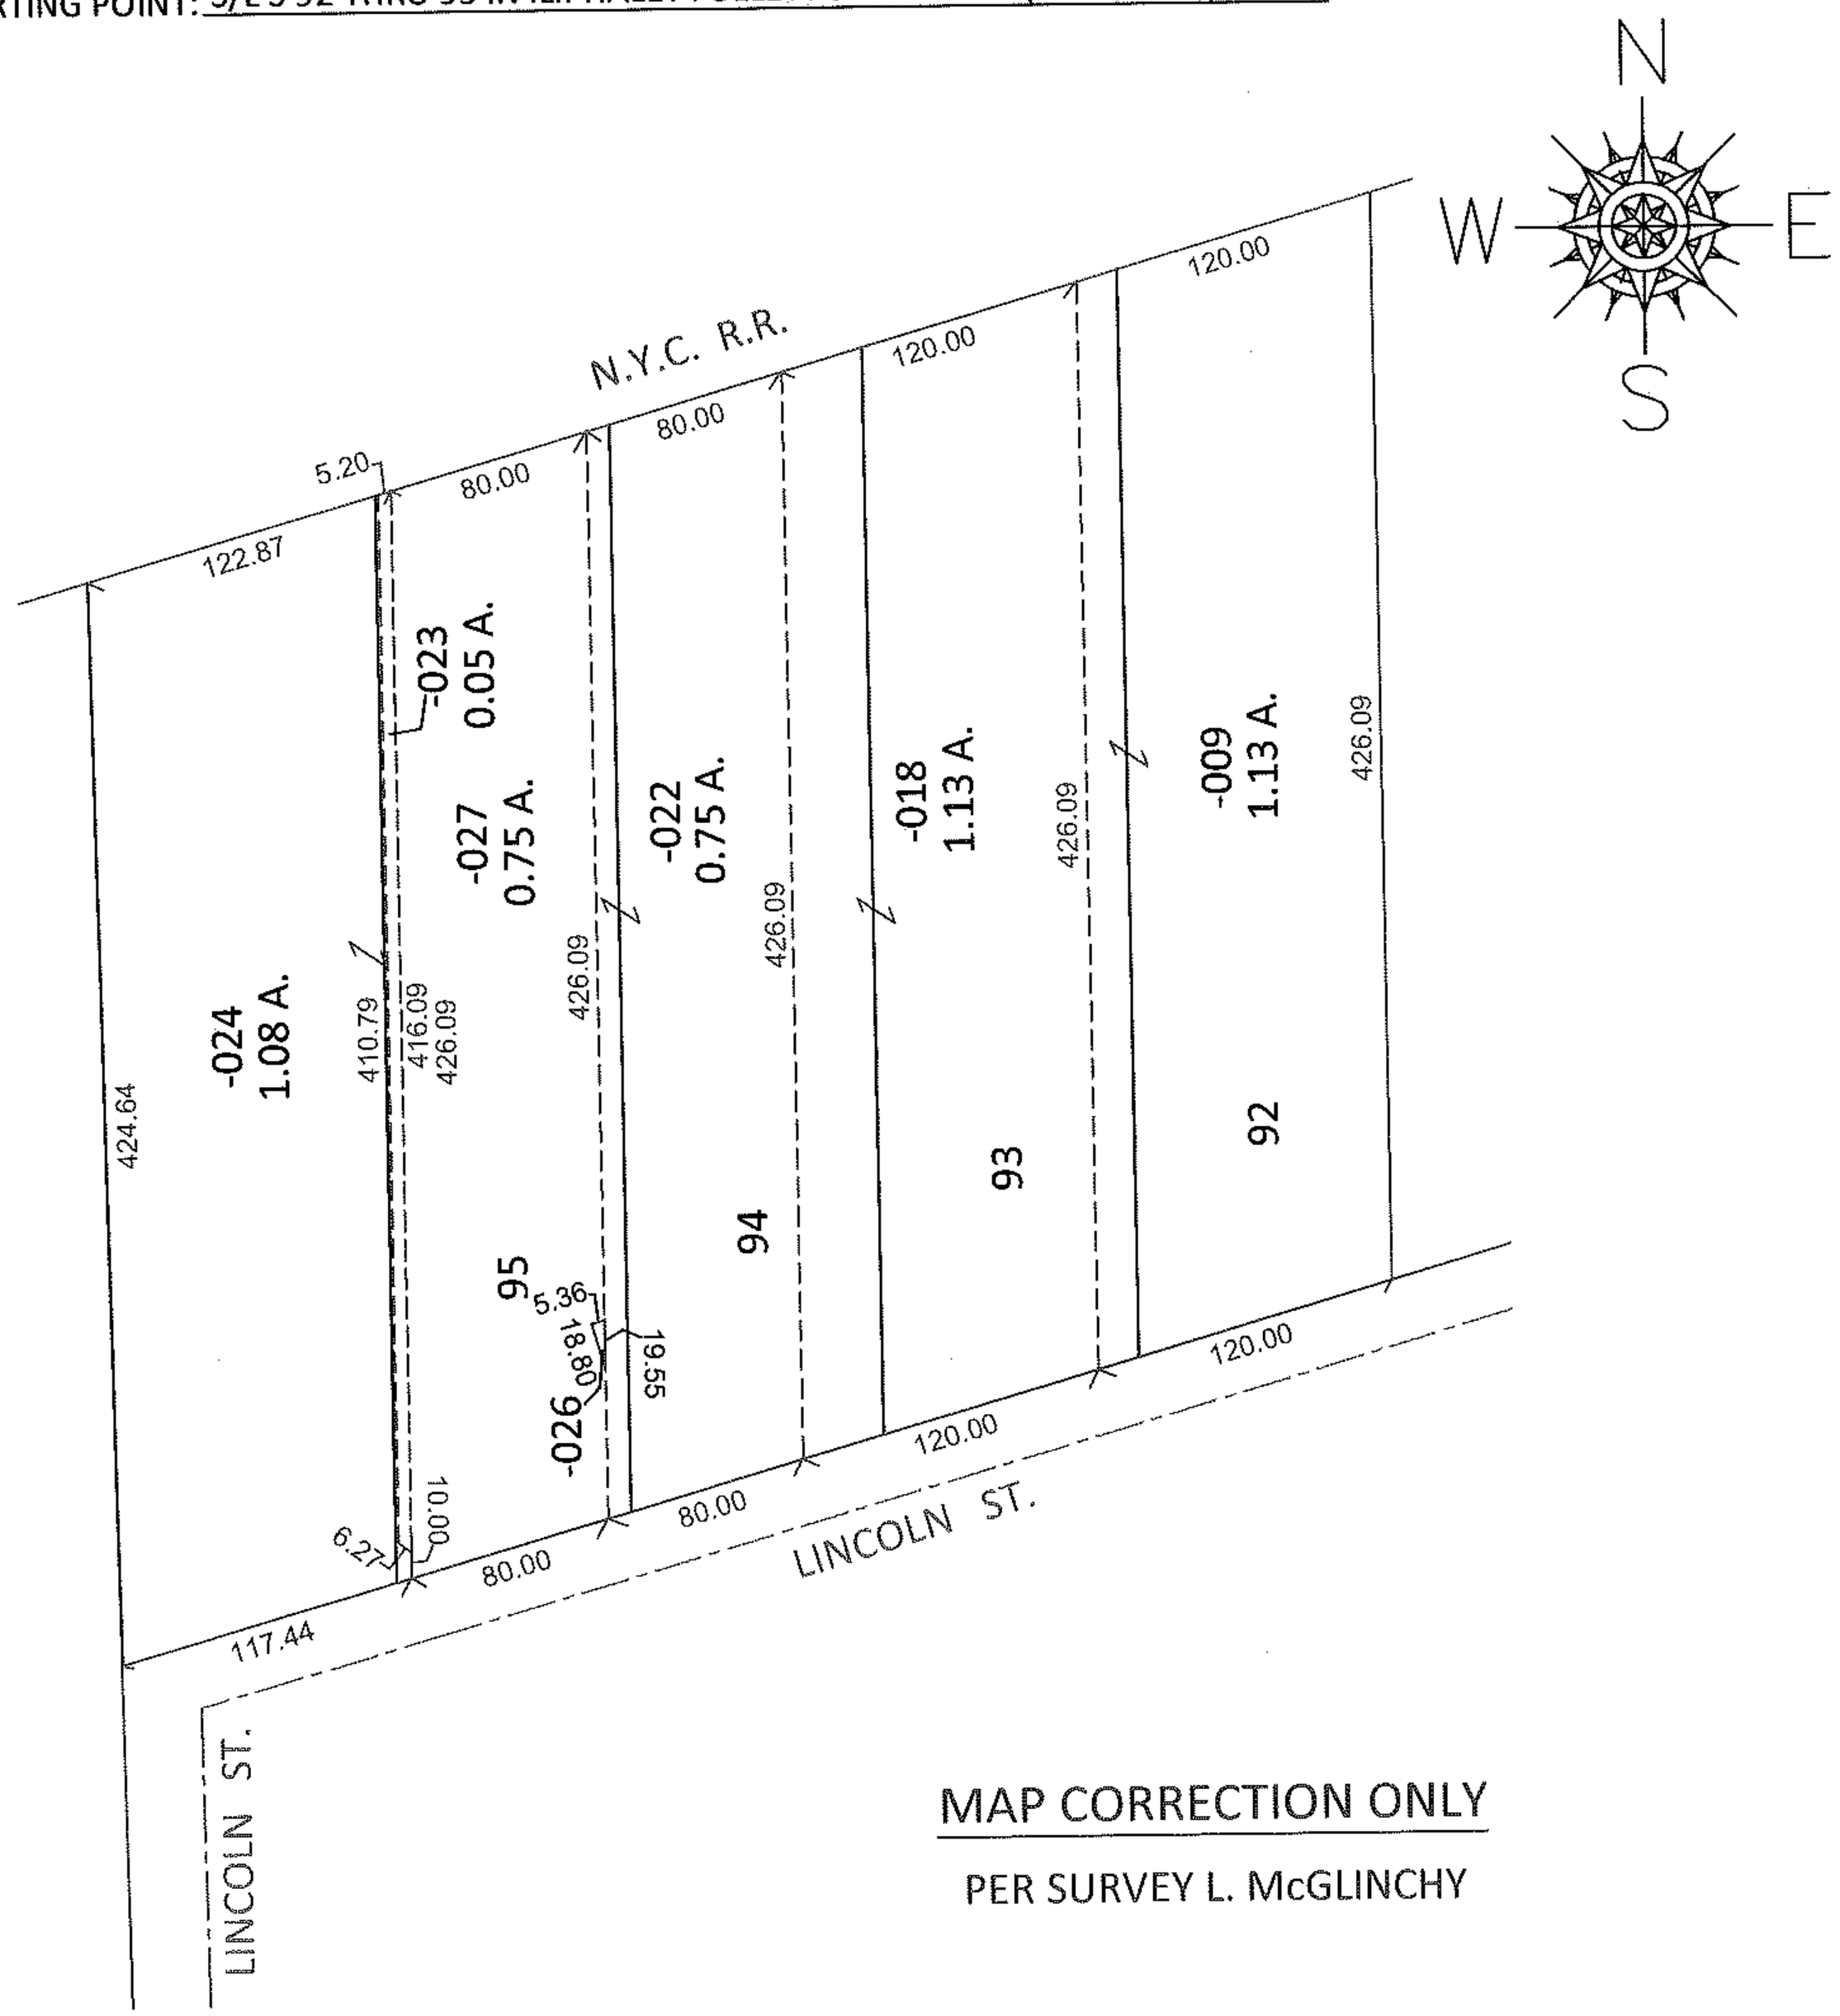

MAP CORRECTION ONLY

PER SURVEY L. McGLINCHY

SPLITS/DEEDS PROCESSED

LORAIN COUNTY TAX MAP DEPARTMENT
226 MIDDLE AVE. ELYRIA, OHIO

SURVEYED BY: LAWRENCE V. MCGLINCHY
CLOSURE: .00:10,000
MAP PAGE(S): 9-00-094-B
APPROVED BY: RRM DATE: 1-6-11
SCALE: 1"= 100 PRIOR INST.: 20070231265