PARENT PARCEL: 07-00-013-000-202, -041

CHILD PARCEL: 07-00-013-000-372 THRU -374

STARTING POINT: CENTERLINE OF BUTTERNUT RIDGE RD & ISLAND RD

06-02187

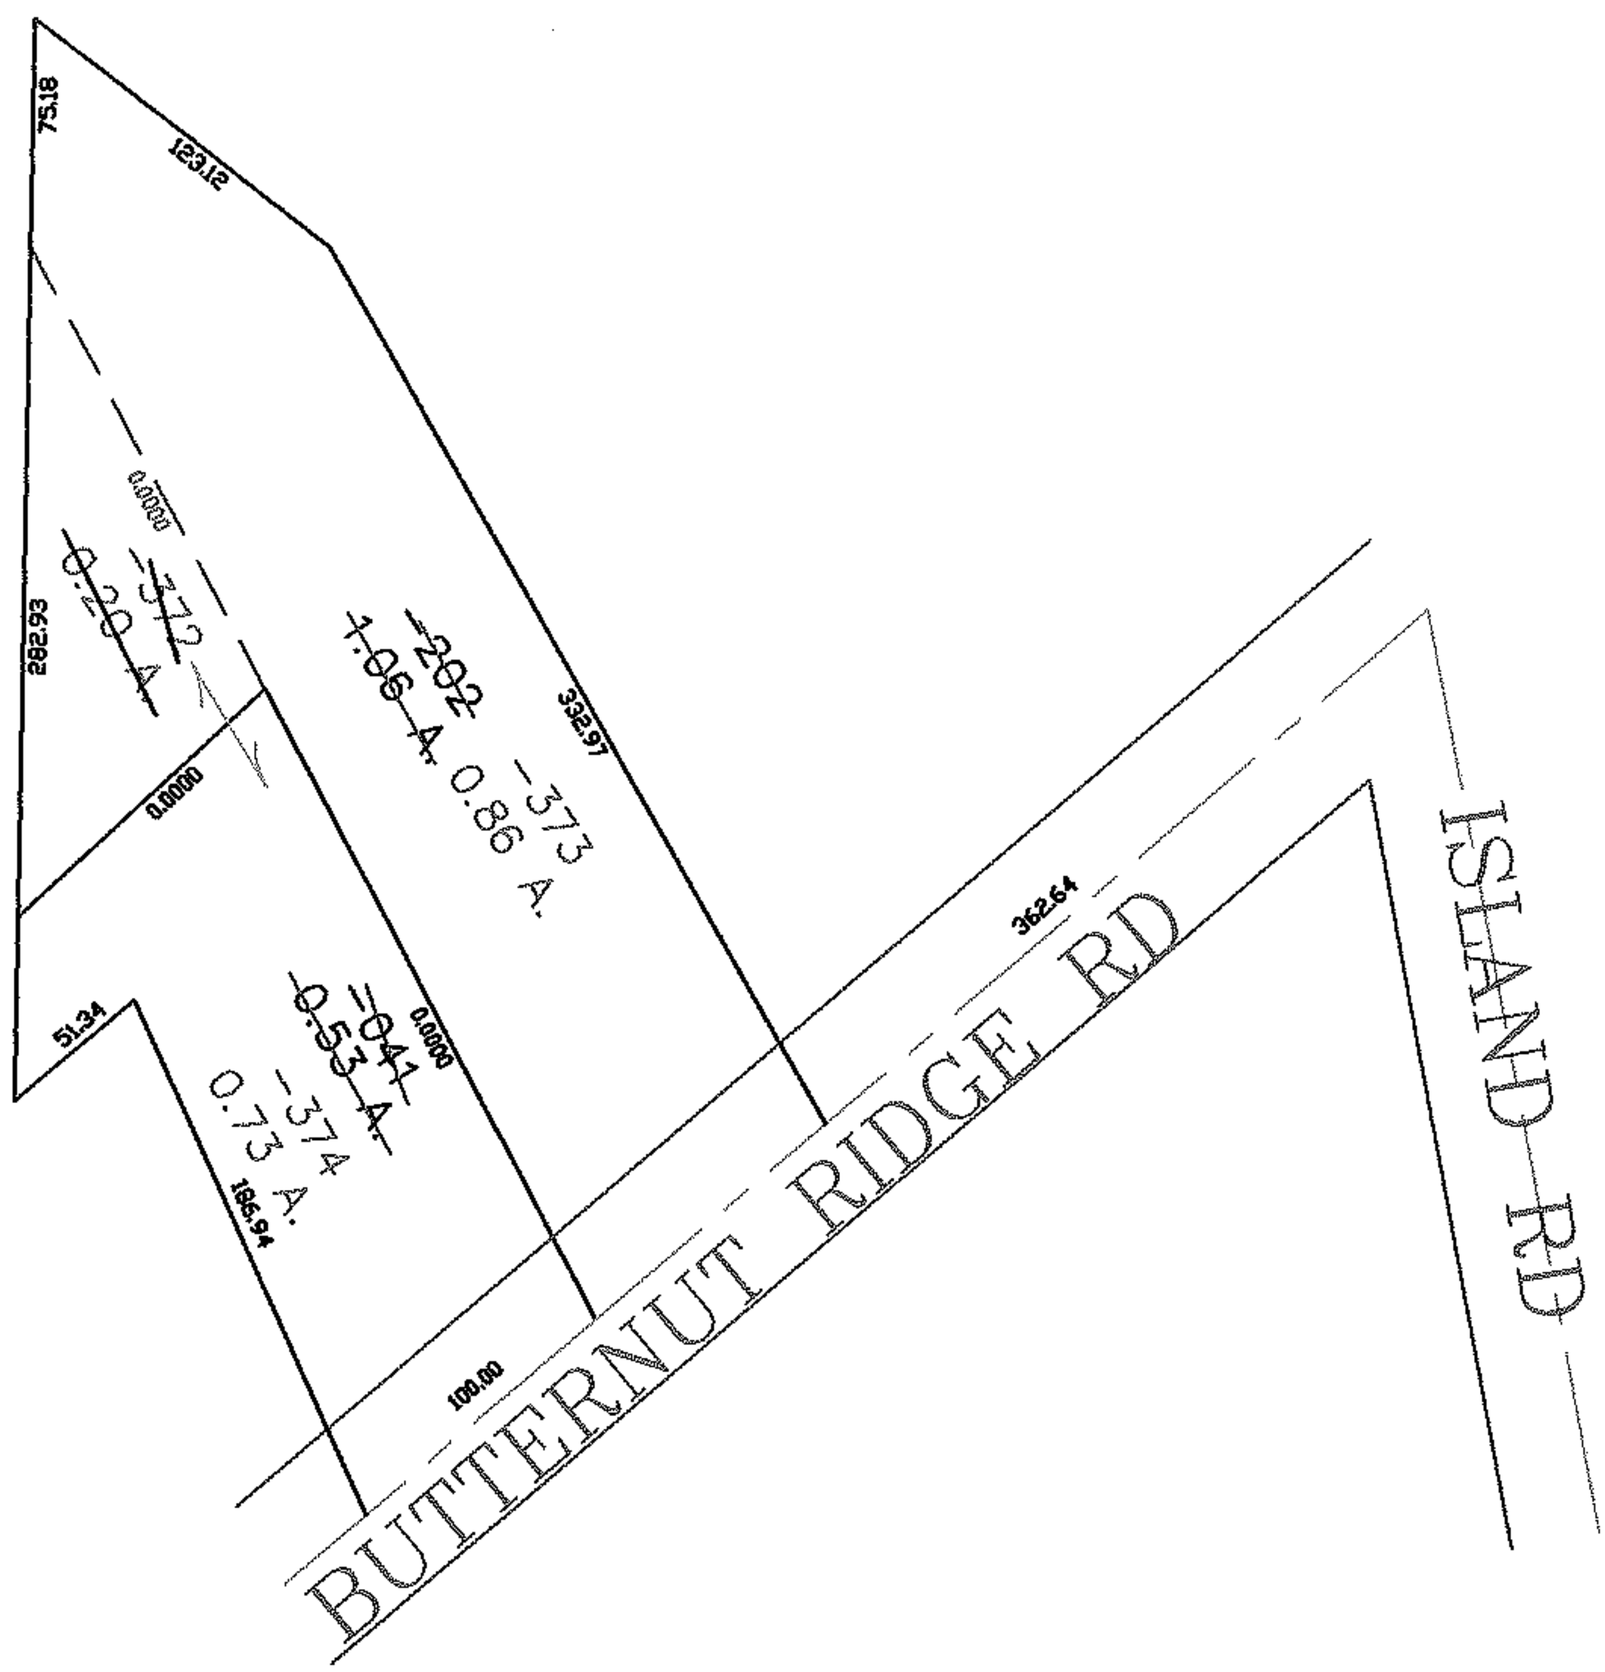

SPLITS/DEEDS PROCESSED

LORAIN COUNTY TAX MAP DEPARTMENT
226 MIDDLE AVE. ELYRIA, OHIO

SURVEYED BY: DAVID ELWELL

CLOSURE: 0.00 : 10,000

MAP PAGE(S): 07-00-013-A

APPROVED BY: JAH DATE: 7-17-06

SCALE: 1"= 100 PRIOR INSTRUMENT: 20000692581