06-02210

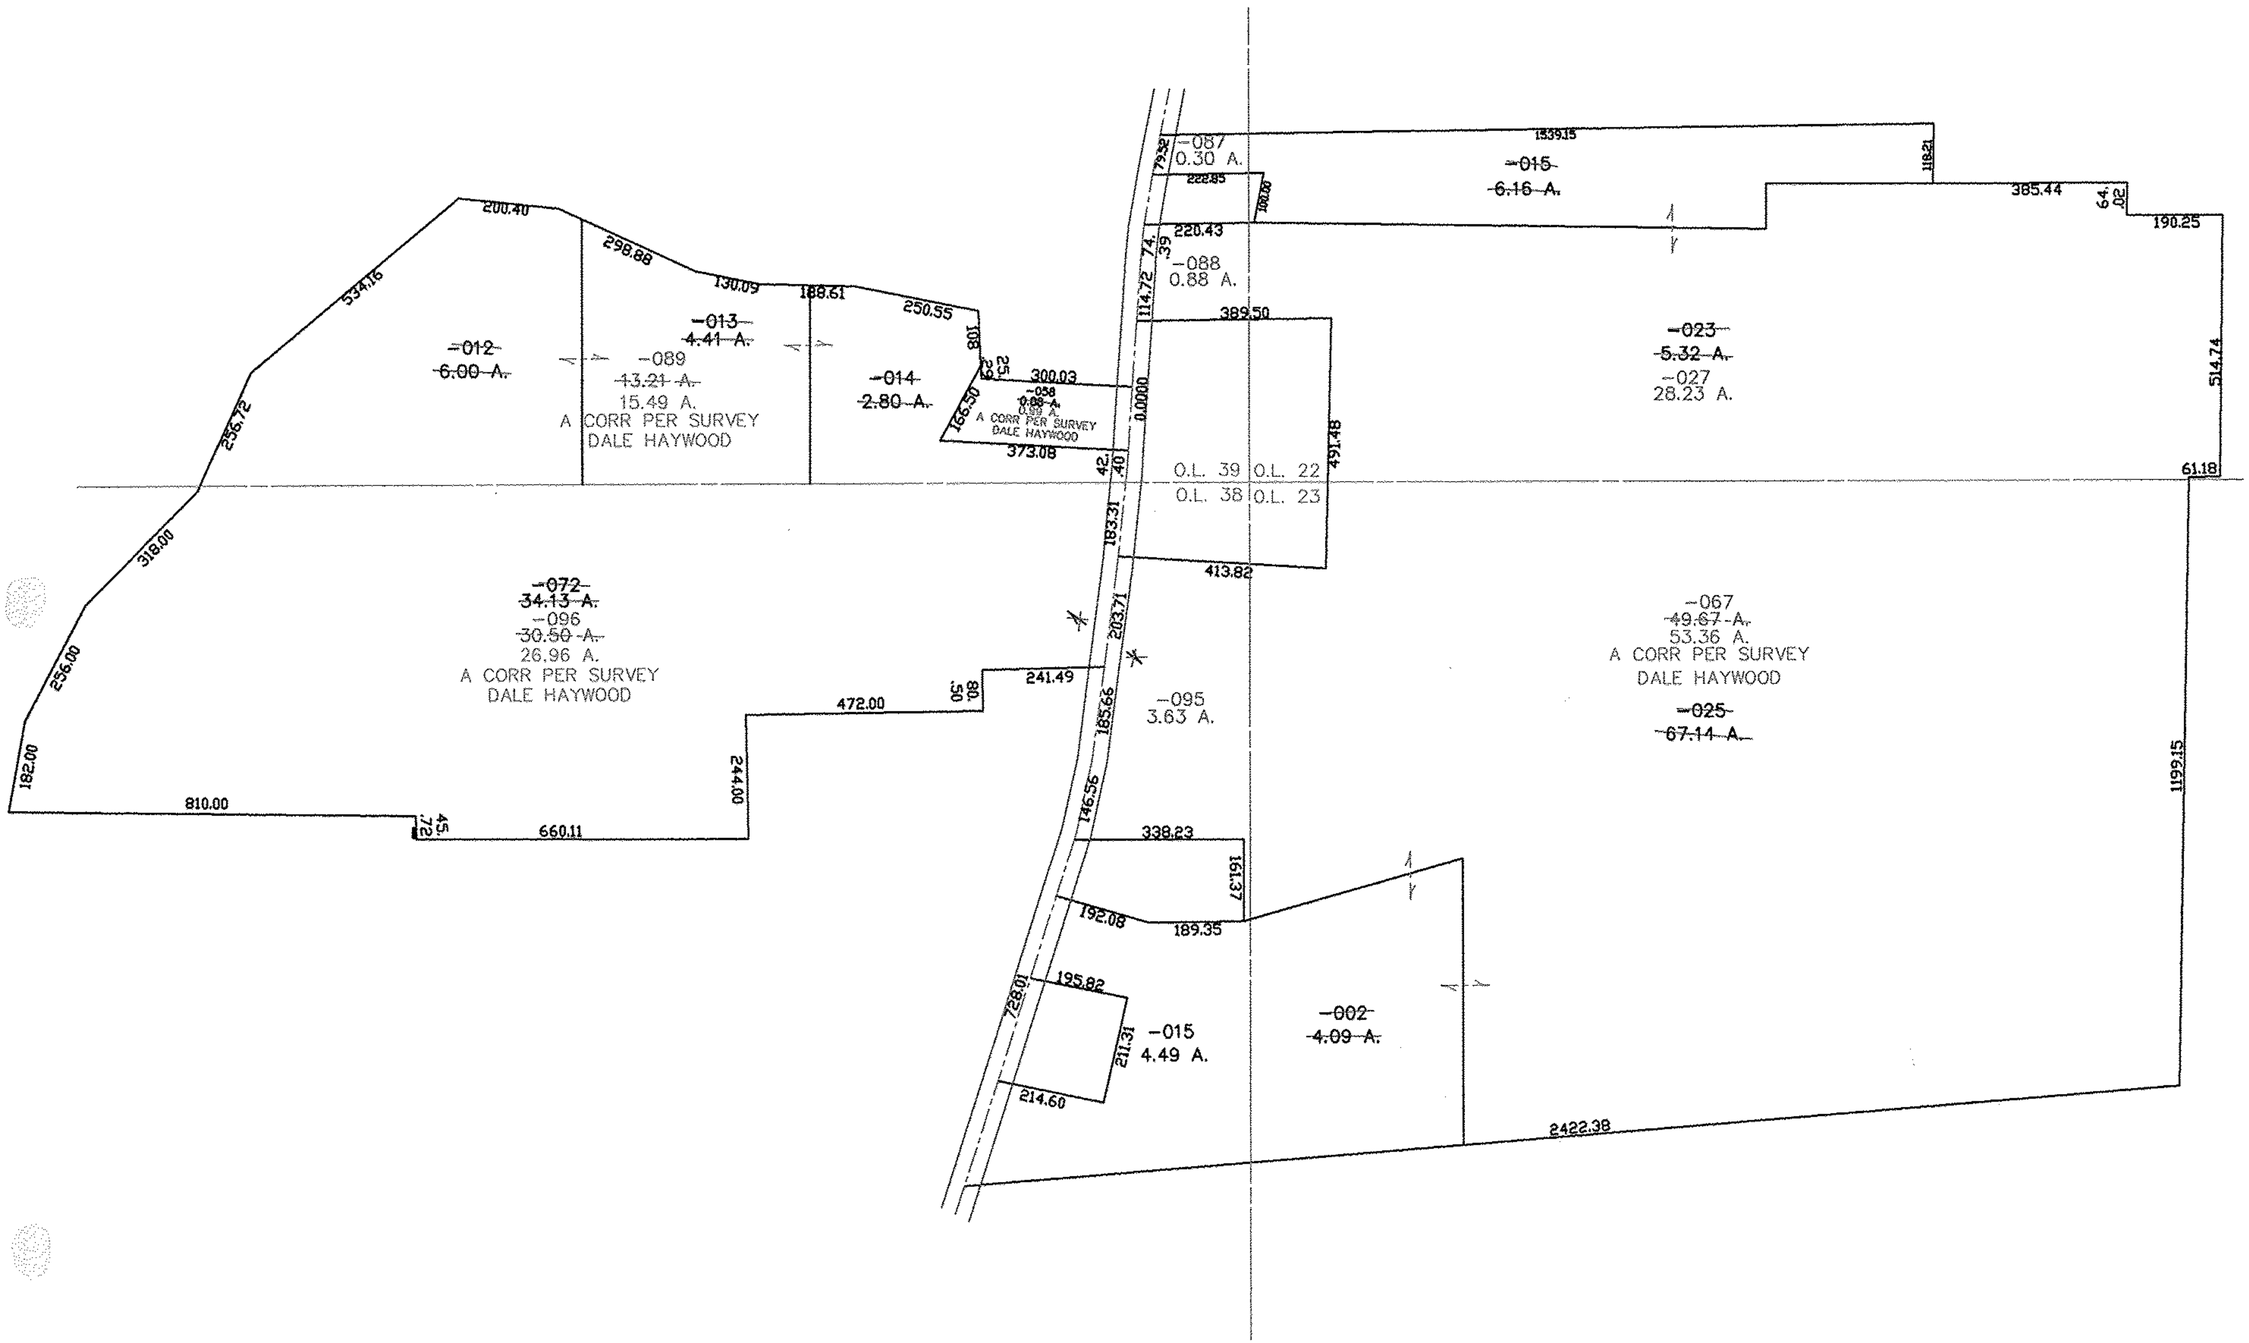

-087
0.30 A.
-015
6.16 A.
-088
0.88 A.
-012
6.00 A.
-013
4.41 A.
-089
13.21 A.
15.49 A.
A CORR PER SURVEY
DALE HAYWOOD
-014
2.80 A.
-058
0.88 A.
A CORR PER SURVEY
DALE HAYWOOD
-023
5.32 A.
-027
28.23 A.
O.L. 39
O.L. 22
O.L. 38
O.L. 23
-072
34.13 A.
-096
30.50 A.
26.96 A.
A CORR PER SURVEY
DALE HAYWOOD
-067
49.67 A.
53.36 A.
A CORR PER SURVEY
DALE HAYWOOD
-025
67.14 A.
-095
3.63 A.
-015
4.49 A.
-002
4.09 A.
200.40
298.88
130.09
188.61
250.55
534.16
256.72
318.00
256.00
182.00
810.00
660.11
244.00
472.00
241.49
300.03
373.08
166.50
389.50
220.43
222.85
1539.15
385.44
190.25
514.74
61.18
1199.15
2422.38
413.82
338.23
161.37
192.08
189.35
195.82
211.31
214.60
728.01
146.56
185.66
203.71
183.31
114.72
79.52
118.21