R45TK

PARENT PARCEL: 05-00-041-105-040 , 05-00-041-106-001

CHILD PARCEL: 05-00-041-105-052 & -053, 05-00-041-106-011 & -012

STARTING POINT: MON. BOX, CL OF LEAVITT RD. & S.E. CORNER OF O.L. 41

06-02223

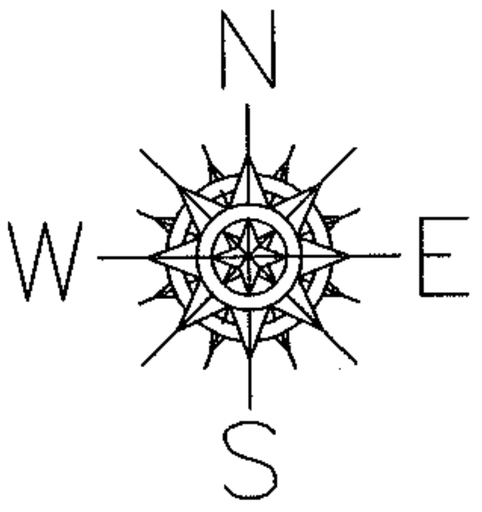

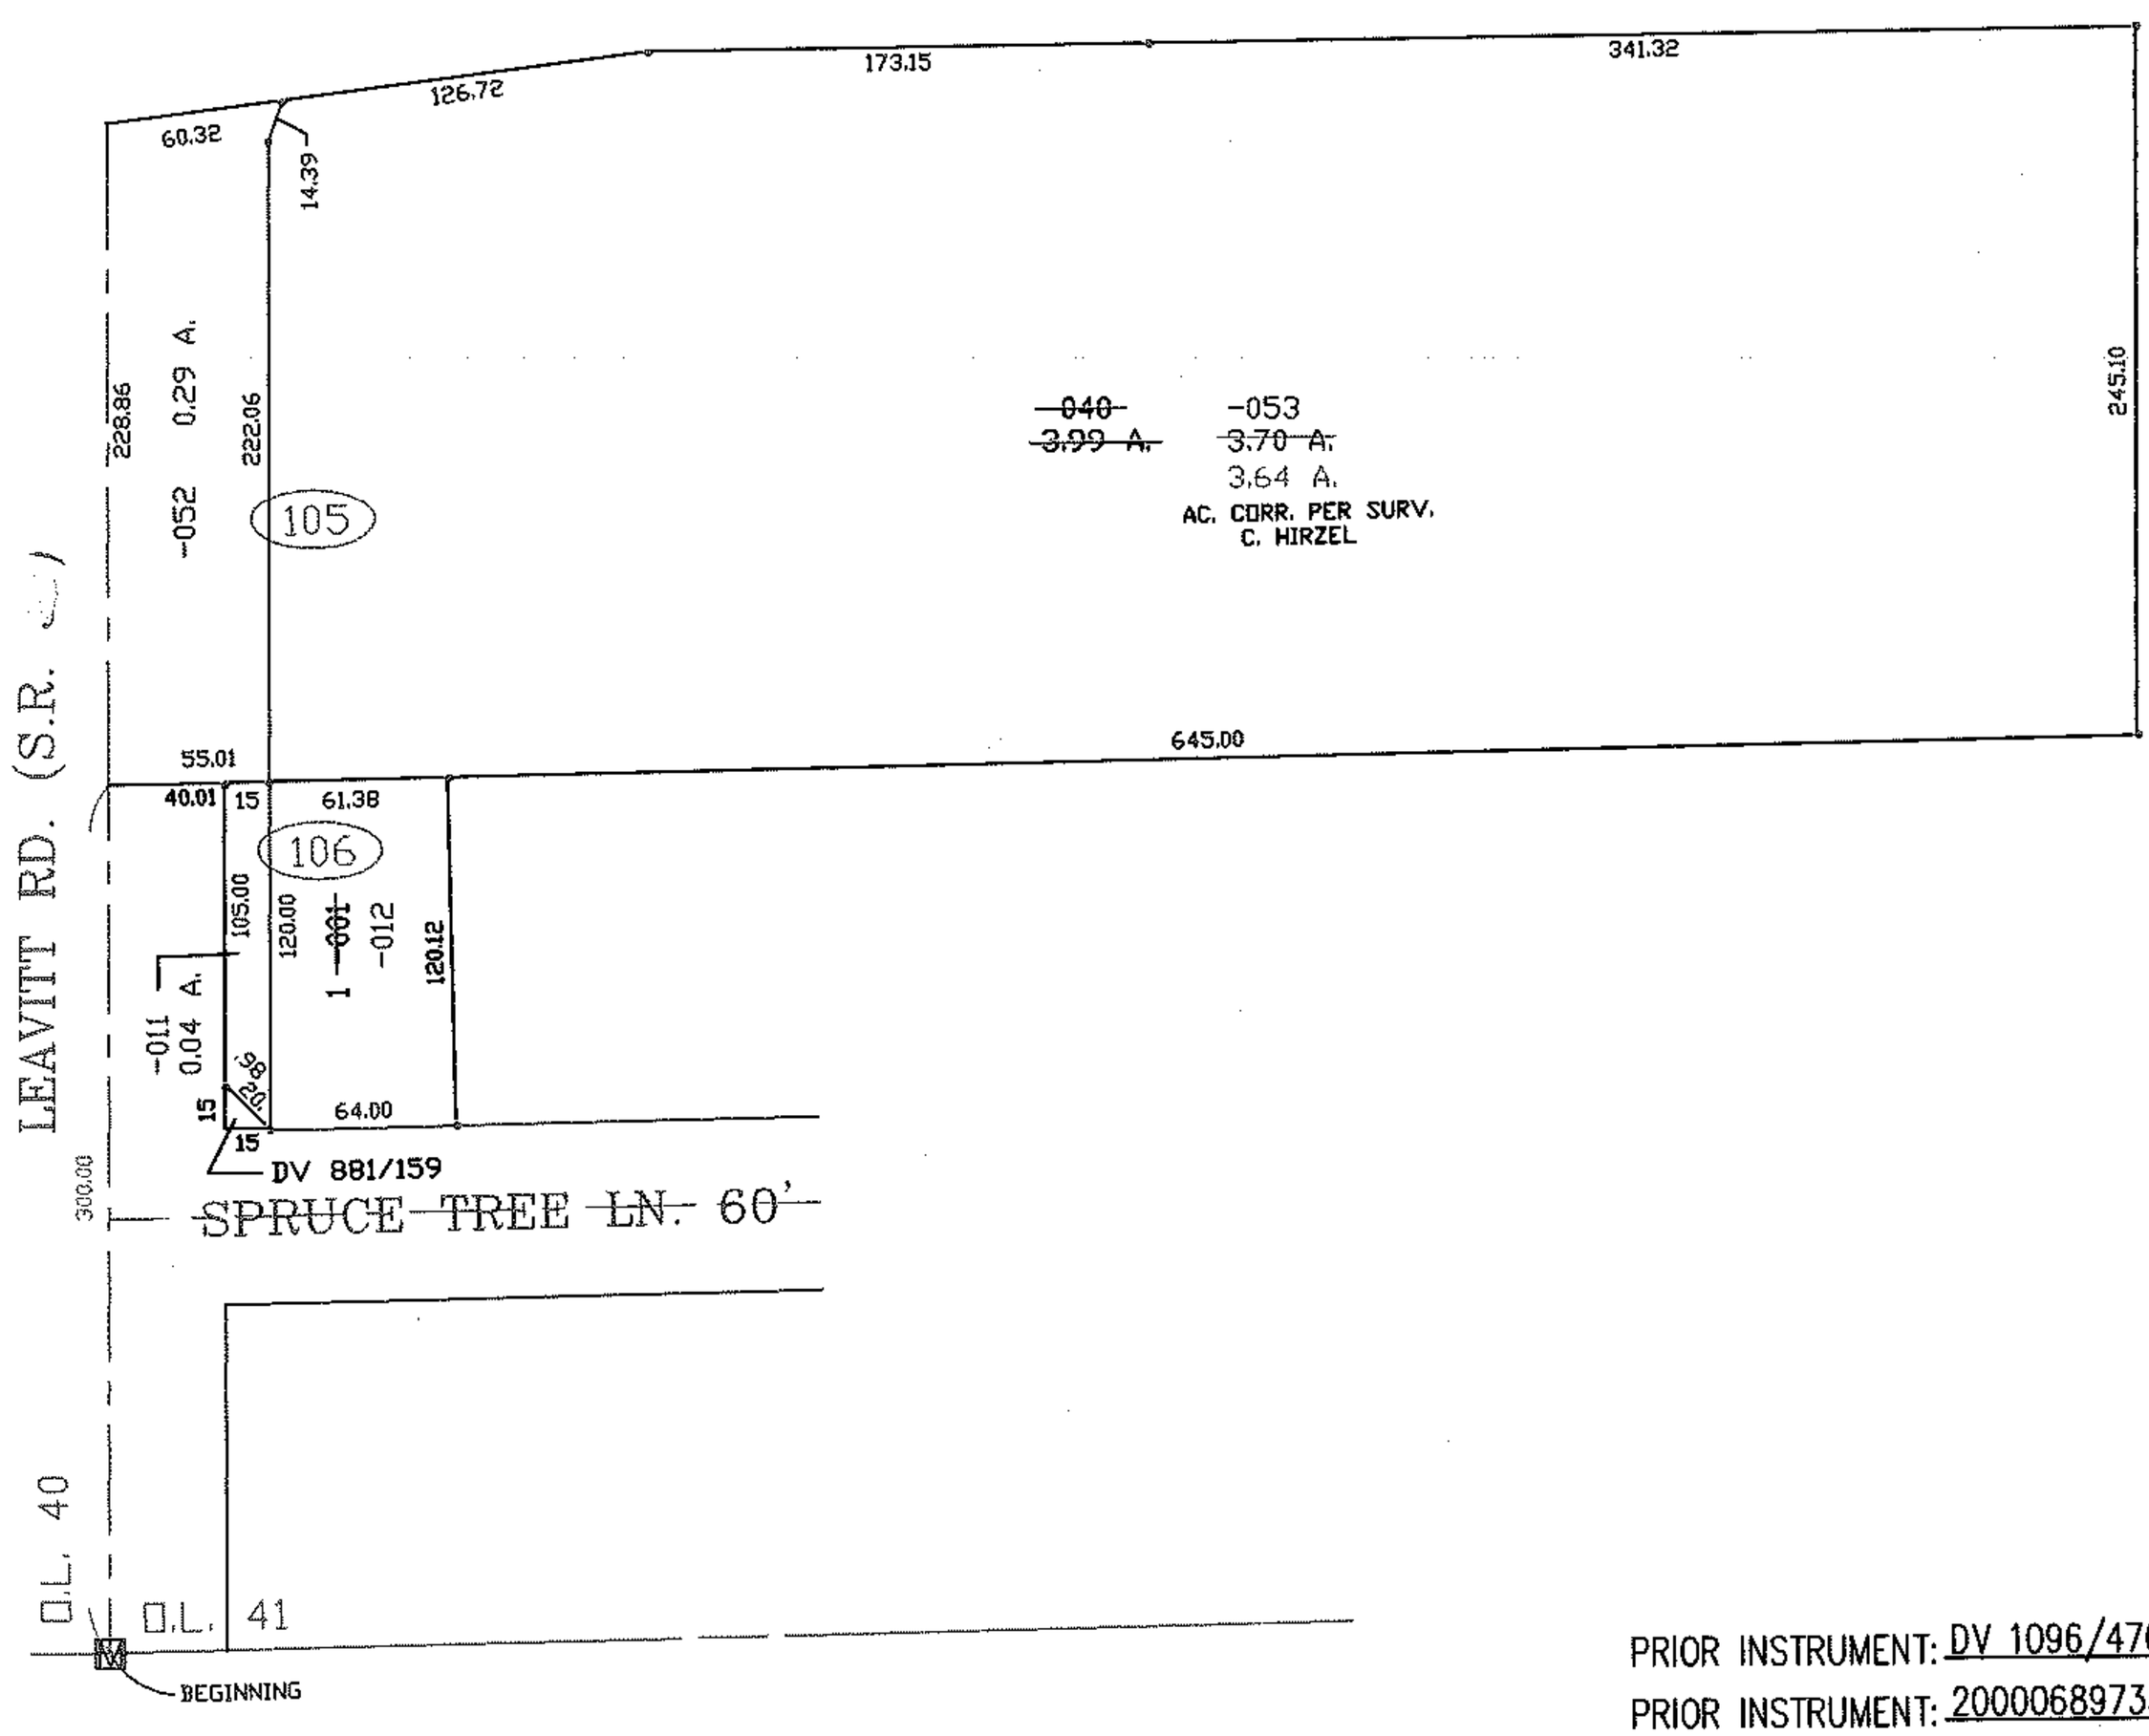

PRIOR INSTRUMENT: DV 1096/476

PRIOR INSTRUMENT: 20000689735

SPLITS/DEEDS PROCESSED

LORAIN COUNTY TAX MAP DEPARTMENT
226 MIDDLE AVE. ELYRIA, OHIO

SURVEYED BY: CHRISTOPHER M. HIRZEL

CLOSURE: 0.01 : 10,000

MAP PAGE(S): 5-00-041-A

APPROVED BY: TJS DATE: 2/7/11

SCALE: 1"= 100