RASTER

PARENT PARCEL: 03-00-110-105-025, -026, -030
CHILD PARCEL: 03-00-110-105-086 THRU -088
STARTING POINT: CENTERLINE OF NORTH RIDGE RD & PEARL AVE

06-02225

N
W E
S

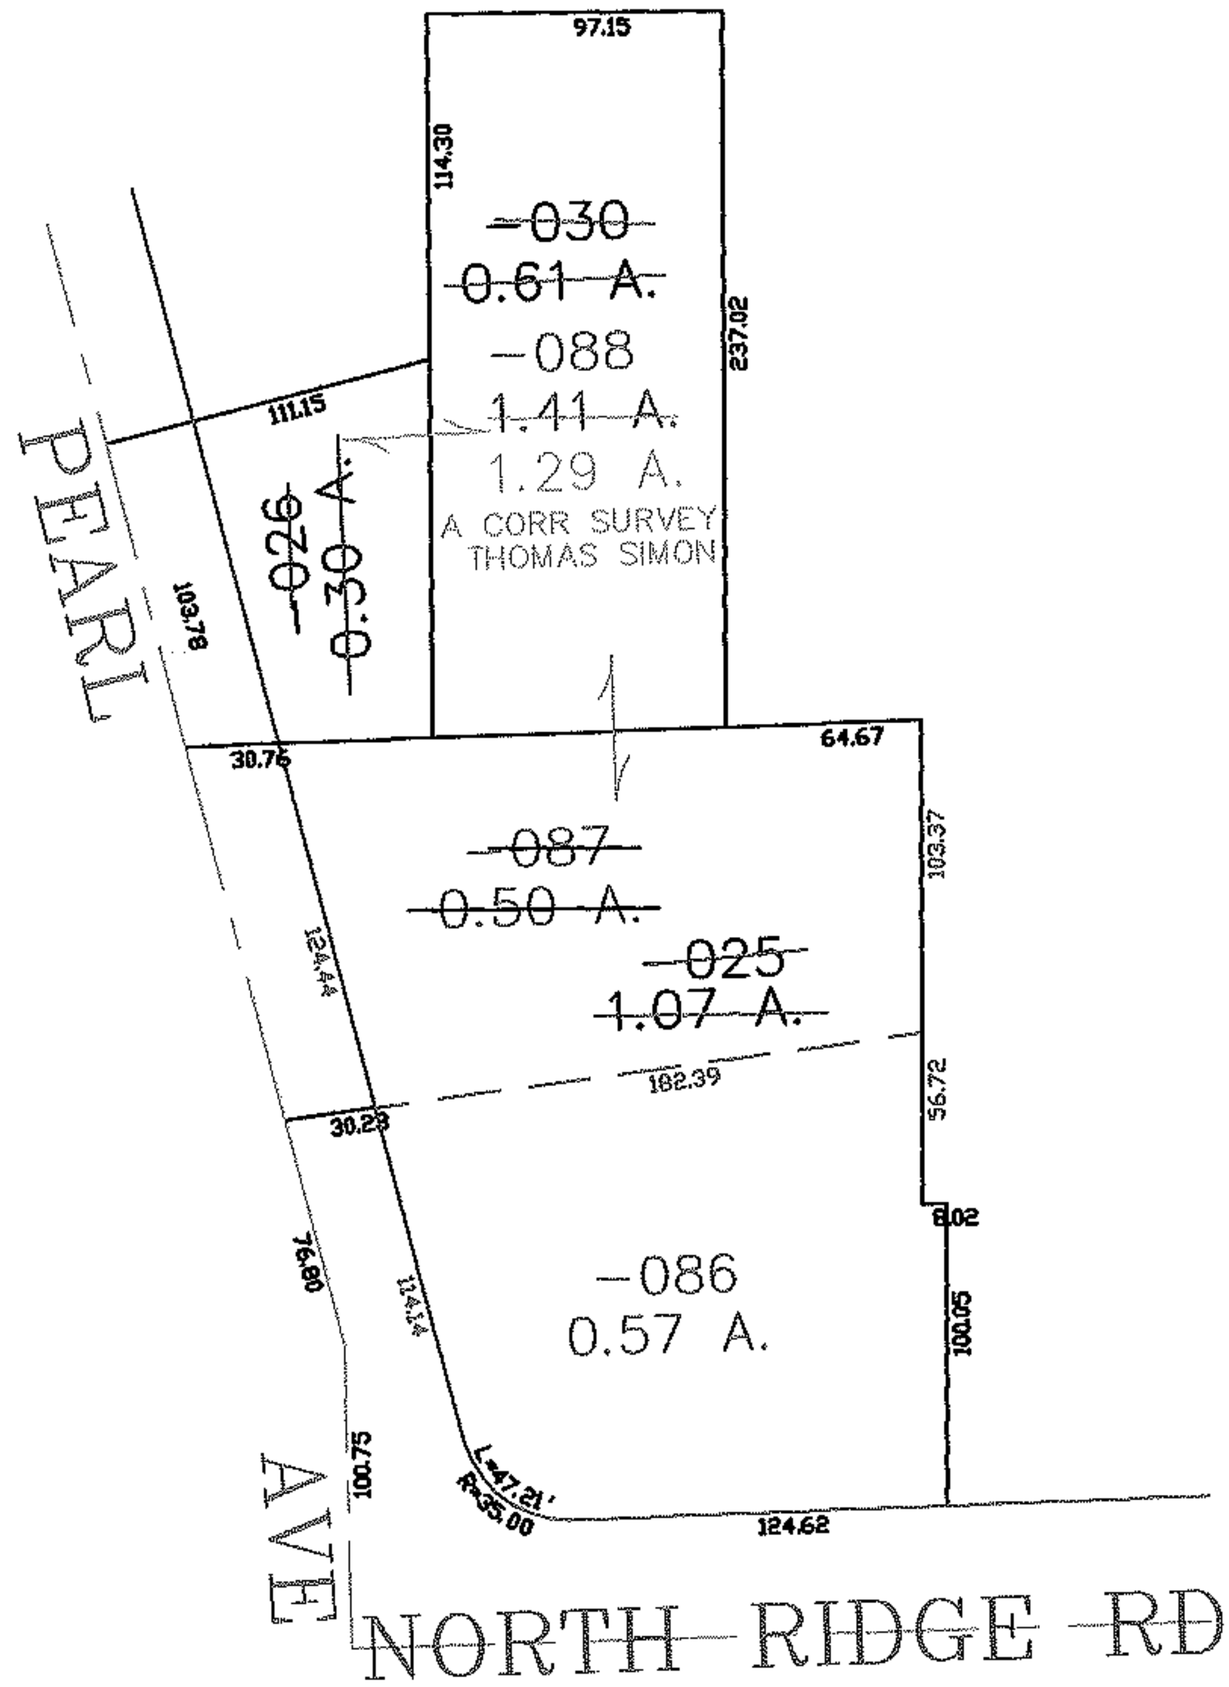

SPLITS/DEEDS PROCESSED

LORAIN COUNTY TAX MAP DEPARTMENT
226 MIDDLE AVE. ELYRIA, OHIO

SURVEYED BY: THOMAS SIMON
CLOSURE: 0.00 : 10,000
MAP PAGE(S): 03-00-110-A
APPROVED BY: JAH DATE: 9-19-06
SCALE: 1"= 100 PRIOR INSTRUMENT: 19990626173