DC-02248

SCALE
1"=150"

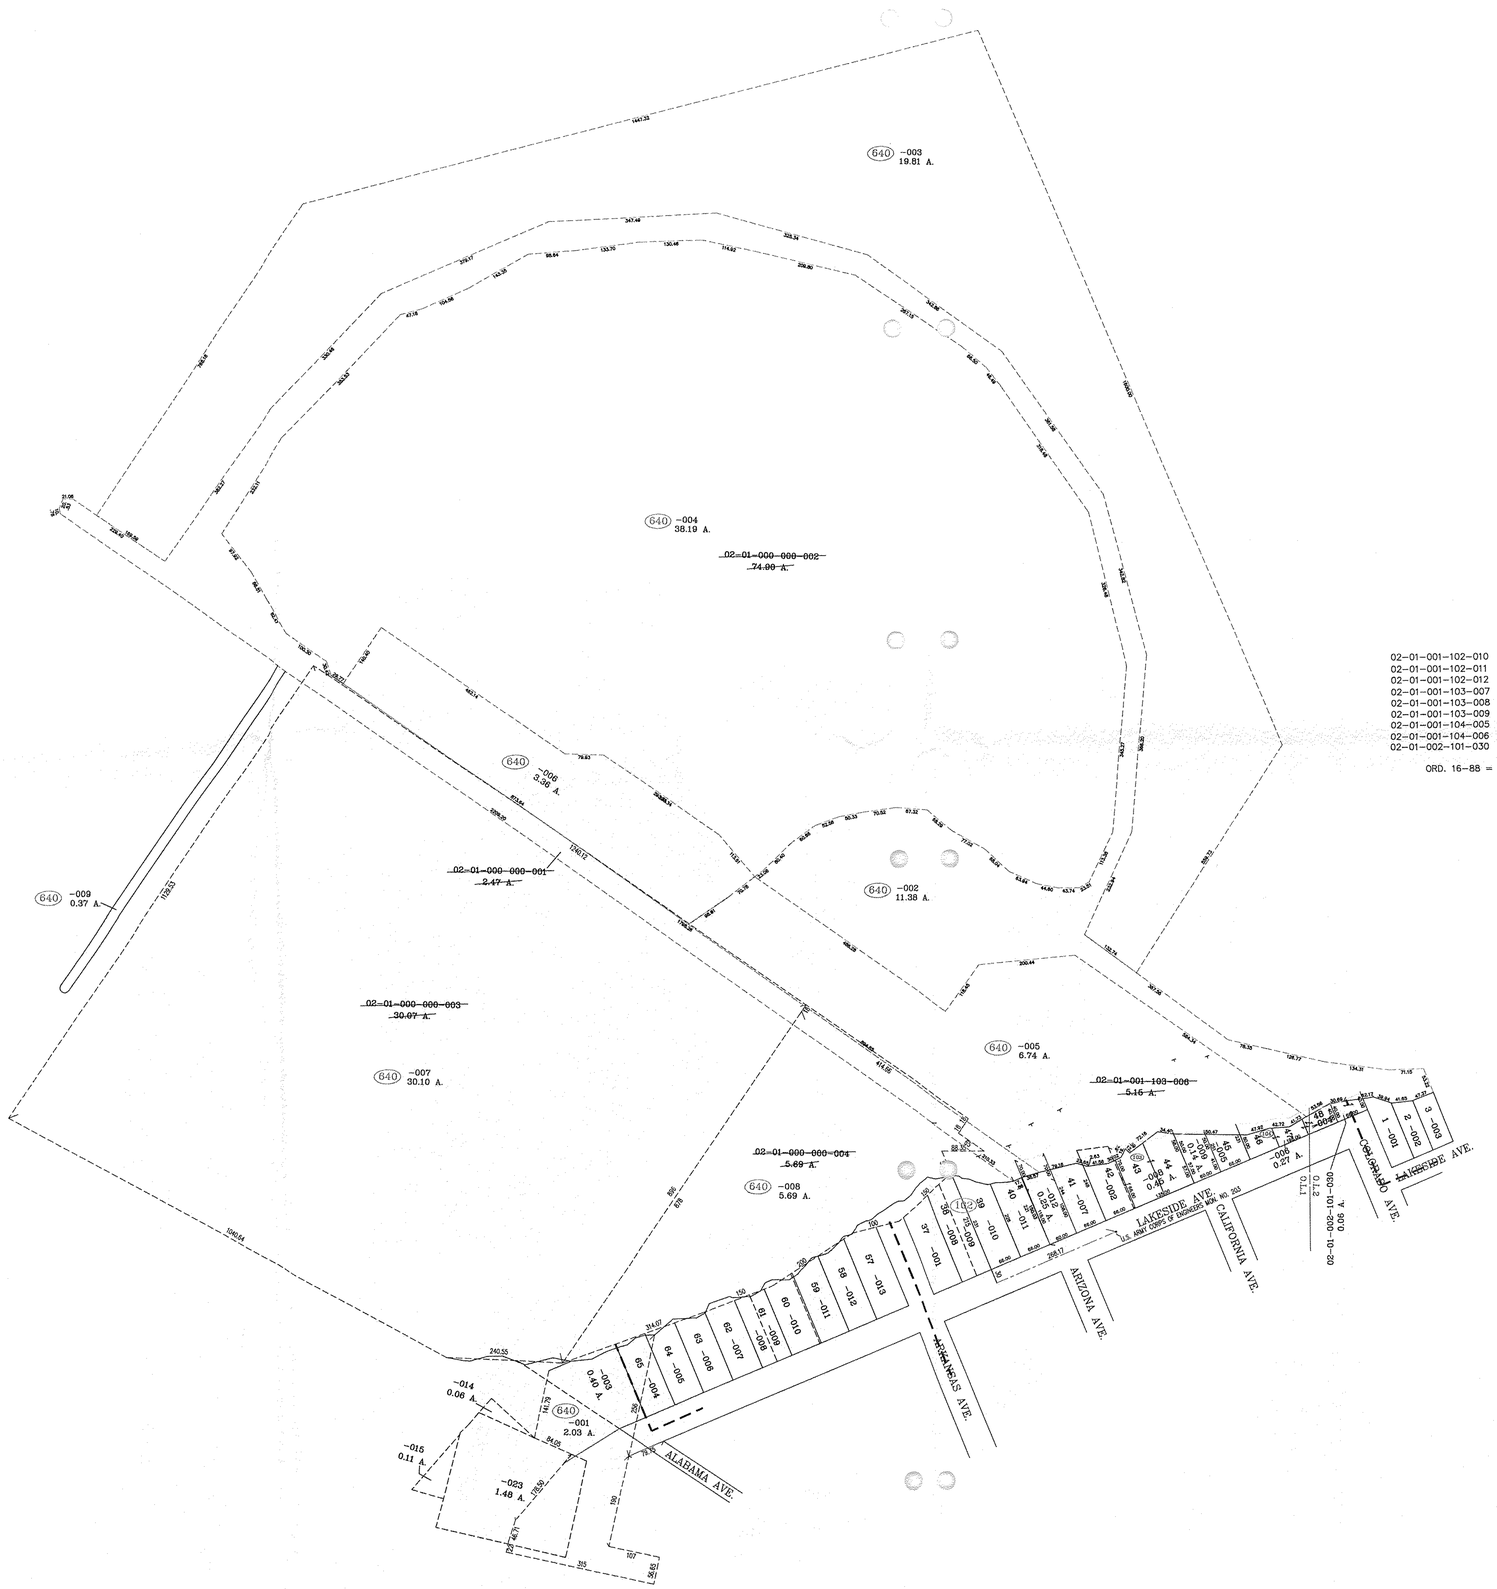


| | |
|---|---|
| 02-01-001-102-010 | DV 1345/807 |
| 02-01-001-102-011 | ORD. 16-88 |
| 02-01-001-102-012 | ORD. 79-76 |
| 02-01-001-103-007 | ORD. 16-88 |
| 02-01-001-103-008 | OR 57/660 |
| 02-01-001-103-009 | ORD. 79-76 |
| 02-01-001-104-005 | ORD. 16-88 |
| 02-01-001-104-006 | ORD. 79-76 |
| 02-01-002-101-030 | ORD. 79-76 |

ORD. 16-88 = 20100326335