PARENT PARCEL: 07-00-001-000-304

CHILD PARCEL: 07-00-001-000-305, -306

STARTING POINT: CENTERLINE OF ROOT RD & SPRAGUE RD

06-02251

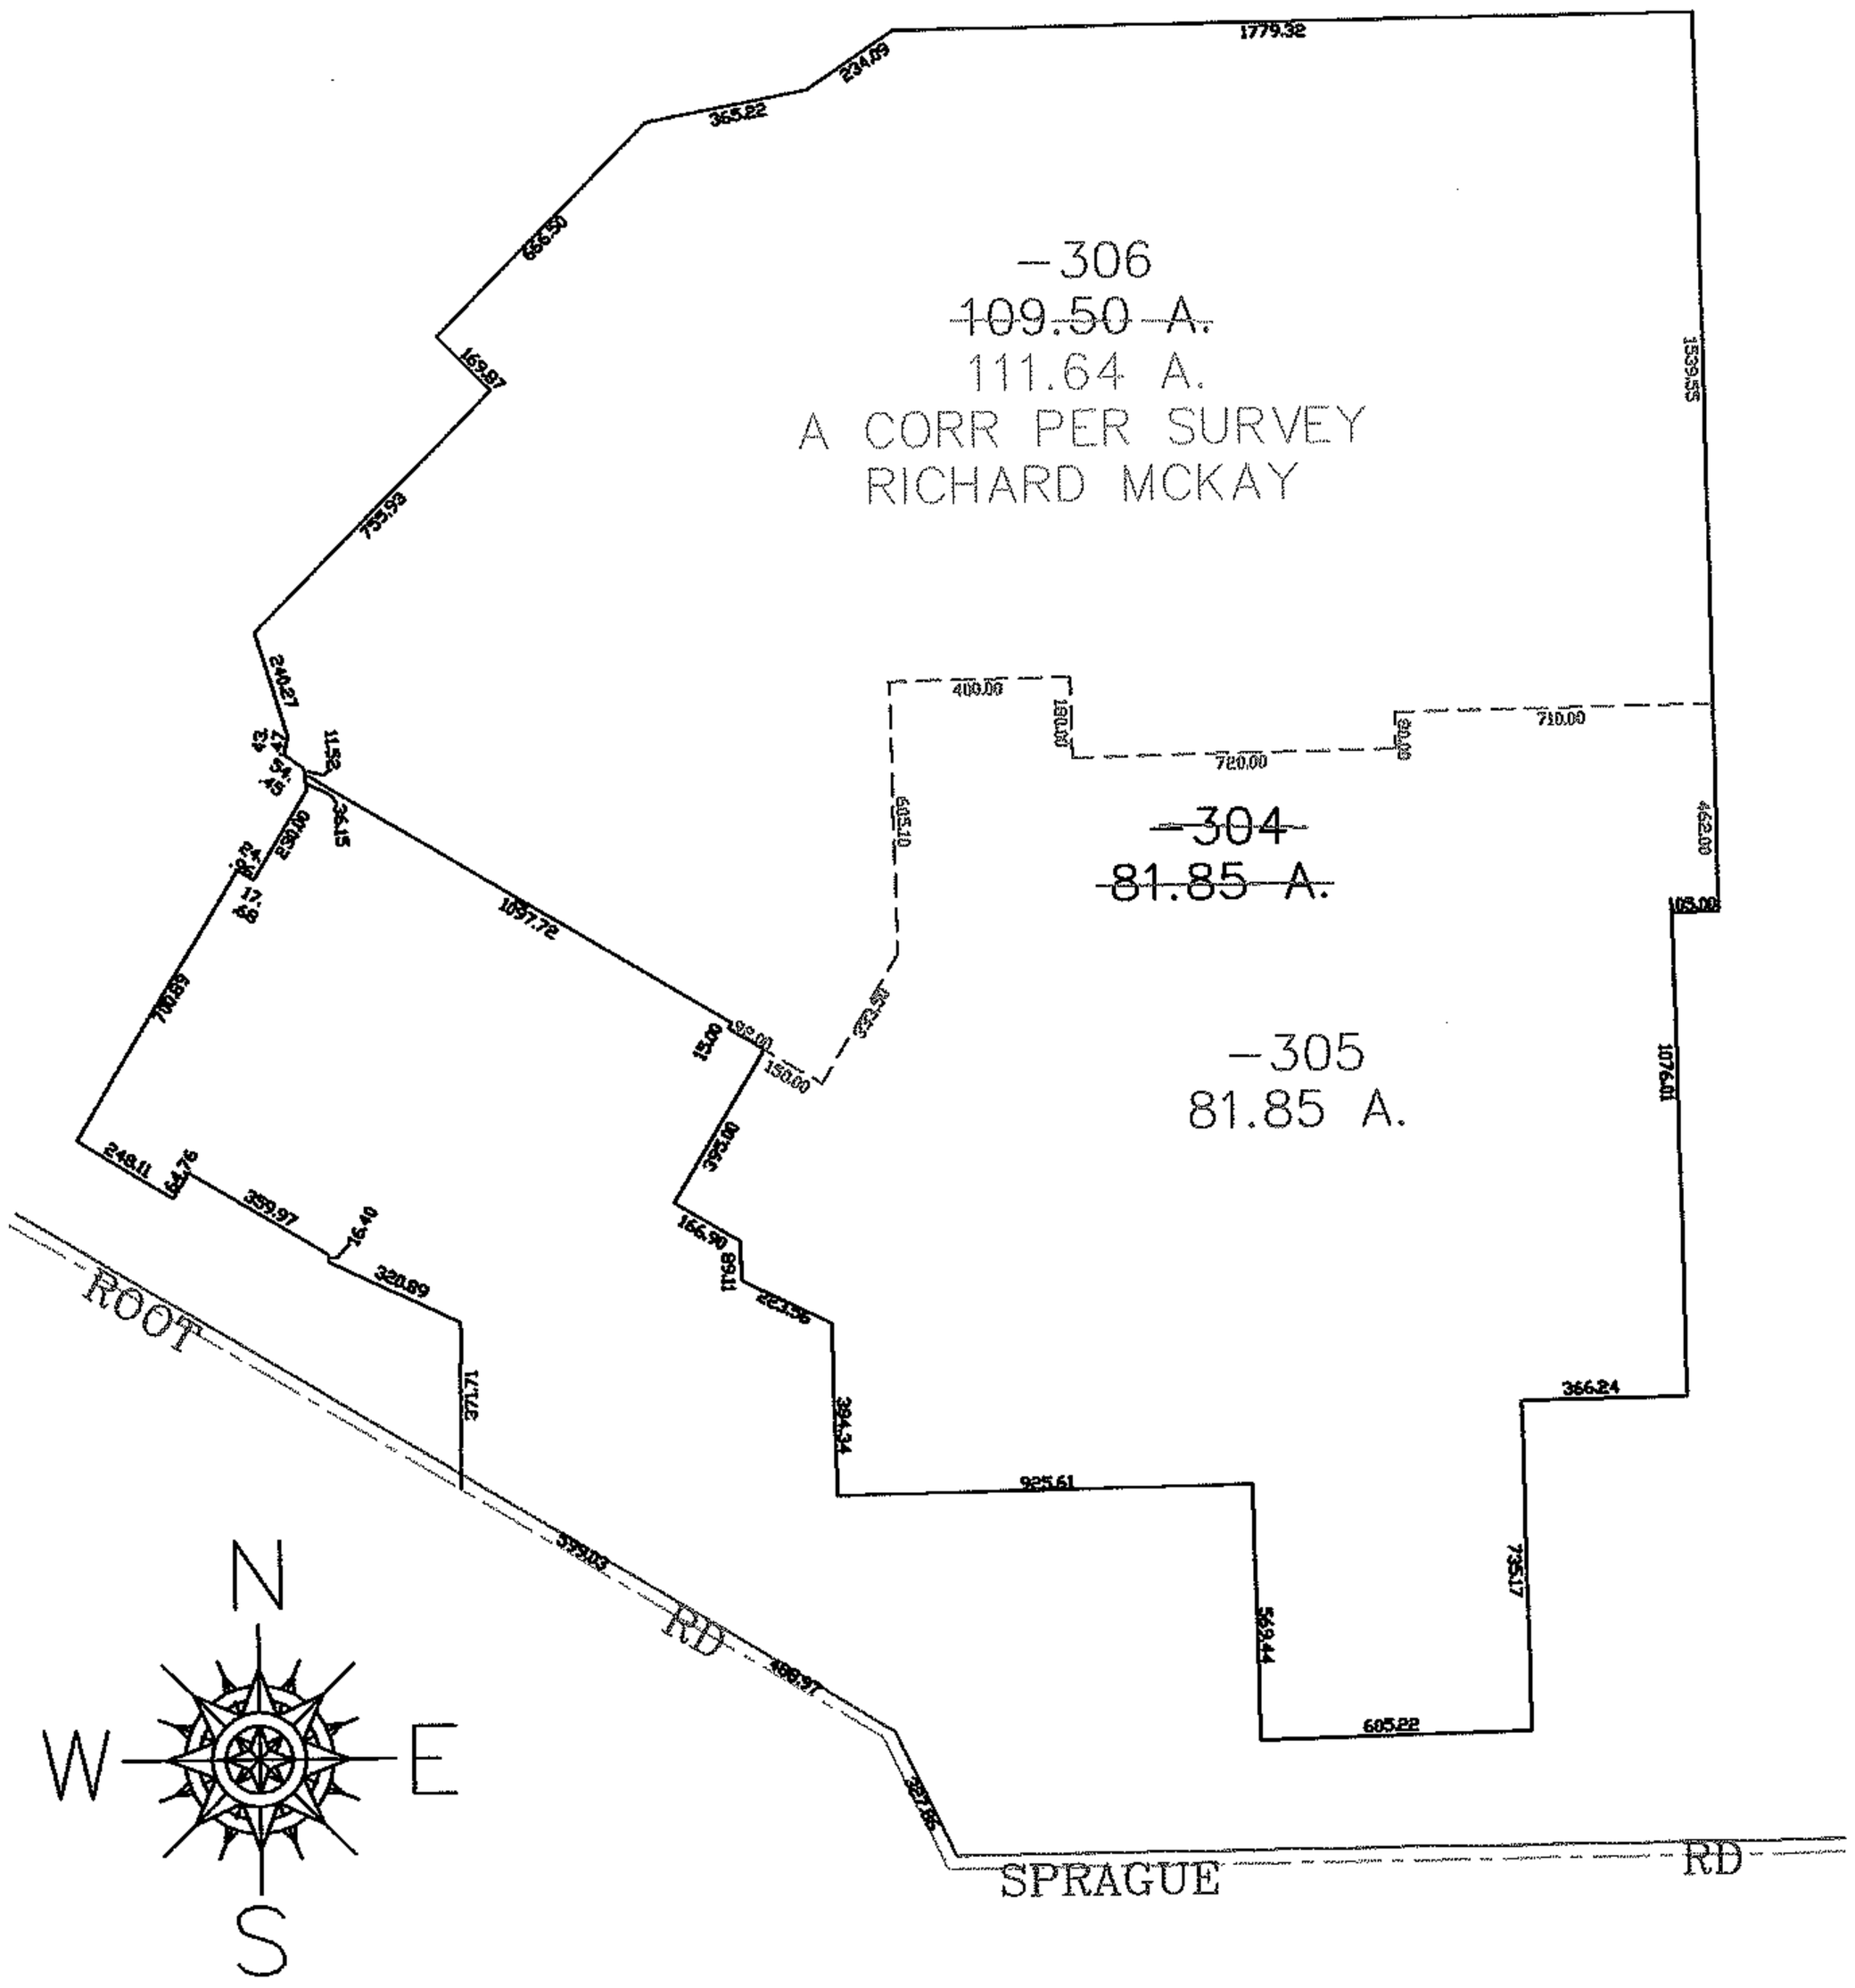

SPLITS/DEEDS PROCESSED

LORAIN COUNTY TAX MAP DEPARTMENT
226 MIDDLE AVE. ELYRIA, OHIO

SURVEYED BY: RICHARD MCKAY

CLOSURE: 0.01 : 10.000

MAP PAGE(S): 07-00-001-A

APPROVED BY: JAH DATE: 10-26-06

SCALE: 1"= 600 PRIOR INSTRUMENT: OR 90/75