PARENT PARCEL: 01-00-065-000-020, -004

CHILD PARCEL: 01-00-065-000-025 THRU -028

STARTING POINT: CENTERLINE OF SPERRY RD & O.L. 65

06-02252

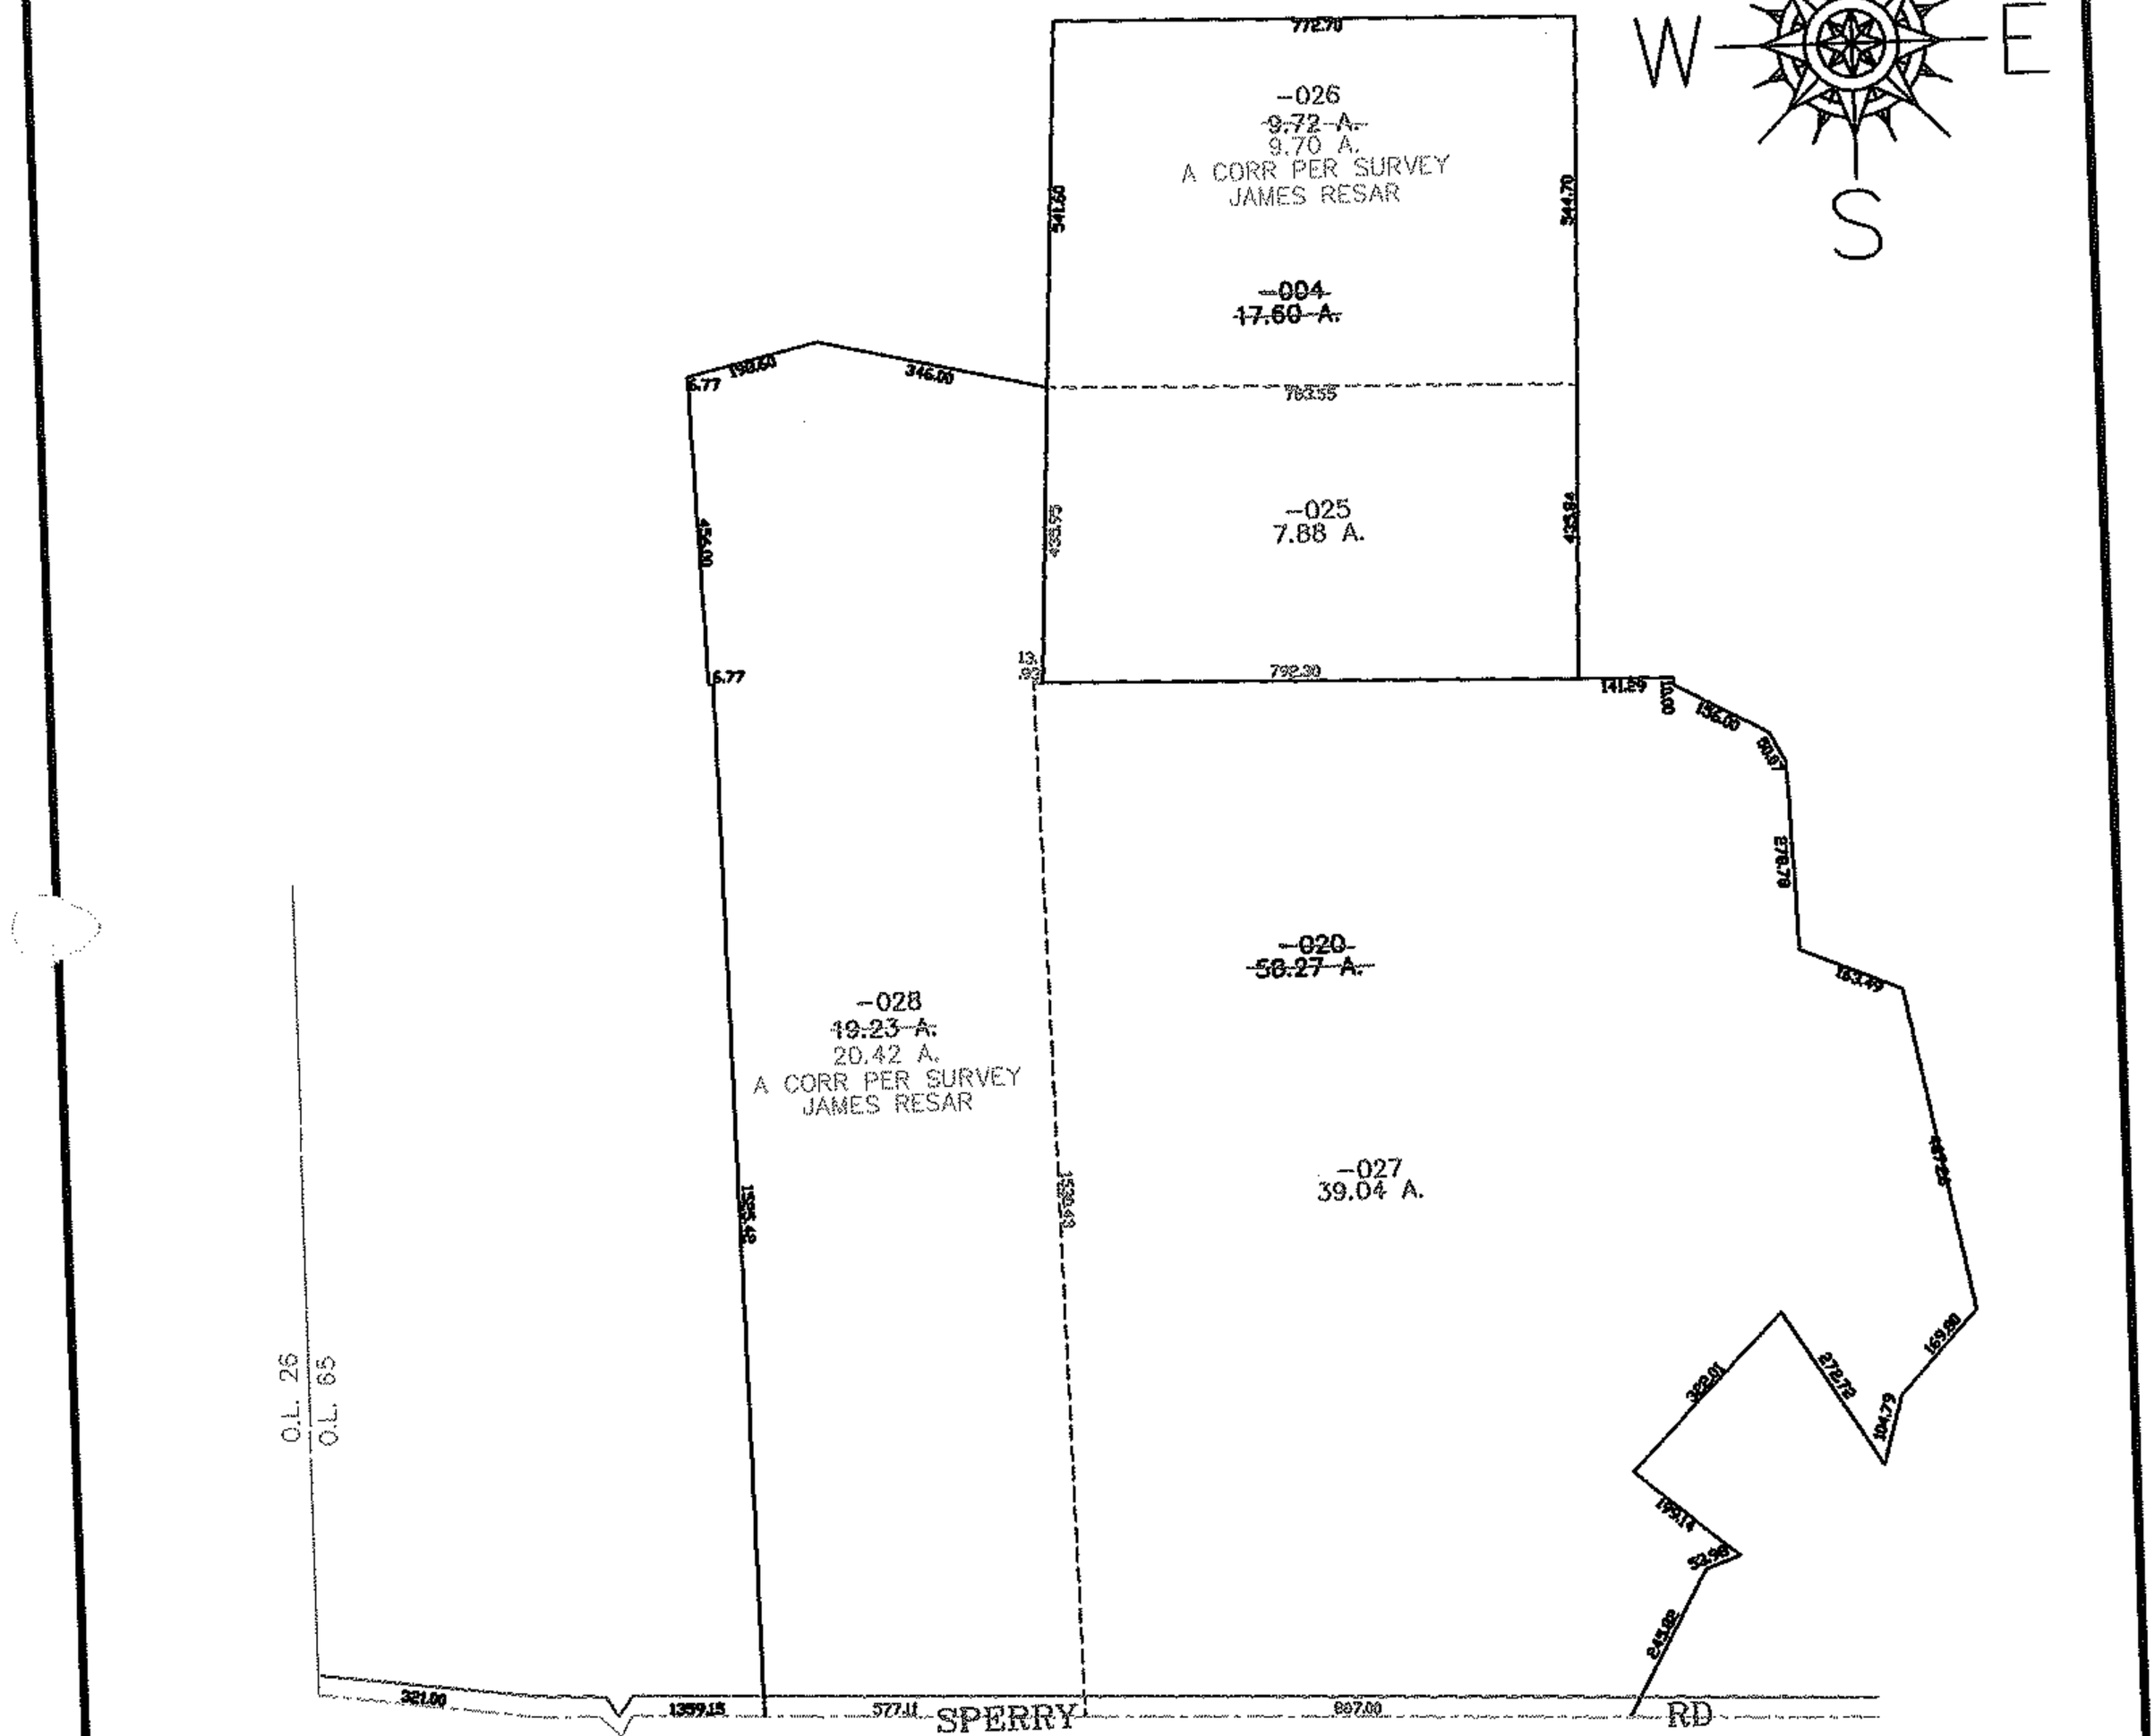

SPLITS/DEEDS PROCESSED

LORAIN COUNTY TAX MAP DEPARTMENT
226 MIDDLE AVE. ELYRIA, OHIO

SURVEYED BY: JAMES RESAR

CLOSURE: 0.00 : 10,000

MAP PAGE(S): 01-00-065-B

APPROVED BY: JAH DATE: 10-31-06

SCALE: 1"= 400 PRIOR INSTRUMENT: 20050108716