RASTER

PARENT PARCEL: 12-00-057-000-053, -054

CHILD PARCEL: 12-00-057-000-074

TARTING POINT: CENTERLINE OF FOLLEY RD & O.L. 57

06-02254

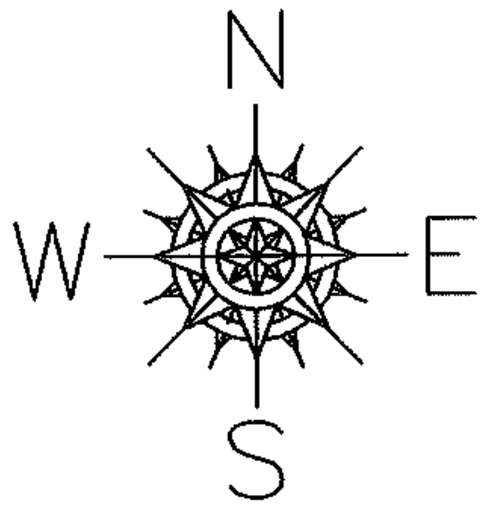

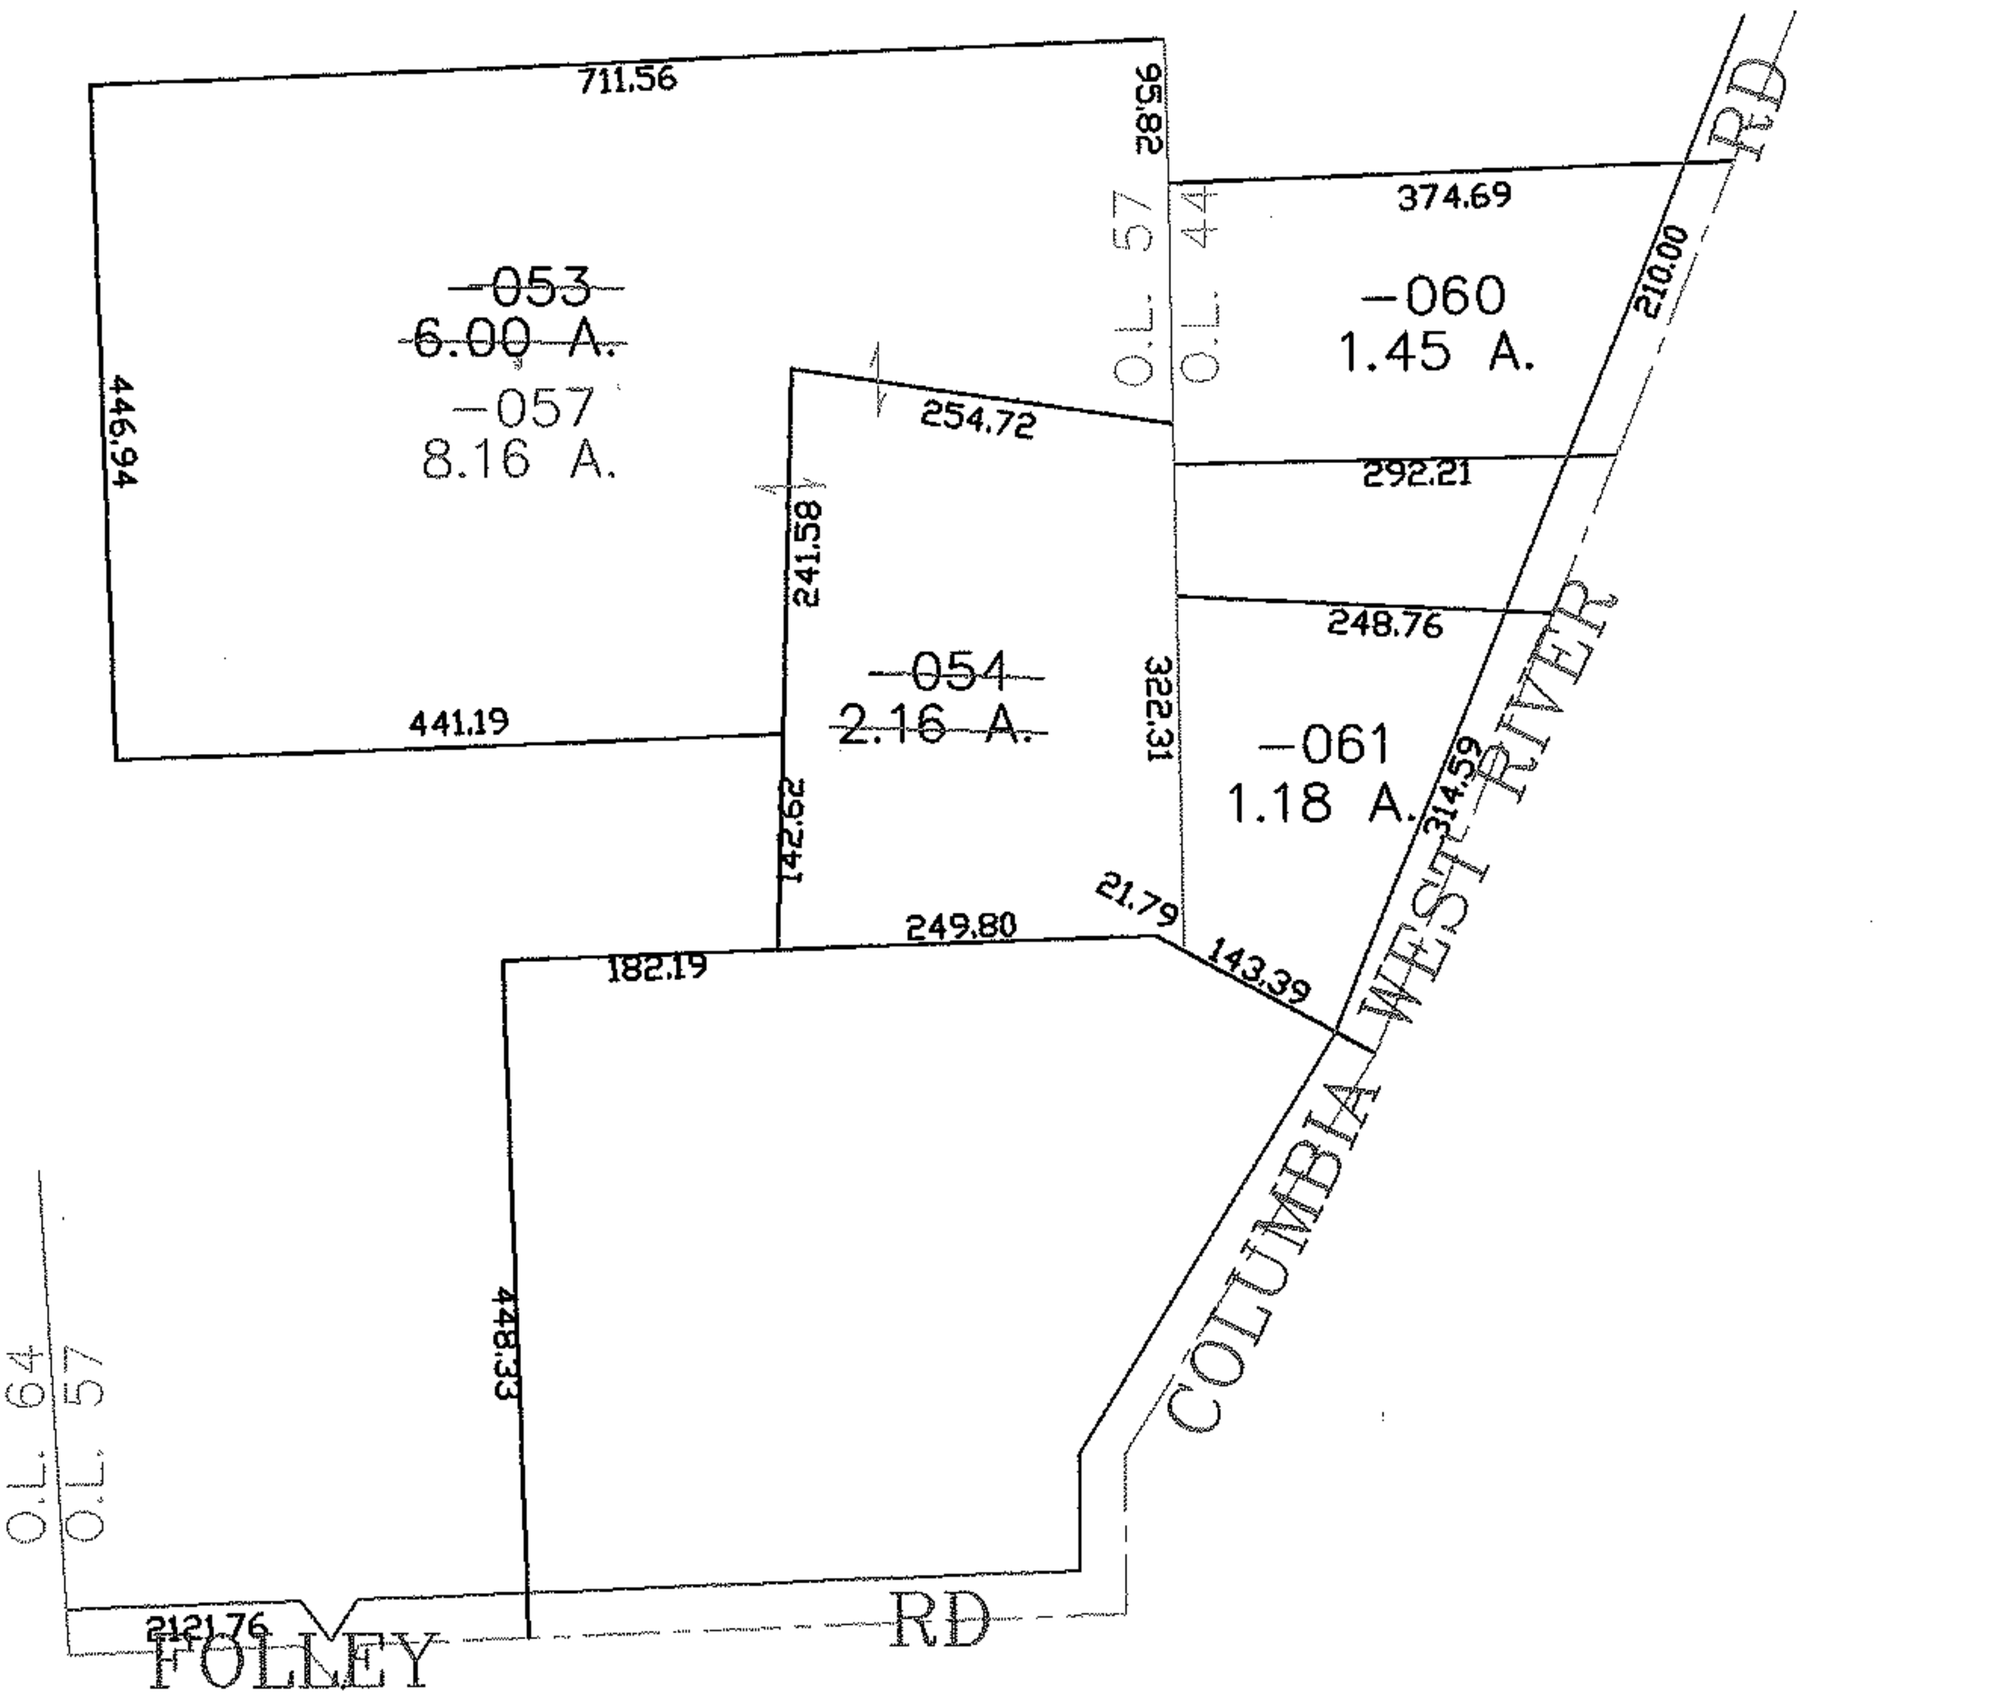

SPLITS/DEEDS PROCESSED

LORAIN COUNTY TAX MAP DEPARTMENT
226 MIDDLE AVE. ELYRIA, OHIO

SURVEYED BY: DALE HAYWOOD

CLOSURE: 0.00 : 10,000

MAP PAGE(S): 12-00-044-A

APPROVED BY: JAH DATE: 10-23-06

SCALE: 1"= 200 PRIOR INSTRUMENT: 20020845520