PARENT PARCEL: 06-26-056-001, -002, & -018

CHILD PARCEL: XX-XX-XXX-XXX-XXX

STARTING POINT: XXXXXX

11-02262-C

FRONTAGE & DEPTH CORR.
UPDATE LEGAL

06-26-056-000-001
~~37.96 X ?~~
37 X 95.16
DV 1040/804 & OR 162/856
ADD EXCEPTION FOR
8" STRIP
PARCEL #2 DV 1040/804

FRONTAGE & DEPTH CORR.
UPDATE LEGAL

06-26-056-000-002
~~48.94 X 95~~
48.94 X 95.83
INST. #20020874082
UPDATE TO PRIOR DEED
DV 274/98

N
W E
S

ADD TO DUPLICATE

06-26-056-000-018
0.83 X 82
PER DV 89/308
NEVER DEEDED OUT

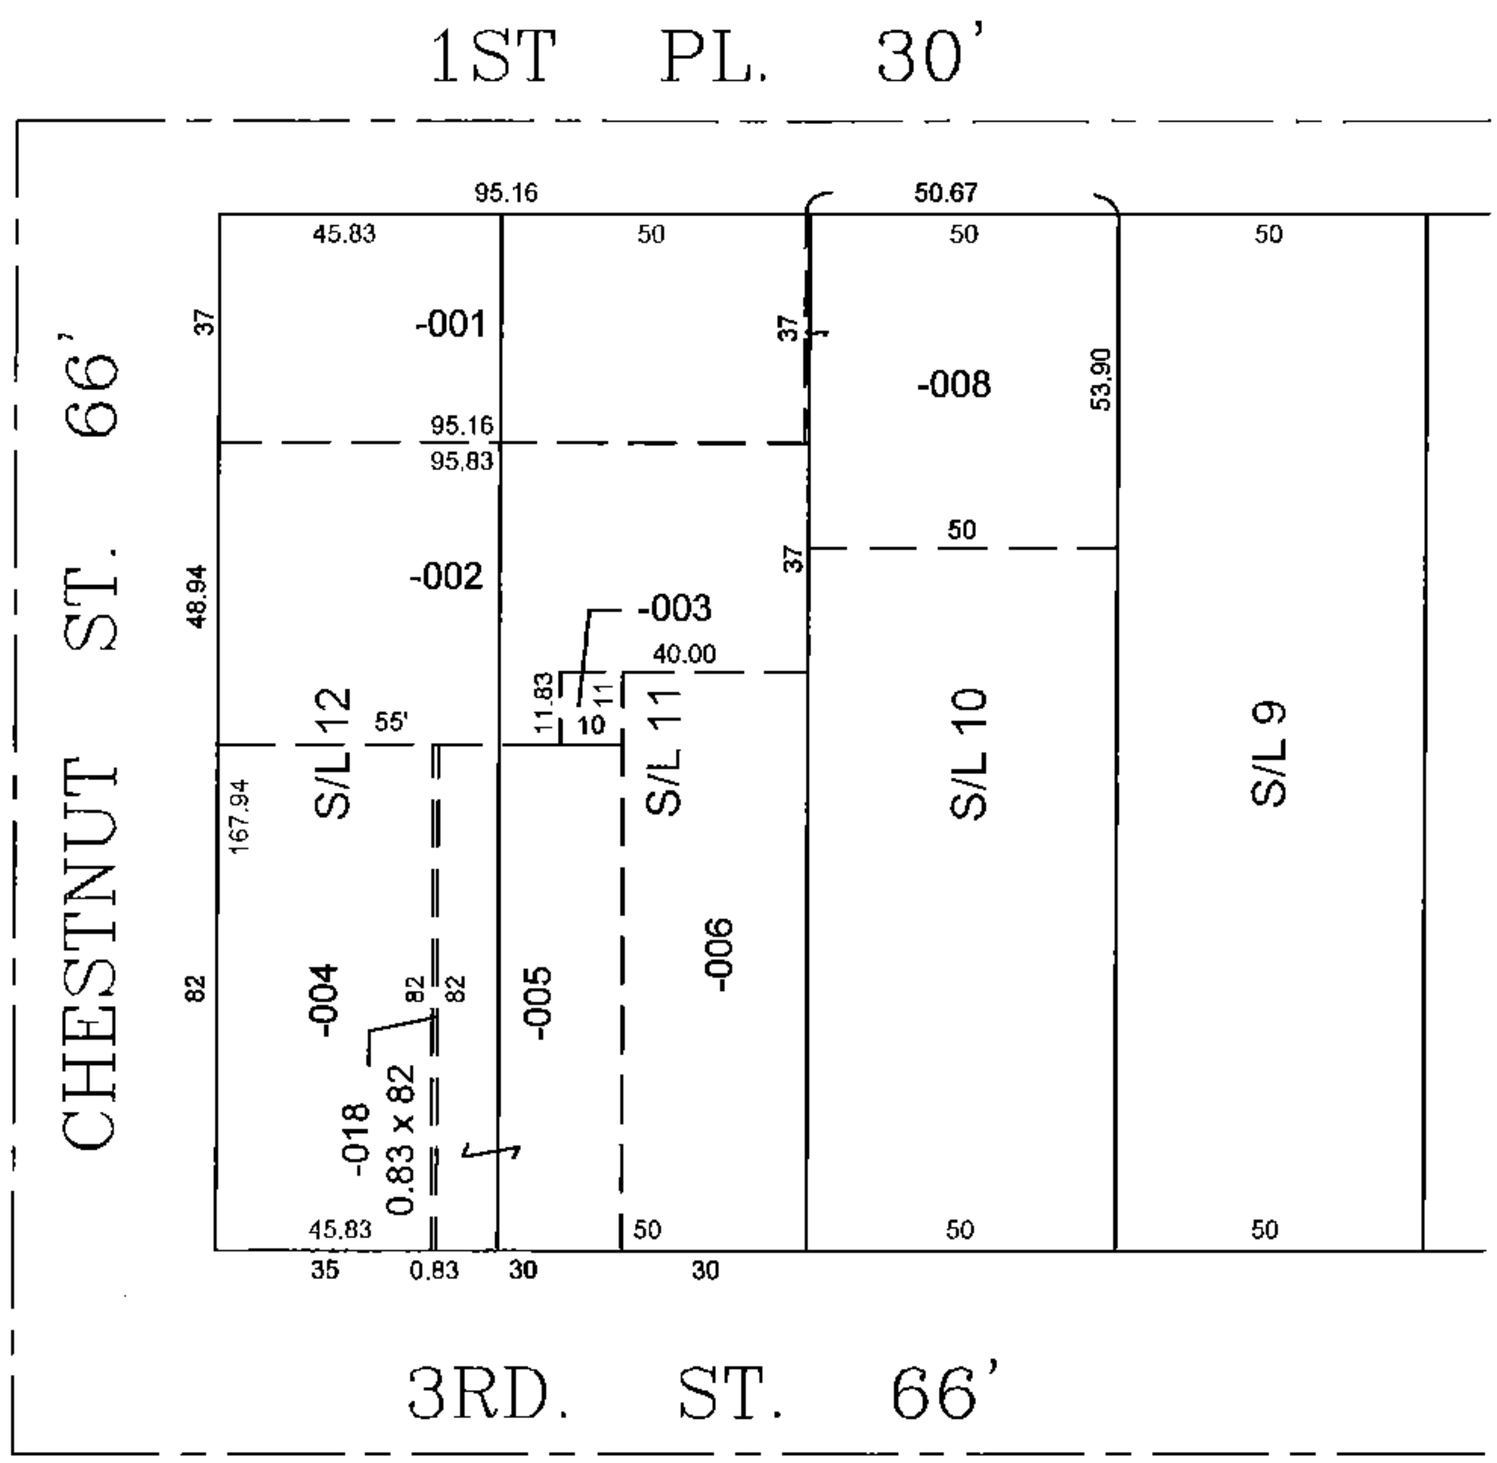

SPLITS/DEEDS PROCESSED

LORAIN COUNTY TAX MAP DEPARTMENT
226 MIDDLE AVE. ELYRIA, OHIO

SURVEYED BY: NONE

CLOSURE: NONE

MAP PAGE(S): 6-119

APPROVED BY: TJS DATE: 3/15/11

SCALE: 1"= 50' PRIOR INST.: DV XXXX/XXX