RASTER

PARENT PARCEL: 06-24-039-000-053, -068, -039

CHILD PARCEL: 06-24-039-000-076 THRU -078

STARTING POINT: CENTERLINE OF GRISWOLD RD & LAKE AVE

06-02263

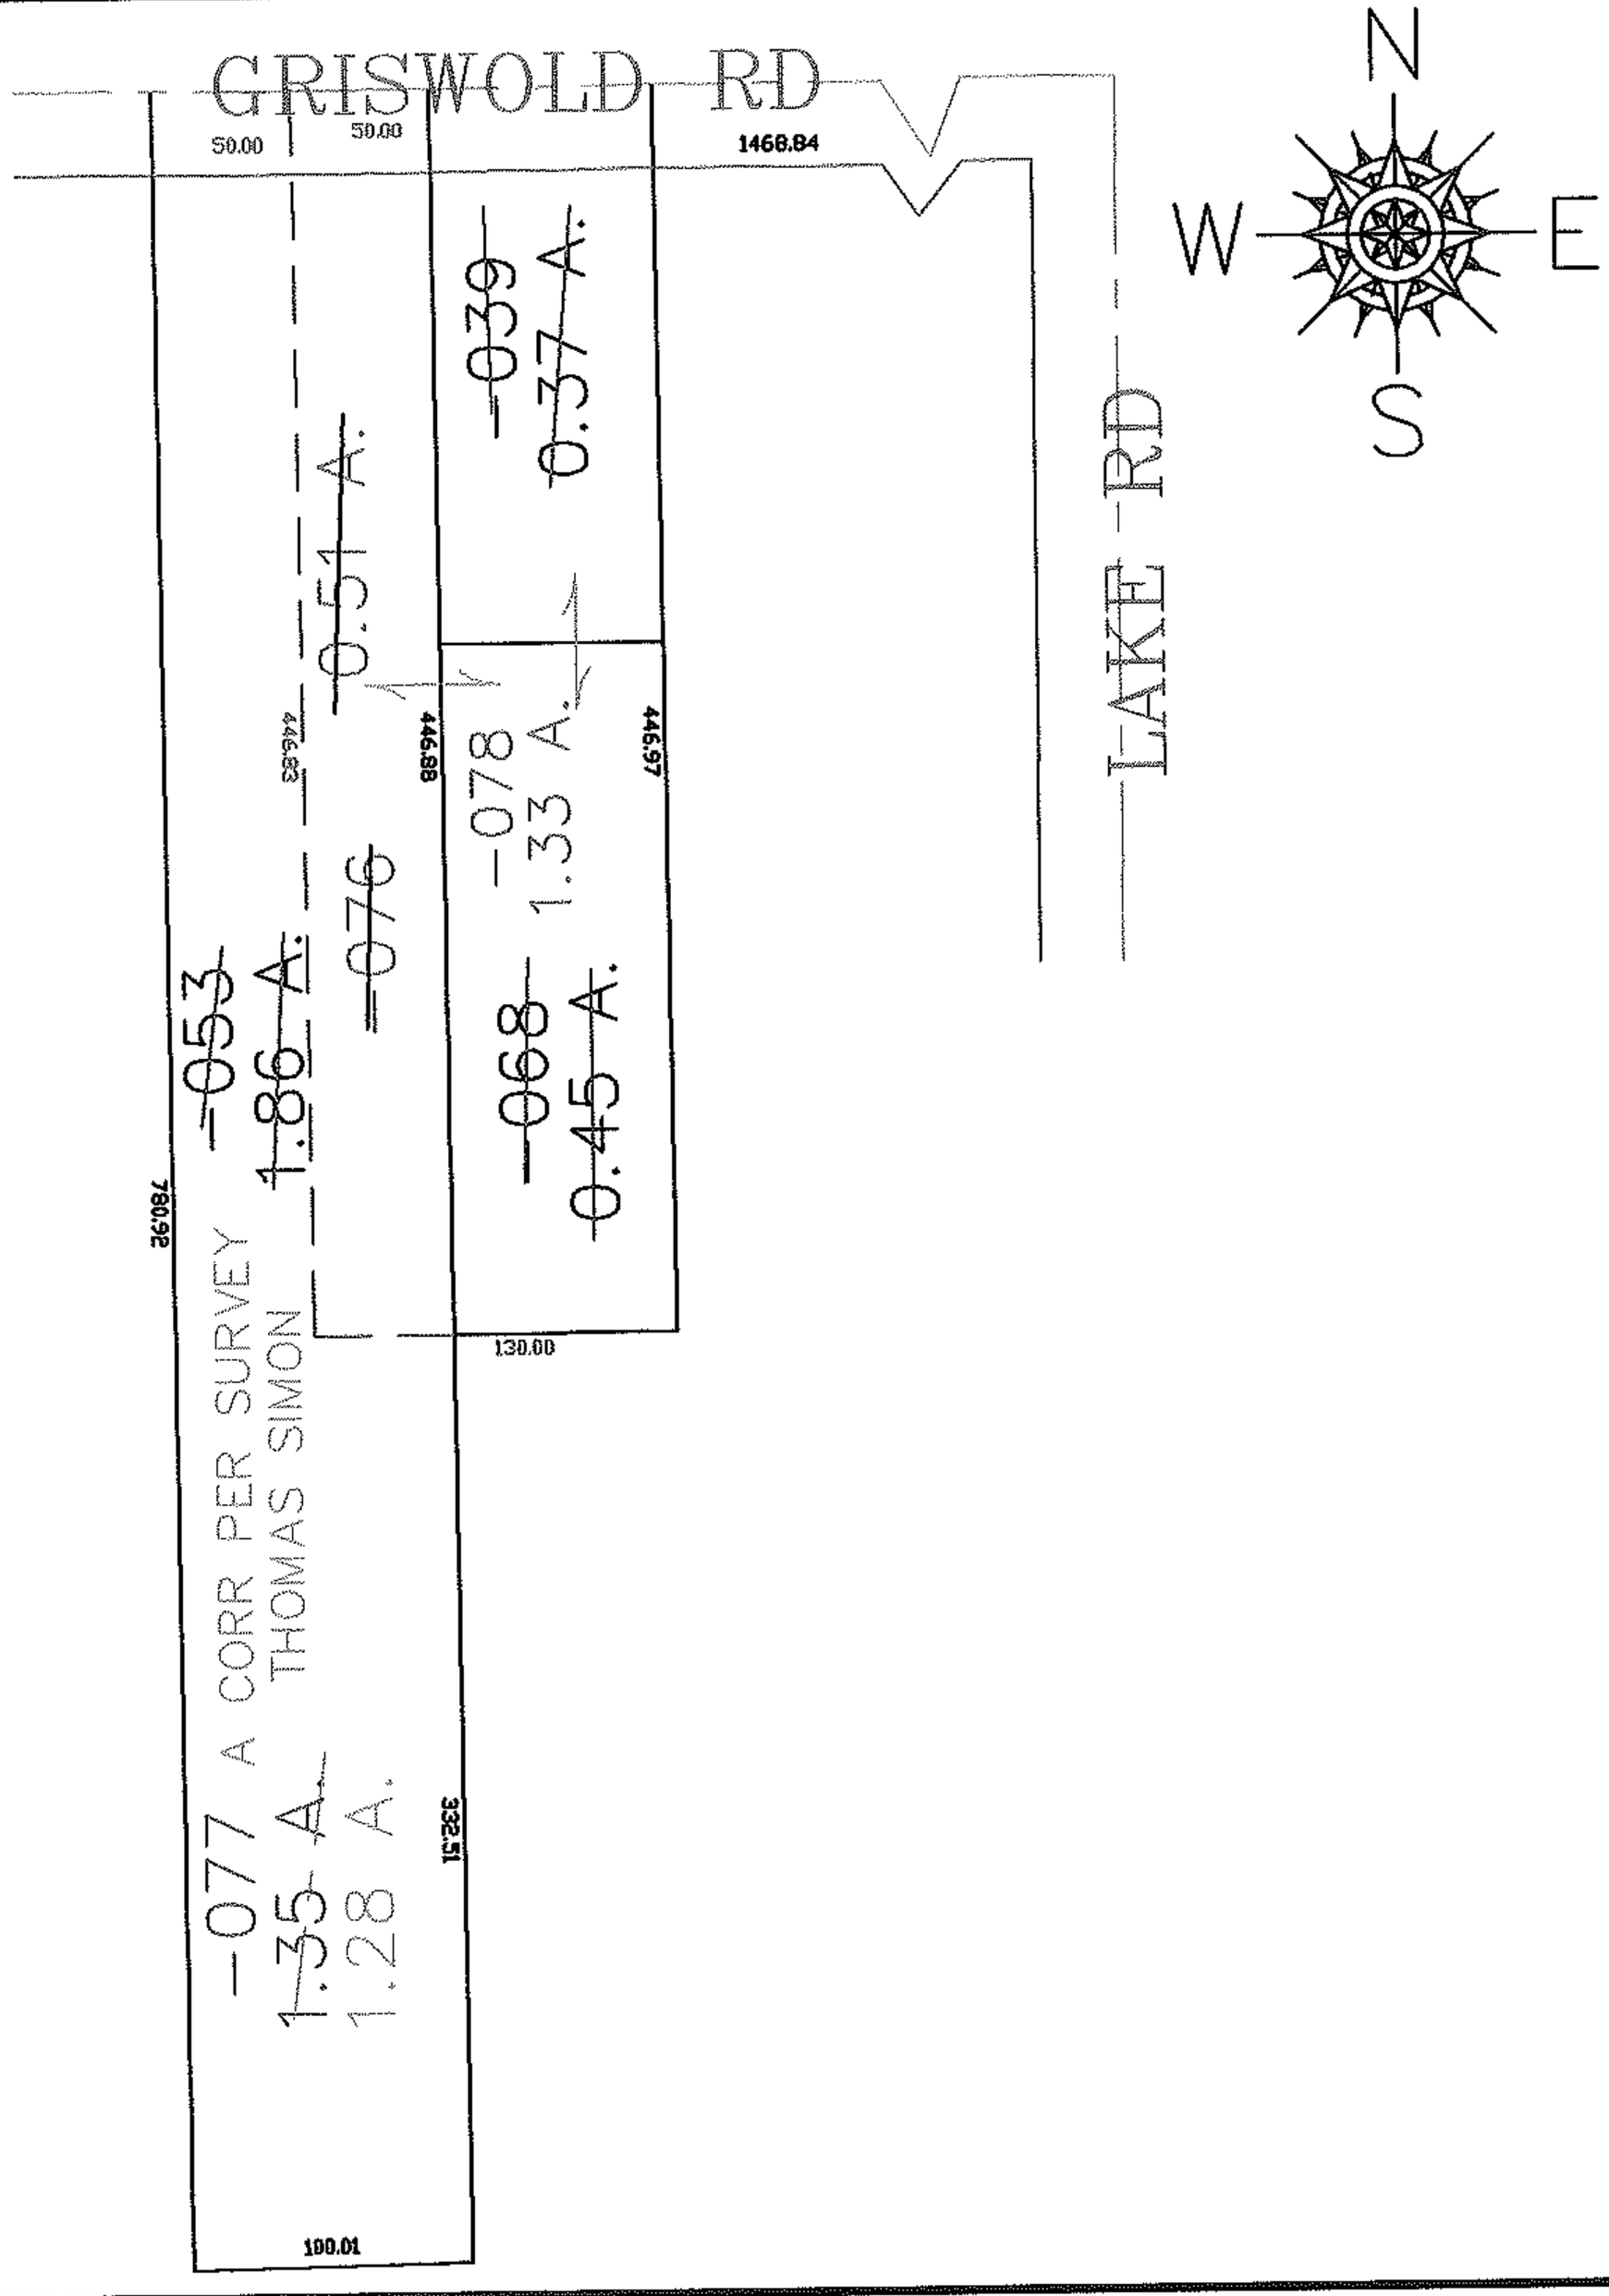

SPLITS/DEEDS PROCESSED

LORAIN COUNTY TAX MAP DEPARTMENT
226 MIDDLE AVE. ELYRIA, OHIO

SURVEYED BY: THOMAS SIMON

CLOSURE: 0.00 : 10.000

MAP PAGE(S): 6-41

APPROVED BY: JAH DATE: 11-9-06

SCALE: 1"= 100 PRIOR INSTRUMENT: DV 1020/455