RASTER

PARENT PARCEL: 05-00-023-118-008

CHILD PARCEL: XX-XX-XXX-XXX-XXX

RTING POINT: 327.85 FEET NORTH OF THE S.W. CORNER OF S/L 84

11-02286-C

N
W E
S

DEPTH CORRECTION

05-00-023-118-008

~~60 X 130~~

60 X 130.02

CORR. PER DEED

INST. #20050112204

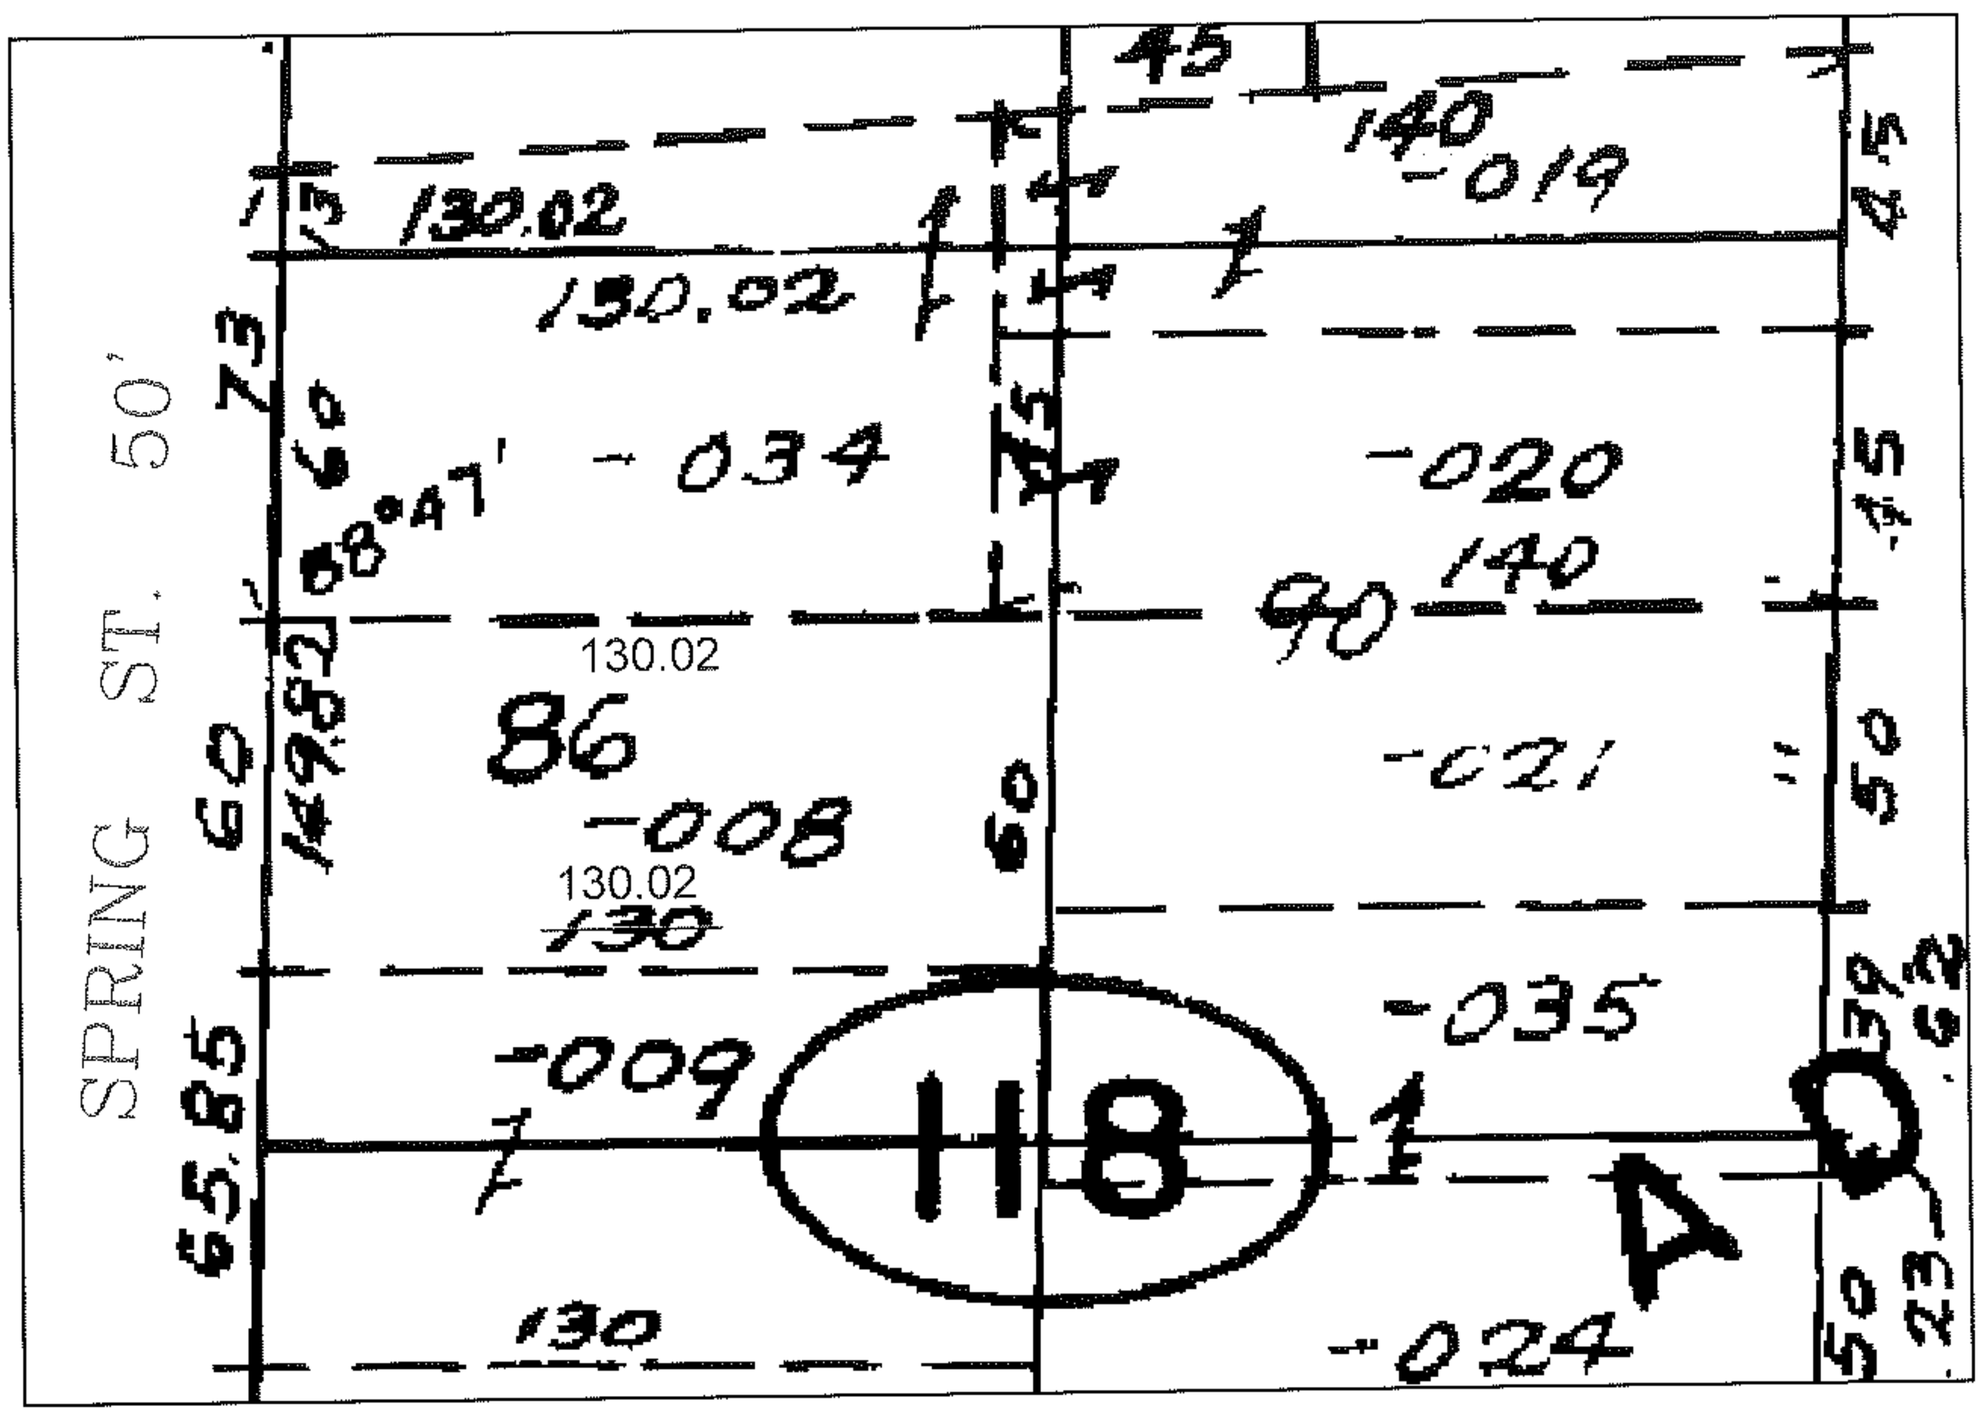

SPLITS/DEEDS PROCESSED

LORAIN COUNTY TAX MAP DEPARTMENT
226 MIDDLE AVE. ELYRIA, OHIO

SURVEYED BY: NONE

CLOSURE: NONE

MAP PAGE(S): 5-00-023-B

APPROVED BY: TJS DATE: 5/19/11

SCALE: 1"= 50' PRIOR INST.: 20050112204