RASTER

PARENT PARCEL: 01-00-076-000-071, -067
CHILD PARCEL: 01-00-076-000-079 THRU -081
STARTING POINT: CENTERLINE OF PORTMAN RD & VERMILION RD

06-02289

ü

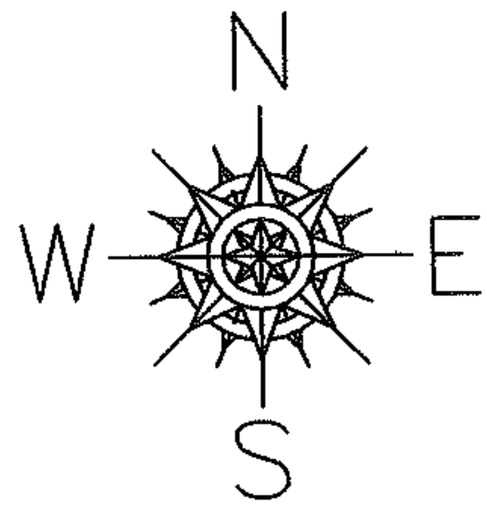

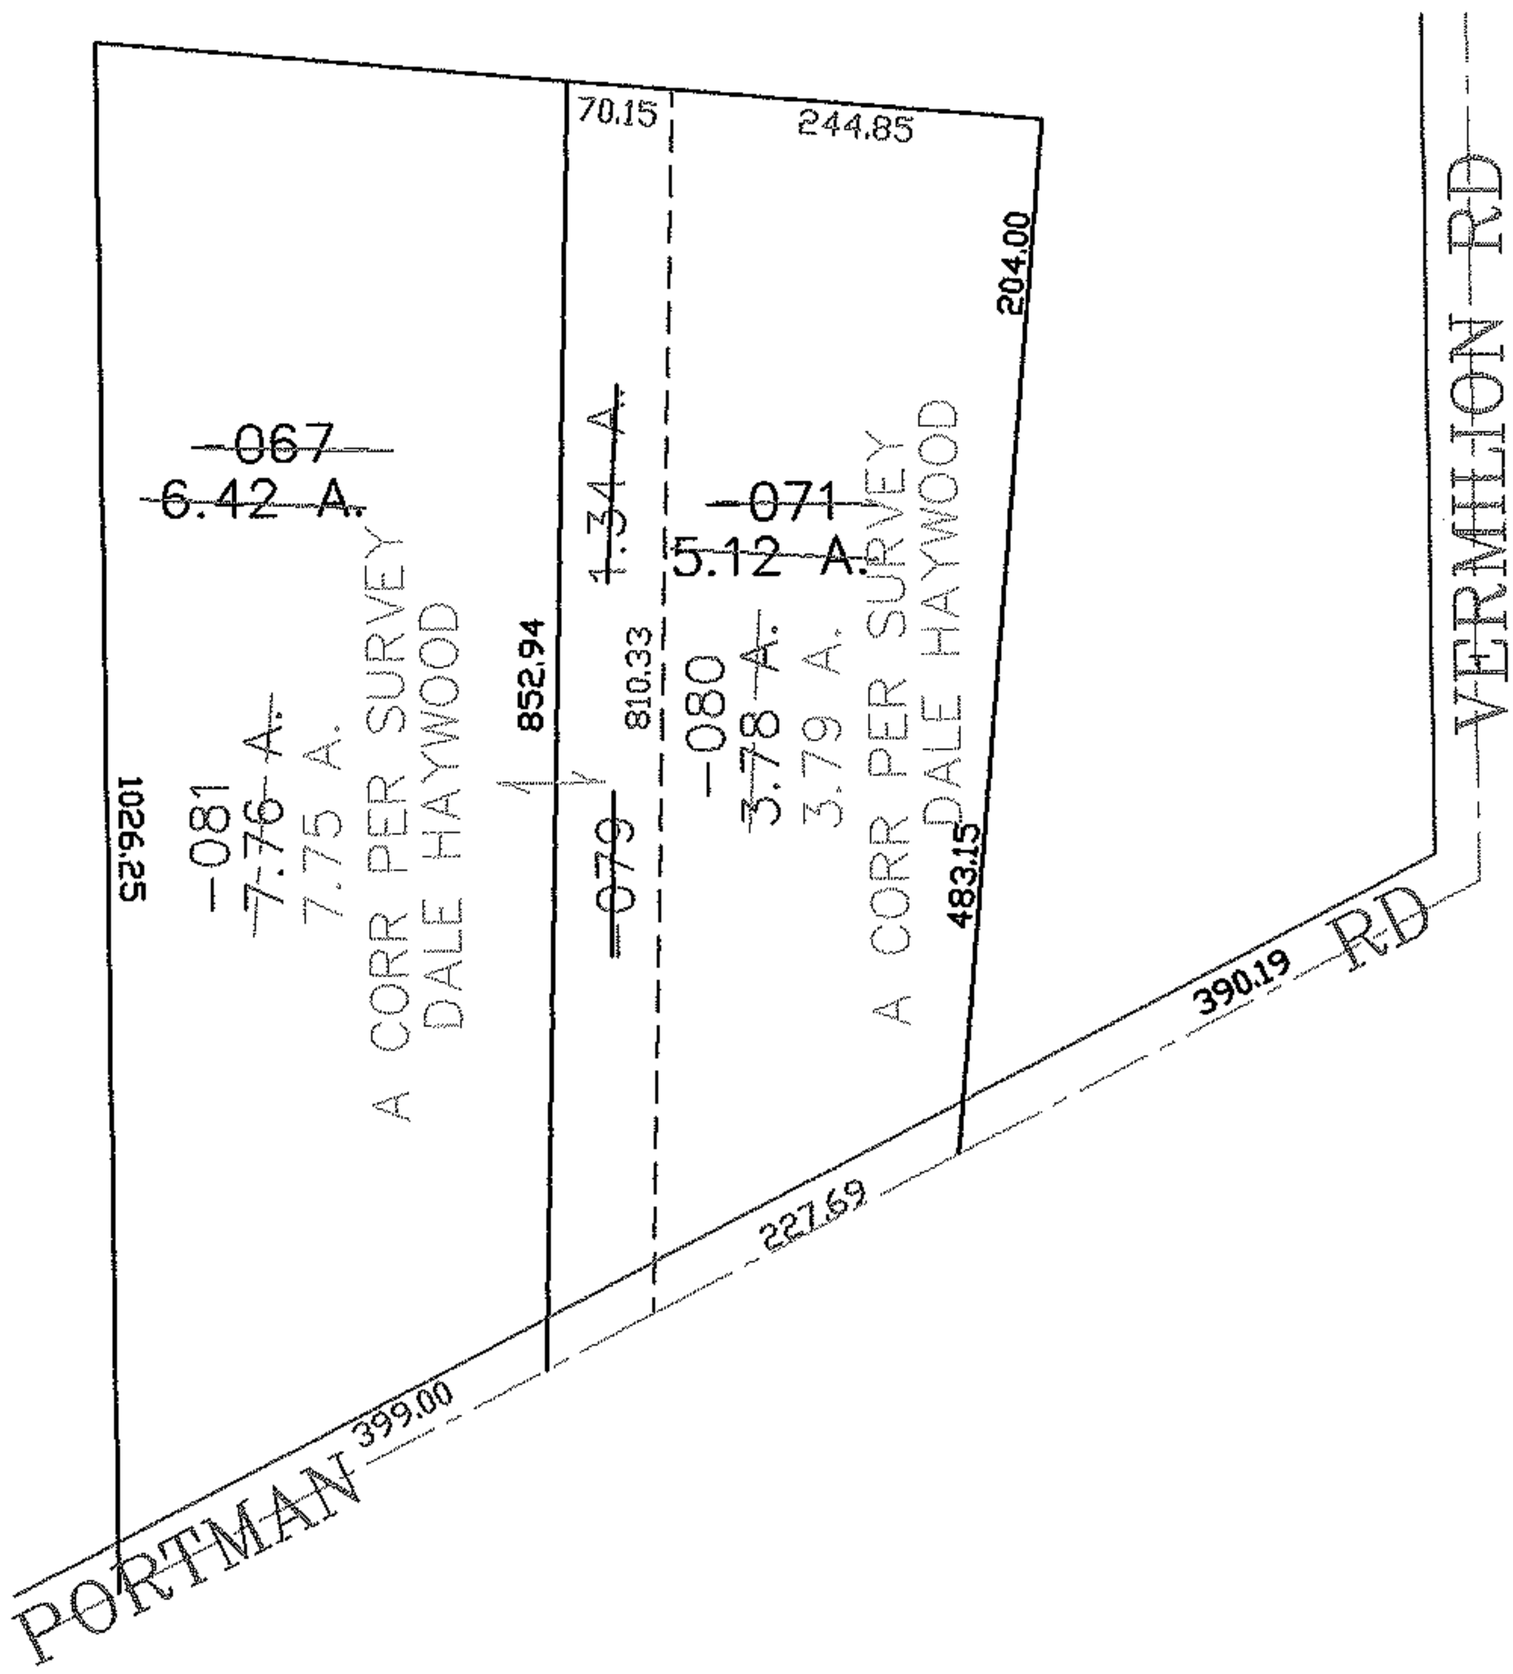

SPLITS/DEEDS PROCESSED
LORAIN COUNTY TAX MAP DEPARTMENT
226 MIDDLE AVE. ELYRIA, OHIO

SURVEYED BY: DALE HAYWOOD
CLOSURE: 0.00 : 10,000
MAP PAGE(S): 01-00-076-A
APPROVED BY: JAH DATE: 12-18-06
SCALE: 1"= 200 PRIOR INSTRUMENT: 20060127382