


PLOT 1' = 100'

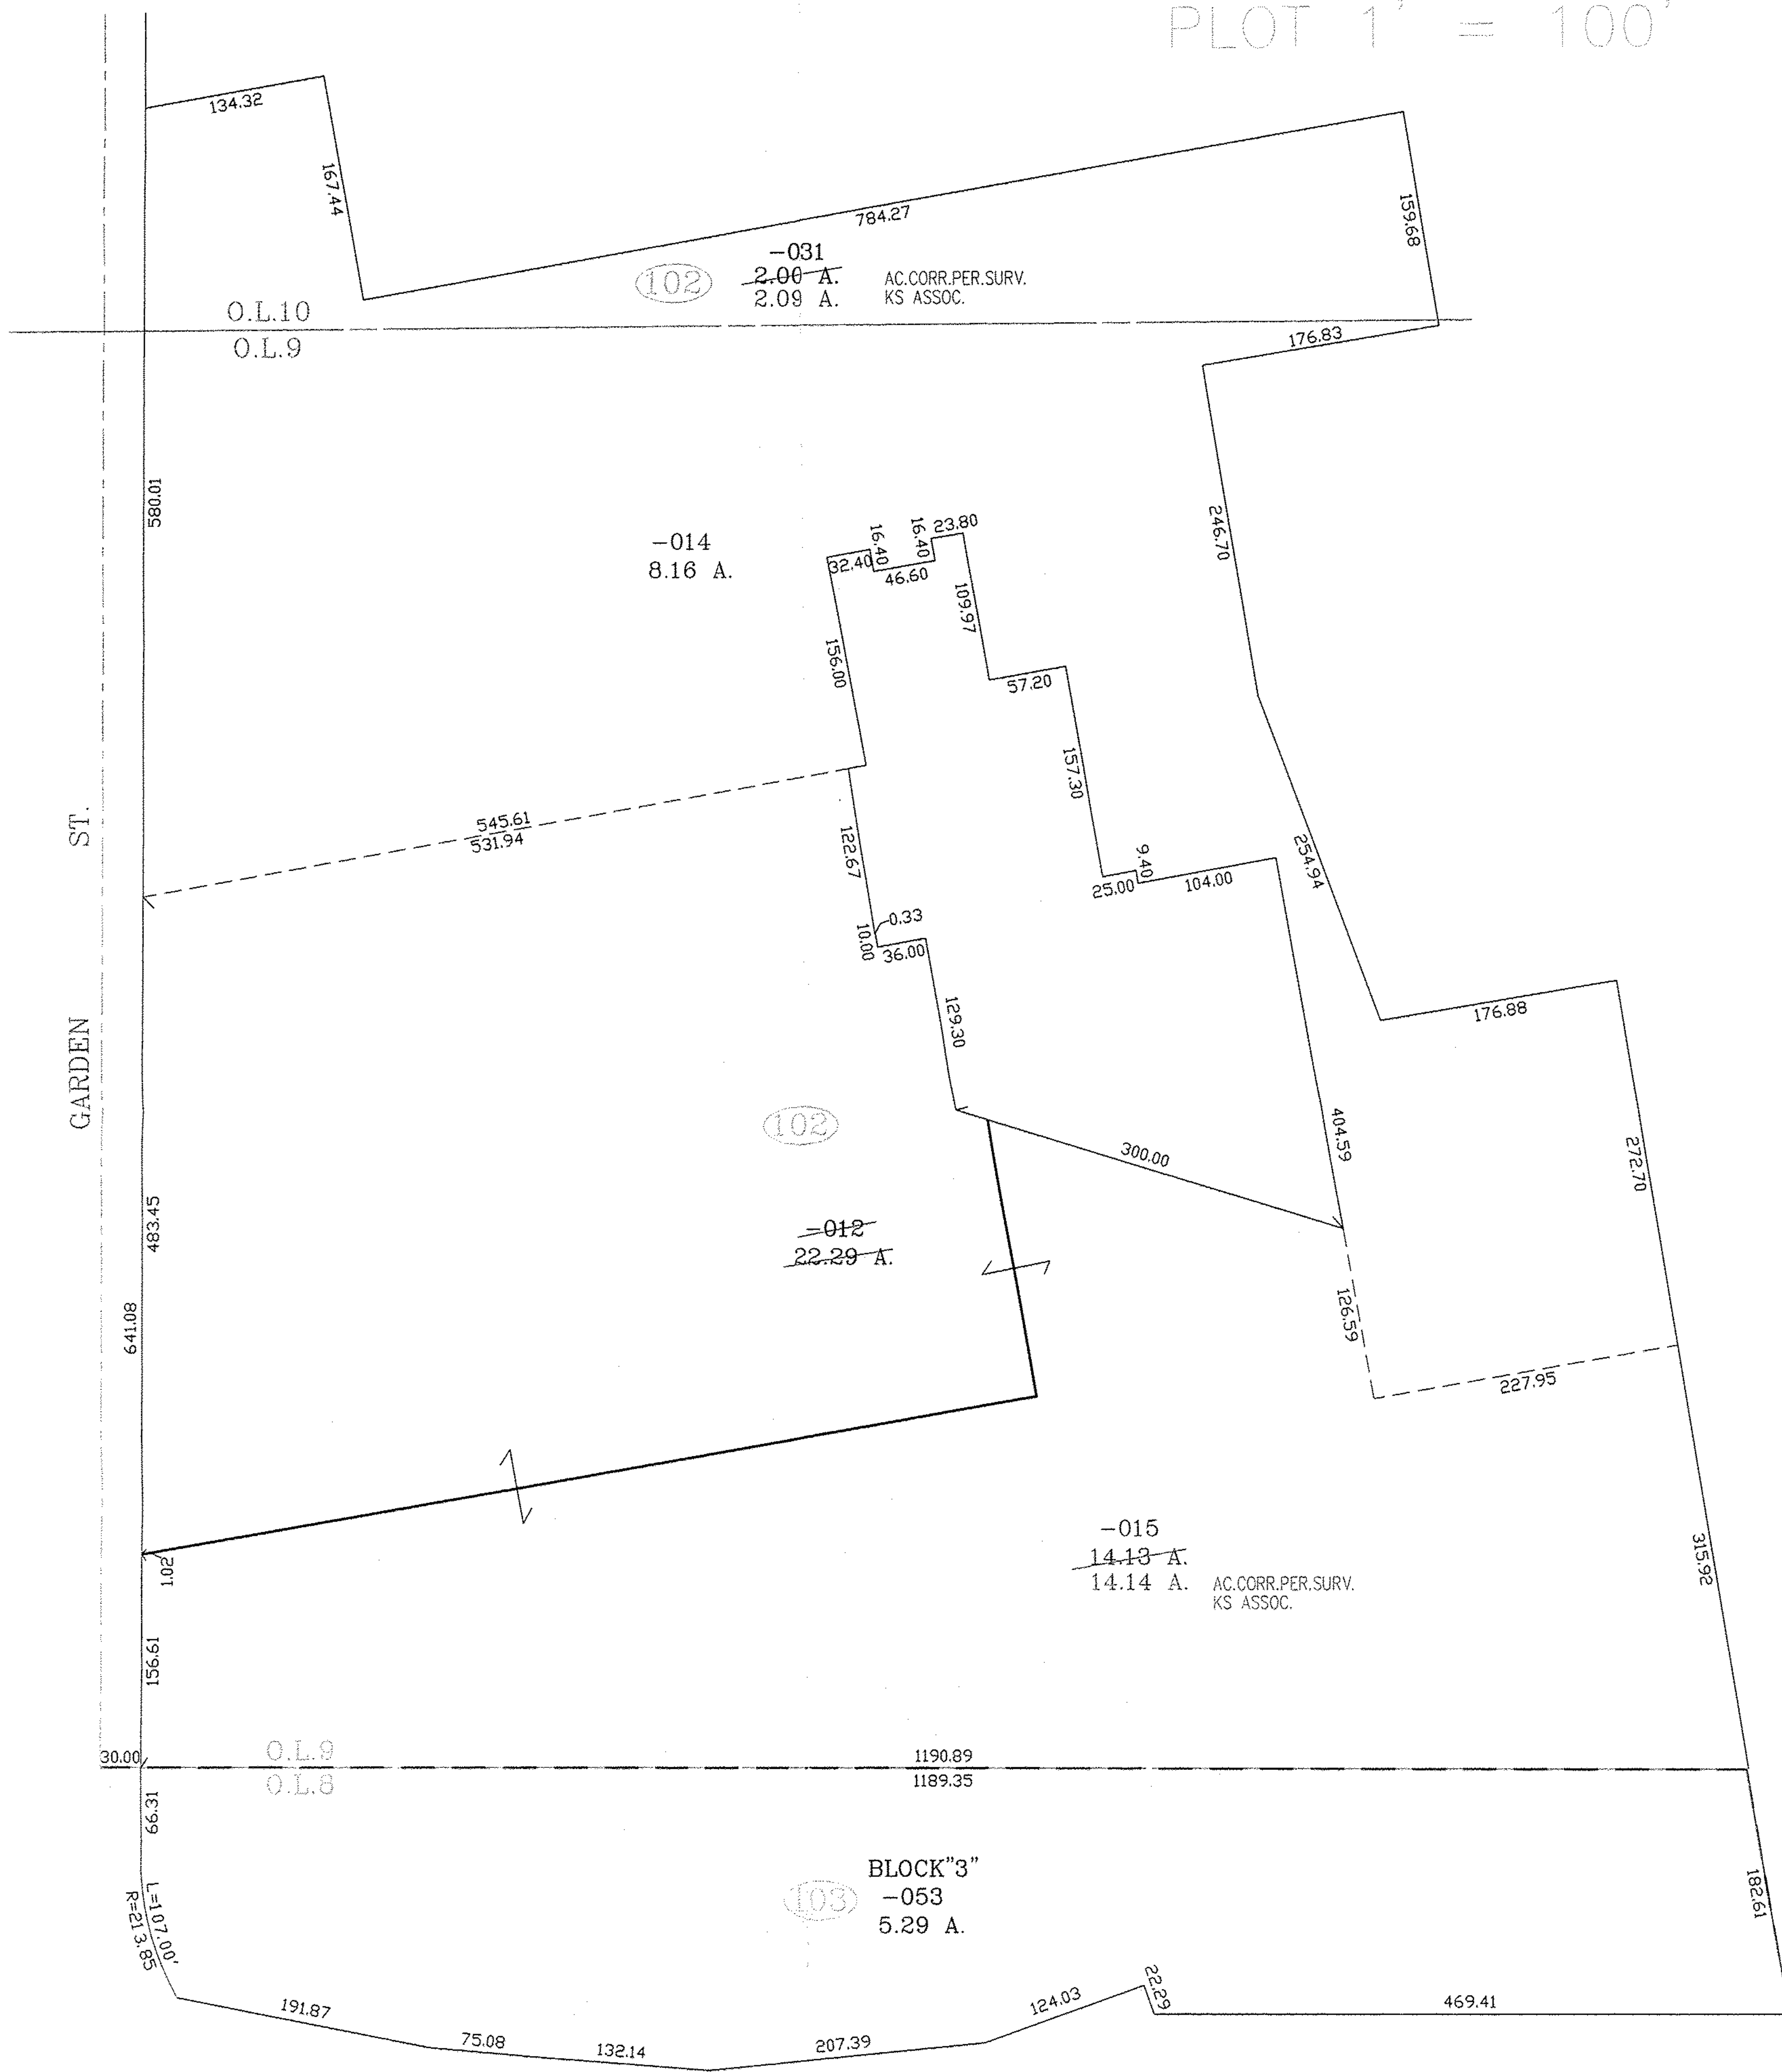

No 02299

APPROVED
 LORAIN CO.
 MAP DEPT.
 DATE 12-26-06
 PAGE 6-135
 6-134
 BY R. MAINES
 06-02299