RASTER

PARENT PARCEL: 05-00-053-000-067
CHILD PARCEL: 05-00-053-000-090 THRU -094
STARTING POINT: CENTERLINE OF ELYRIA-MILAN RD & OBERLIN RD

07-02322

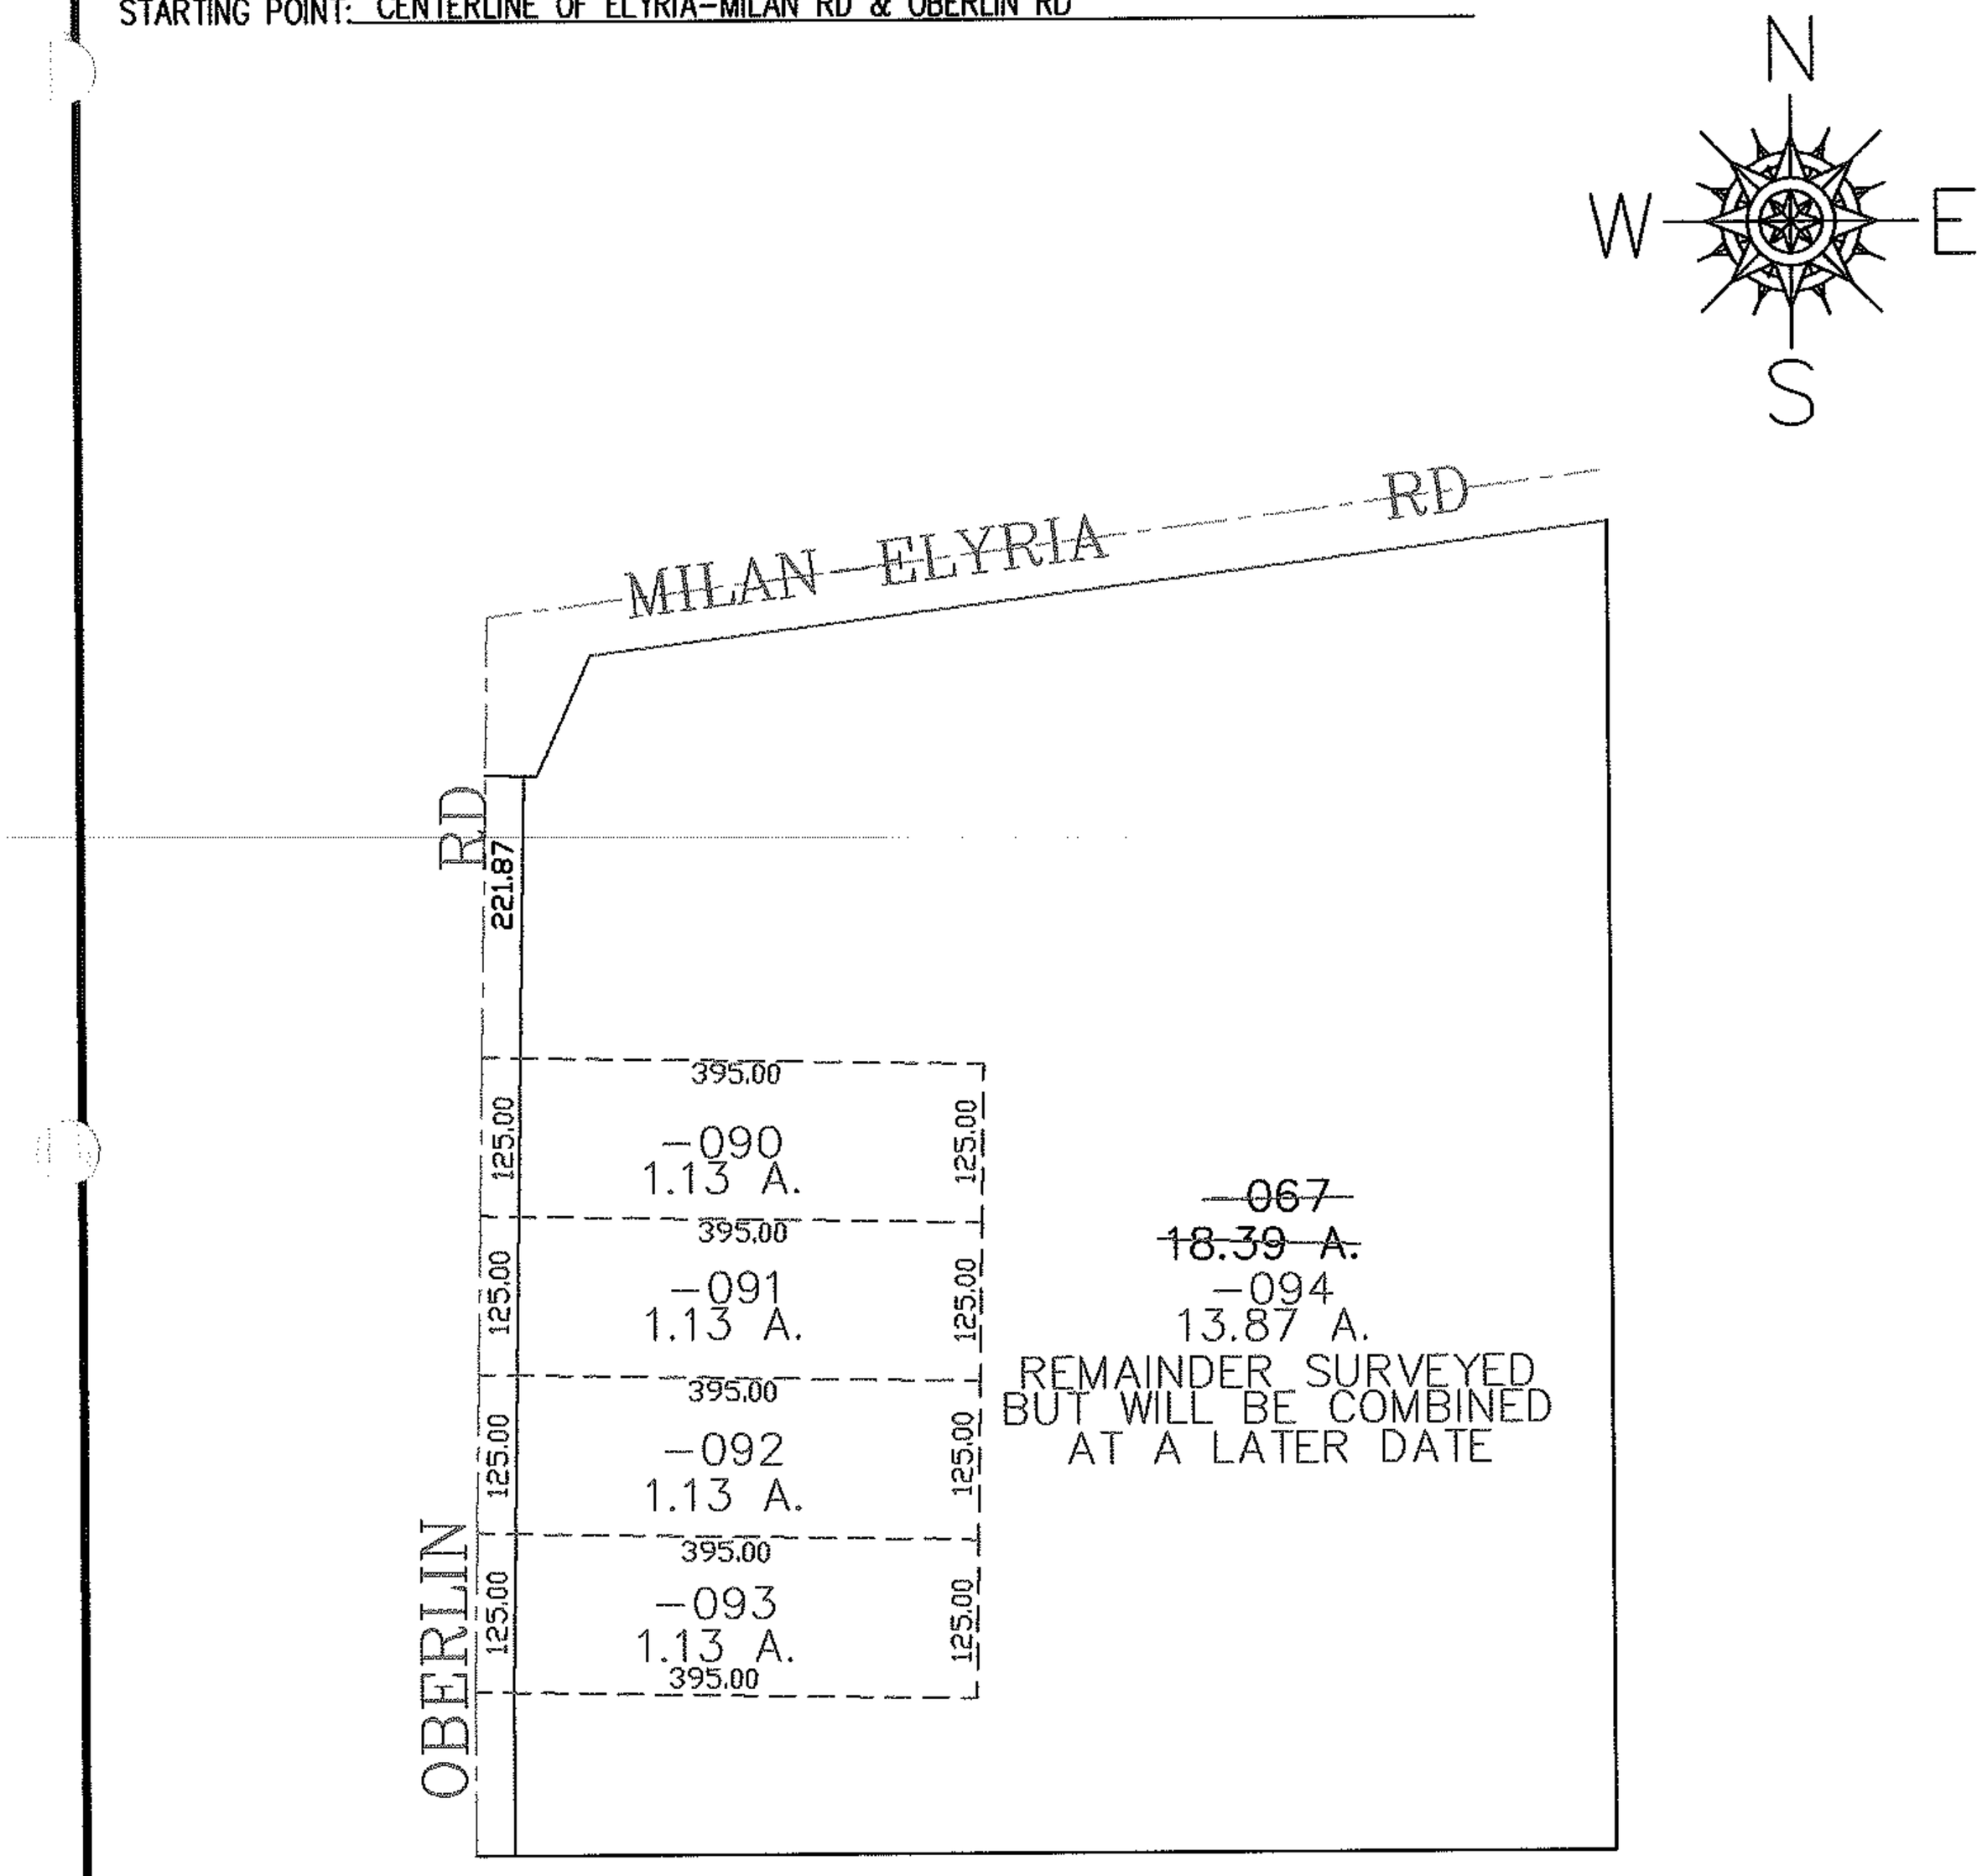

SPLITS/DEEDS PROCESSED

LORAIN COUNTY TAX MAP DEPARTMENT
226 MIDDLE AVE. ELYRIA, OHIO

SURVEYED BY: THOMAS SIMON
CLOSURE: 0.00 : 10.000
MAP PAGE(S): 05-00-053-B
APPROVED BY: JAH DATE: 2-7-07
SCALE: 1"= 200 PRIOR INSTRUMENT: 20020827160