RASTER

PARENT PARCEL: 09-00-080-000-013, -014

CHILD PARCEL: 09-00-080-000-050

STARTING POINT: CENTERLINE OF OBERLIN-ELYRIA RD & O.L. 80

07-02329

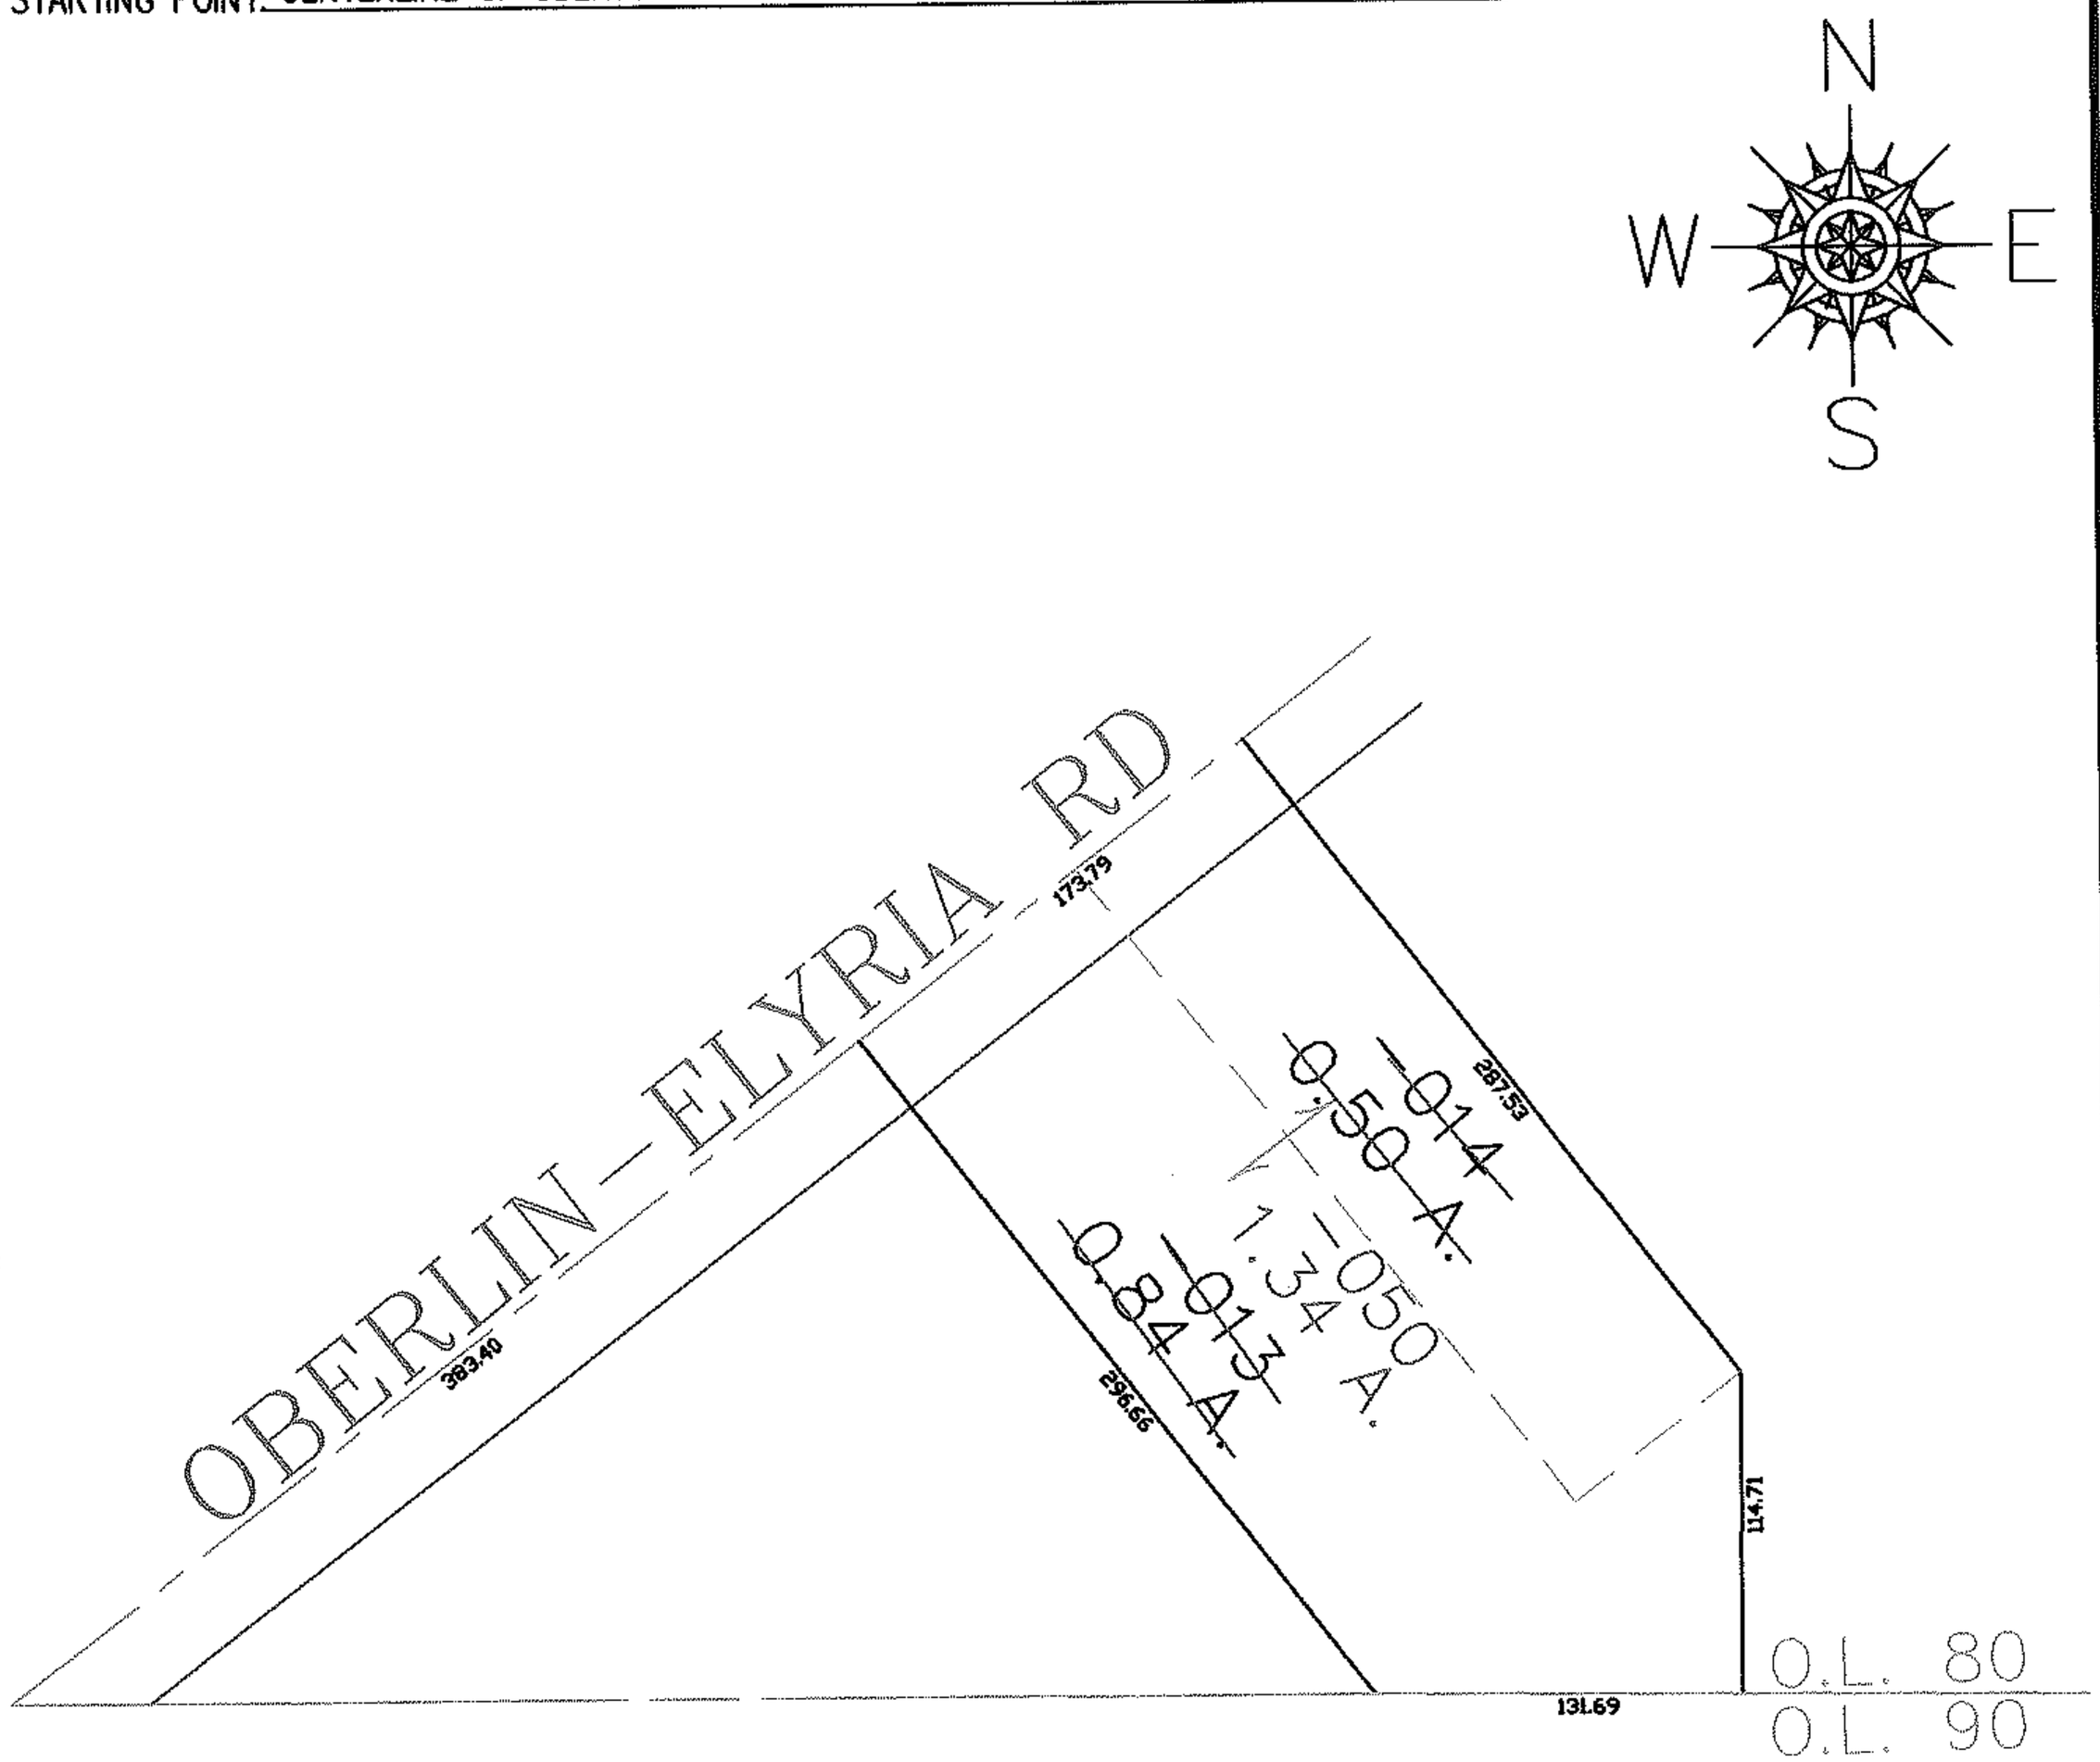

SPLITS/DEEDS PROCESSED

LORAIN COUNTY TAX MAP DEPARTMENT
226 MIDDLE AVE. ELYRIA, OHIO

SURVEYED BY: JAMES RESAR

CLOSURE: 0.00 : 10.000

MAP PAGE(S): 09-00-080-B

APPROVED BY: JAH DATE: 2-13-07

SCALE: 1"= 100 PRIOR INSTRUMENT: 2006124584