RASTER

PARENT PARCEL: 03-00-076-114-023, -024

CHILD PARCEL: 03-00-076-14-025 THRU -027

STARTING POINT: CENTERLINE OF NORTH RIDGE RD & WEST RIVER RD

07-02348

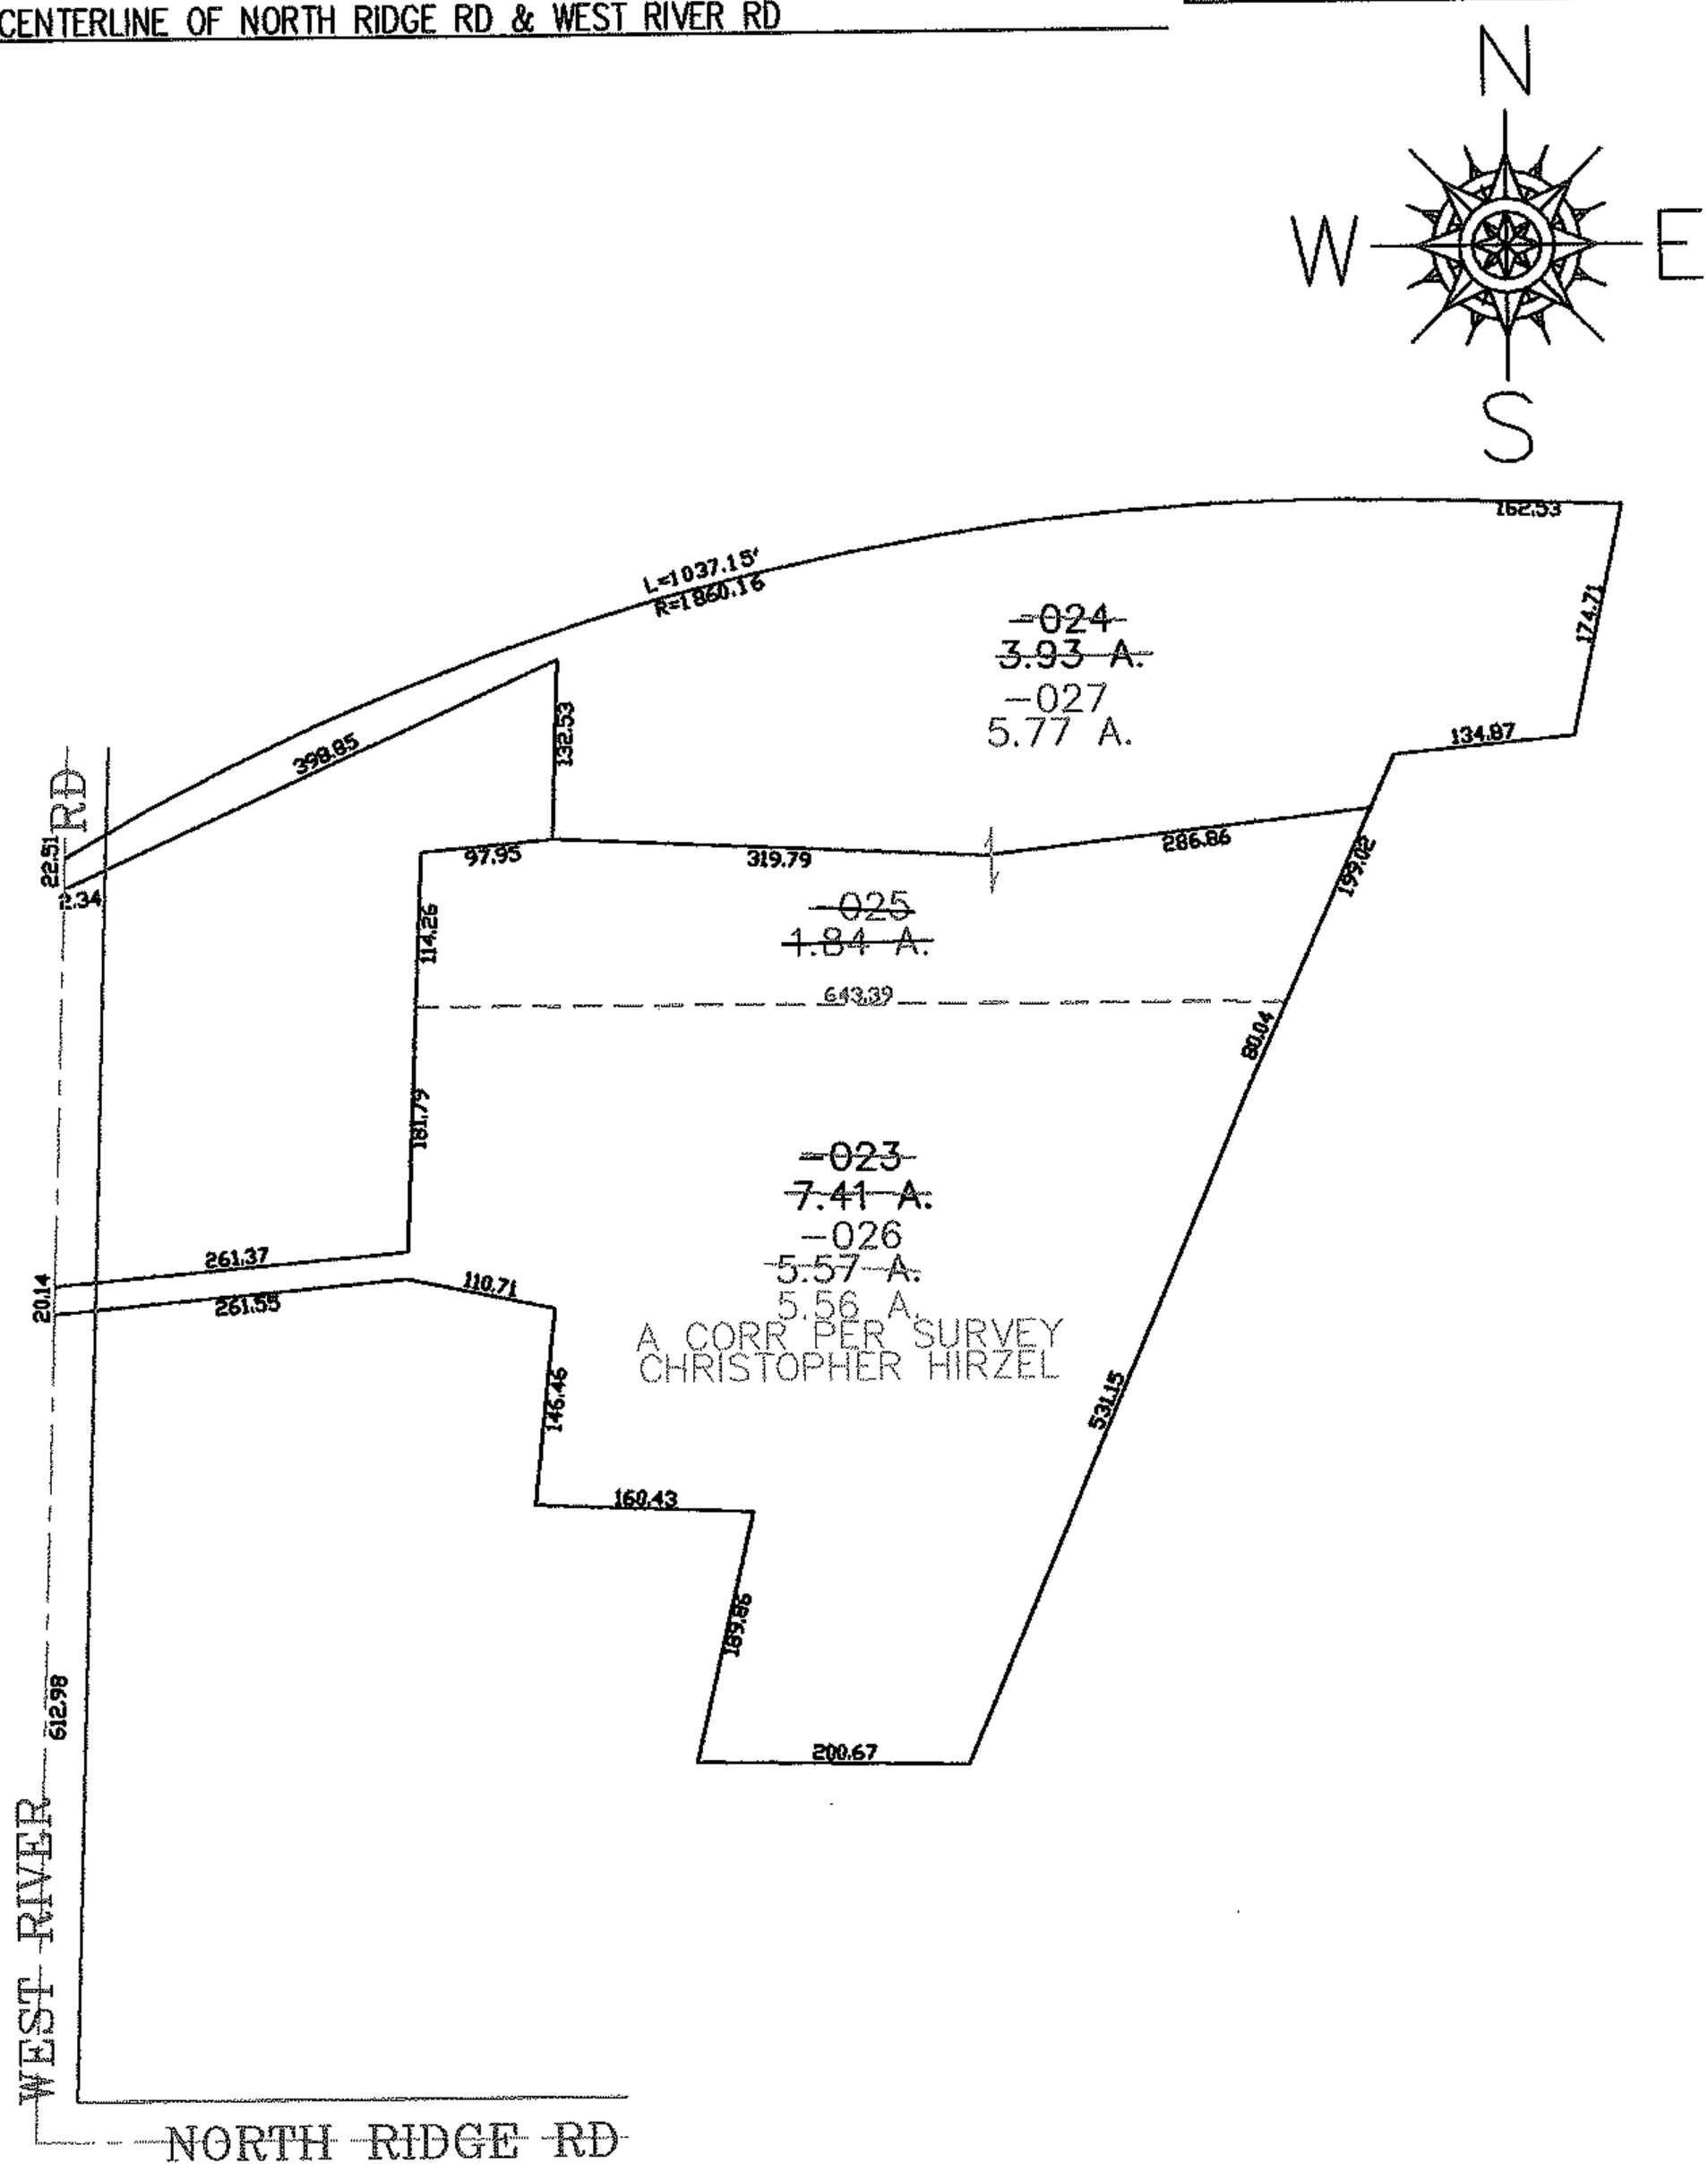

SPLITS/DEEDS PROCESSED

LORAIN COUNTY TAX MAP DEPARTMENT
226 MIDDLE AVE. ELYRIA, OHIO

SURVEYED BY: CHRISTOPHER HIRZEL

CLOSURE: 0.00 : 10.000

MAP PAGE(S): 03-00-075-C

APPROVED BY: JAH DATE: 3-27-07

SCALE: 1"= 200 PRIOR INSTRUMENT: DV 1425/692