PARENT PARCEL: 06-23-003-900-002 DROP FROM DUPLICATE

CHILD PARCEL:

STARTING POINT: INT OF N ROW CRESTLANE DR E ROW OF EL CAMINO CT

11-02356-C

ST VAC RES NO 03-539

N
W E
S

DROP FROM DUP.

06-23-003-900-002
0.58 A.

ACREAGE CORR.

06-23-003-102-040
~~2.54 A.~~
2.10 A.
PER CALC.

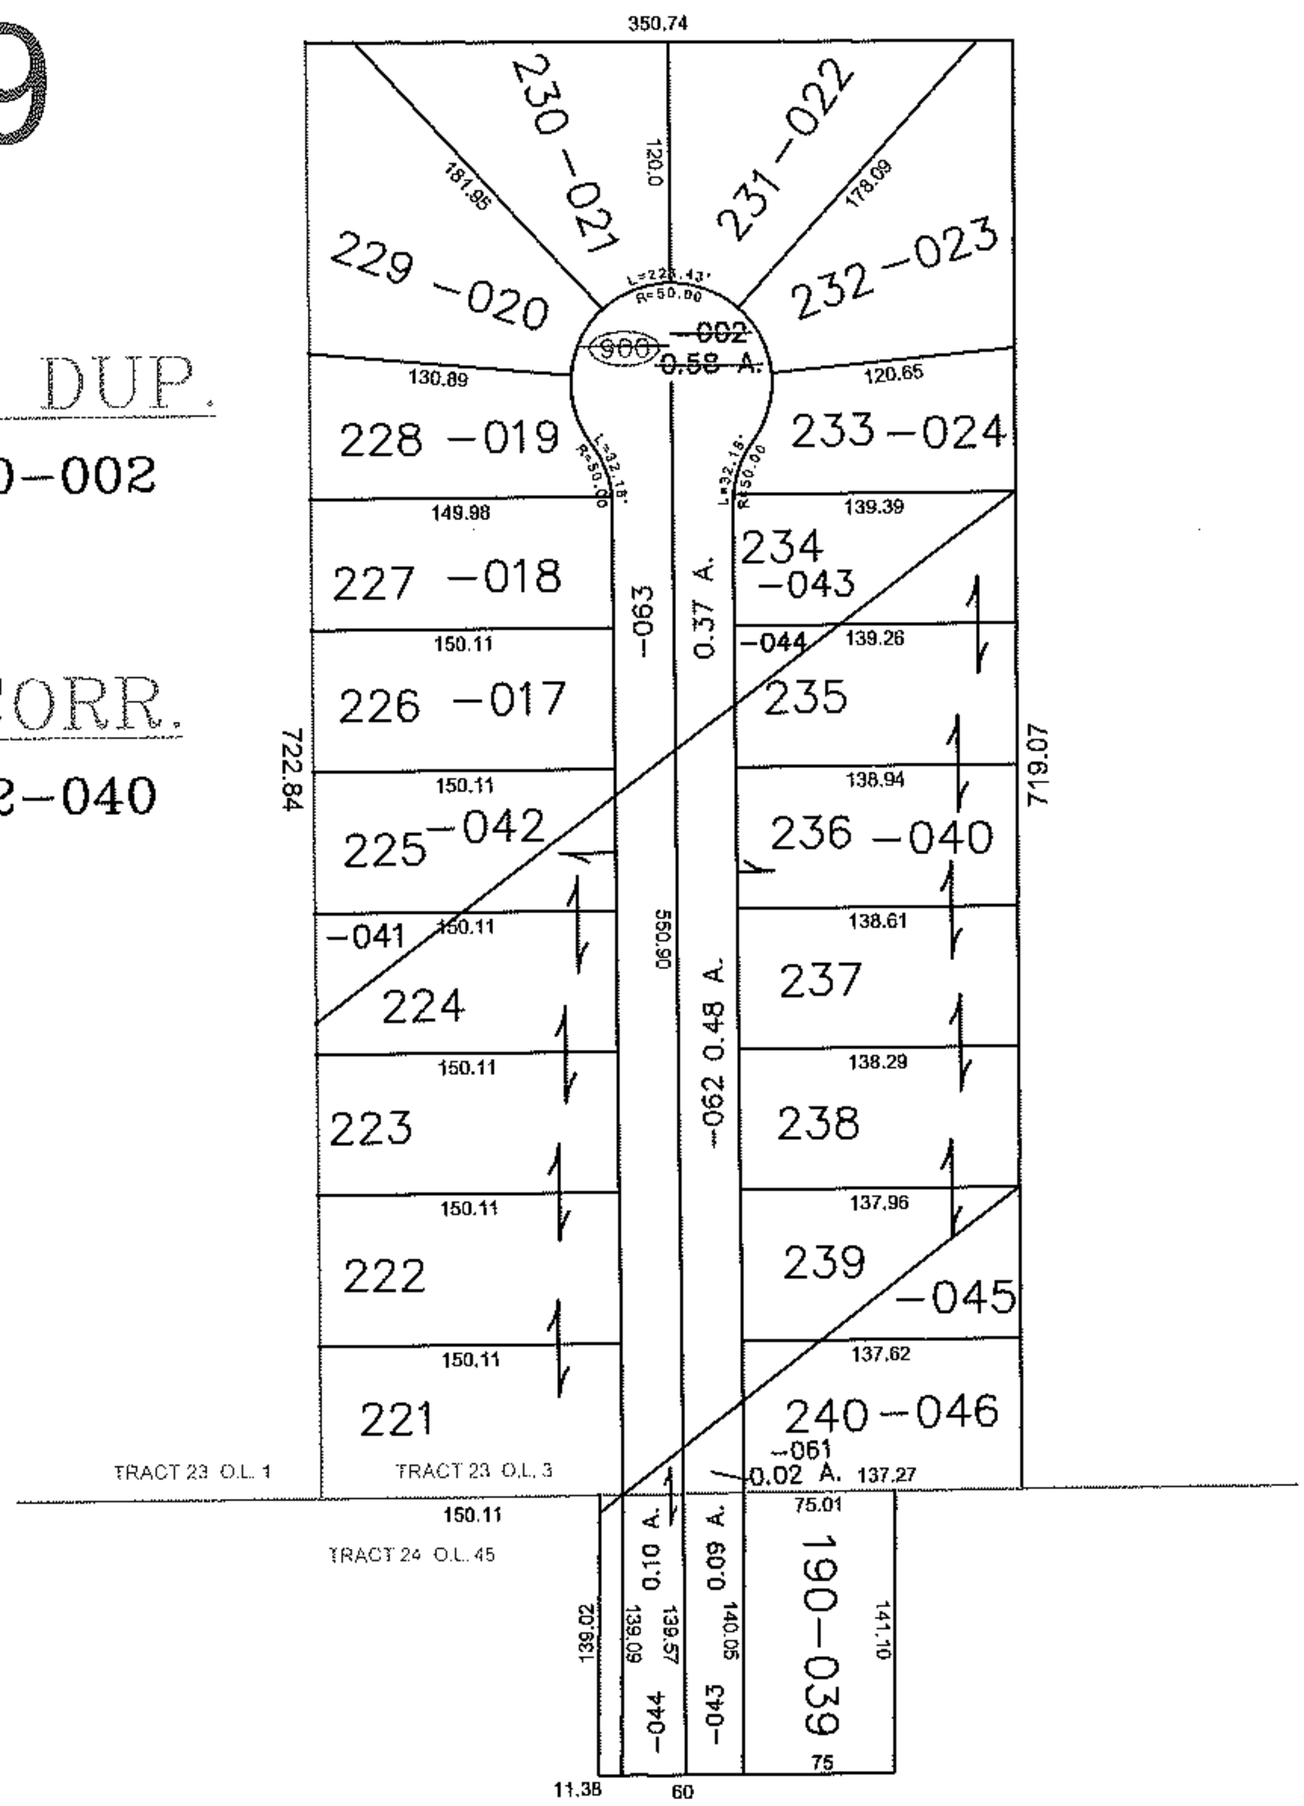

SPLITS/DEEDS PROCESSED

LORAIN COUNTY TAX MAP DEPARTMENT
226 MIDDLE AVE. ELYRIA, OHIO

SURVEYED BY: N/A

CLOSURE: N/A

MAP PAGE(S): 6-38, 6-39

APPROVED BY: TJS DATE: 9/26/11

SCALE: 1"= 150 PRIOR INSTRUMENT: RES 03-539