RASTER

PARENT PARCEL: 16-00-052-000-015
CHILD PARCEL: 16-00-052-000-028 THRU -030
STARTING POINT: CENTERLINE OF MEDINA-ELYRIA RD (RT 303) & MEDINA ELYRIA RD (RT 57)

07-02358

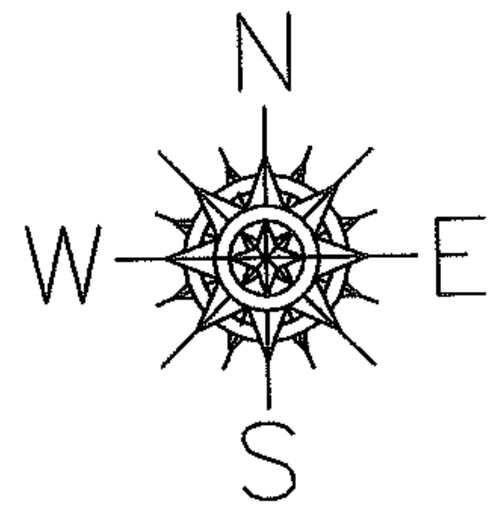

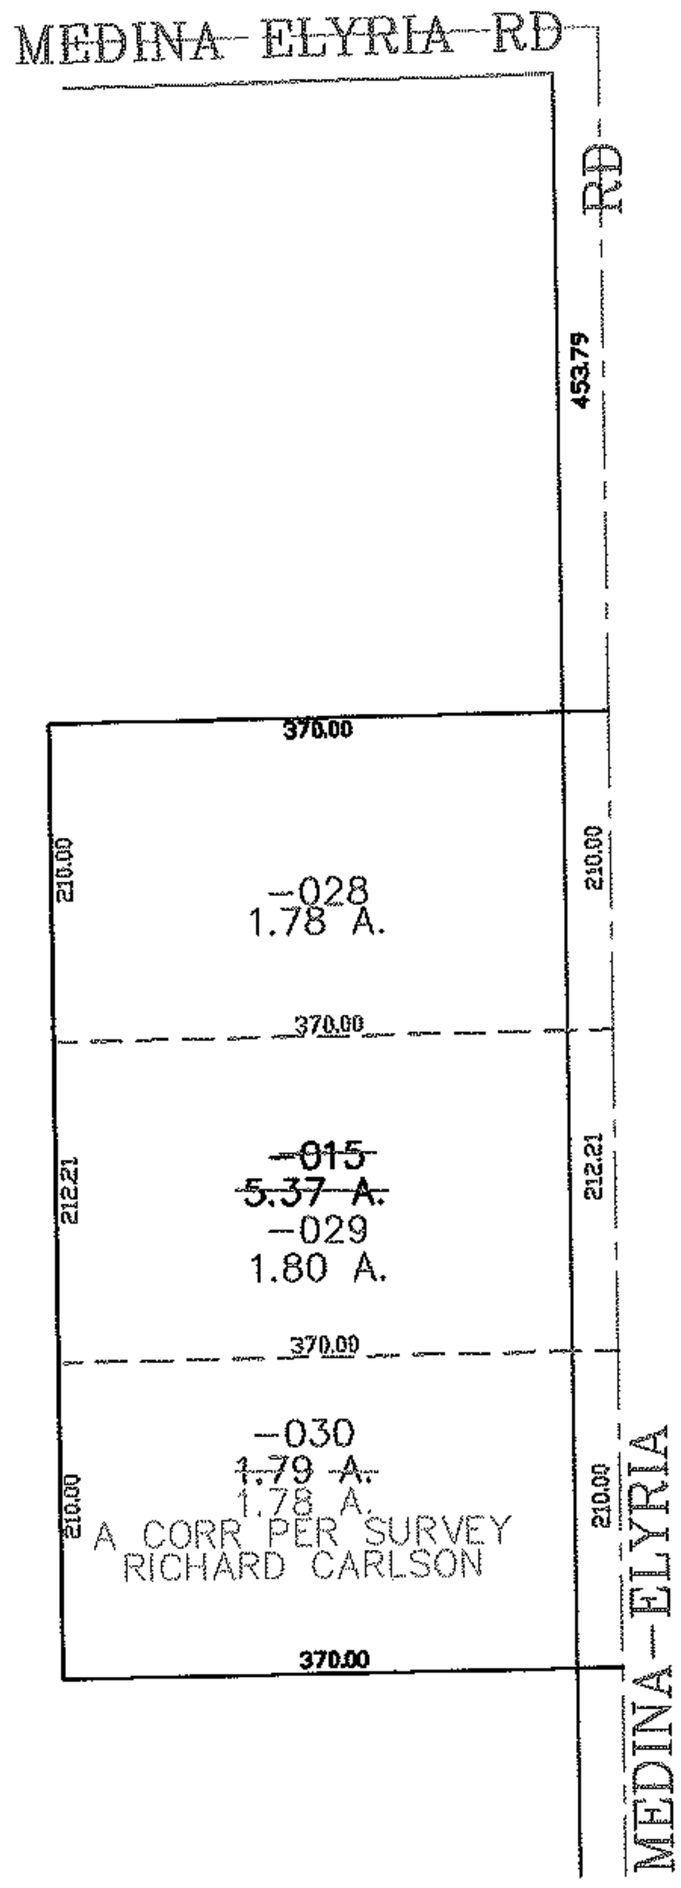

SPLITS/DEEDS PROCESSED
LORAIN COUNTY TAX MAP DEPARTMENT
226 MIDDLE AVE. ELYRIA, OHIO

SURVEYED BY: RICHARD CARLSON
CLOSURE: 0.00 : 10,000
MAP PAGE(S): 16-H
APPROVED BY: JAH DATE: 4-17-07
SCALE: 1"= 200 PRIOR INSTRUMENT: 19980524054