RASTER

PARENT PARCEL: 06-24-003-104-072

CHILD PARCEL: 06-24-003-104-089, -090

STARTING POINT: NORTHEAST CORNER OF S/L 45 IN WEST RIDGE EST NO 4

07-02361

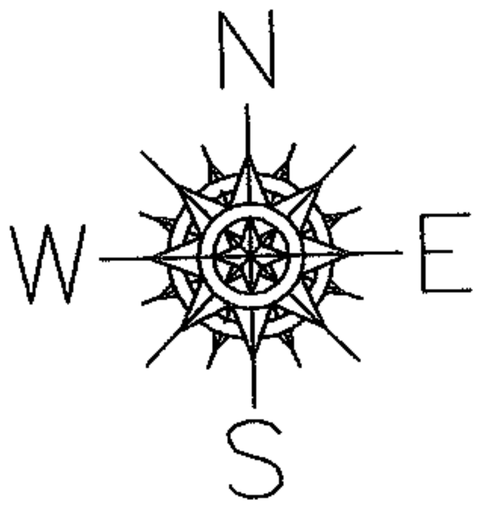

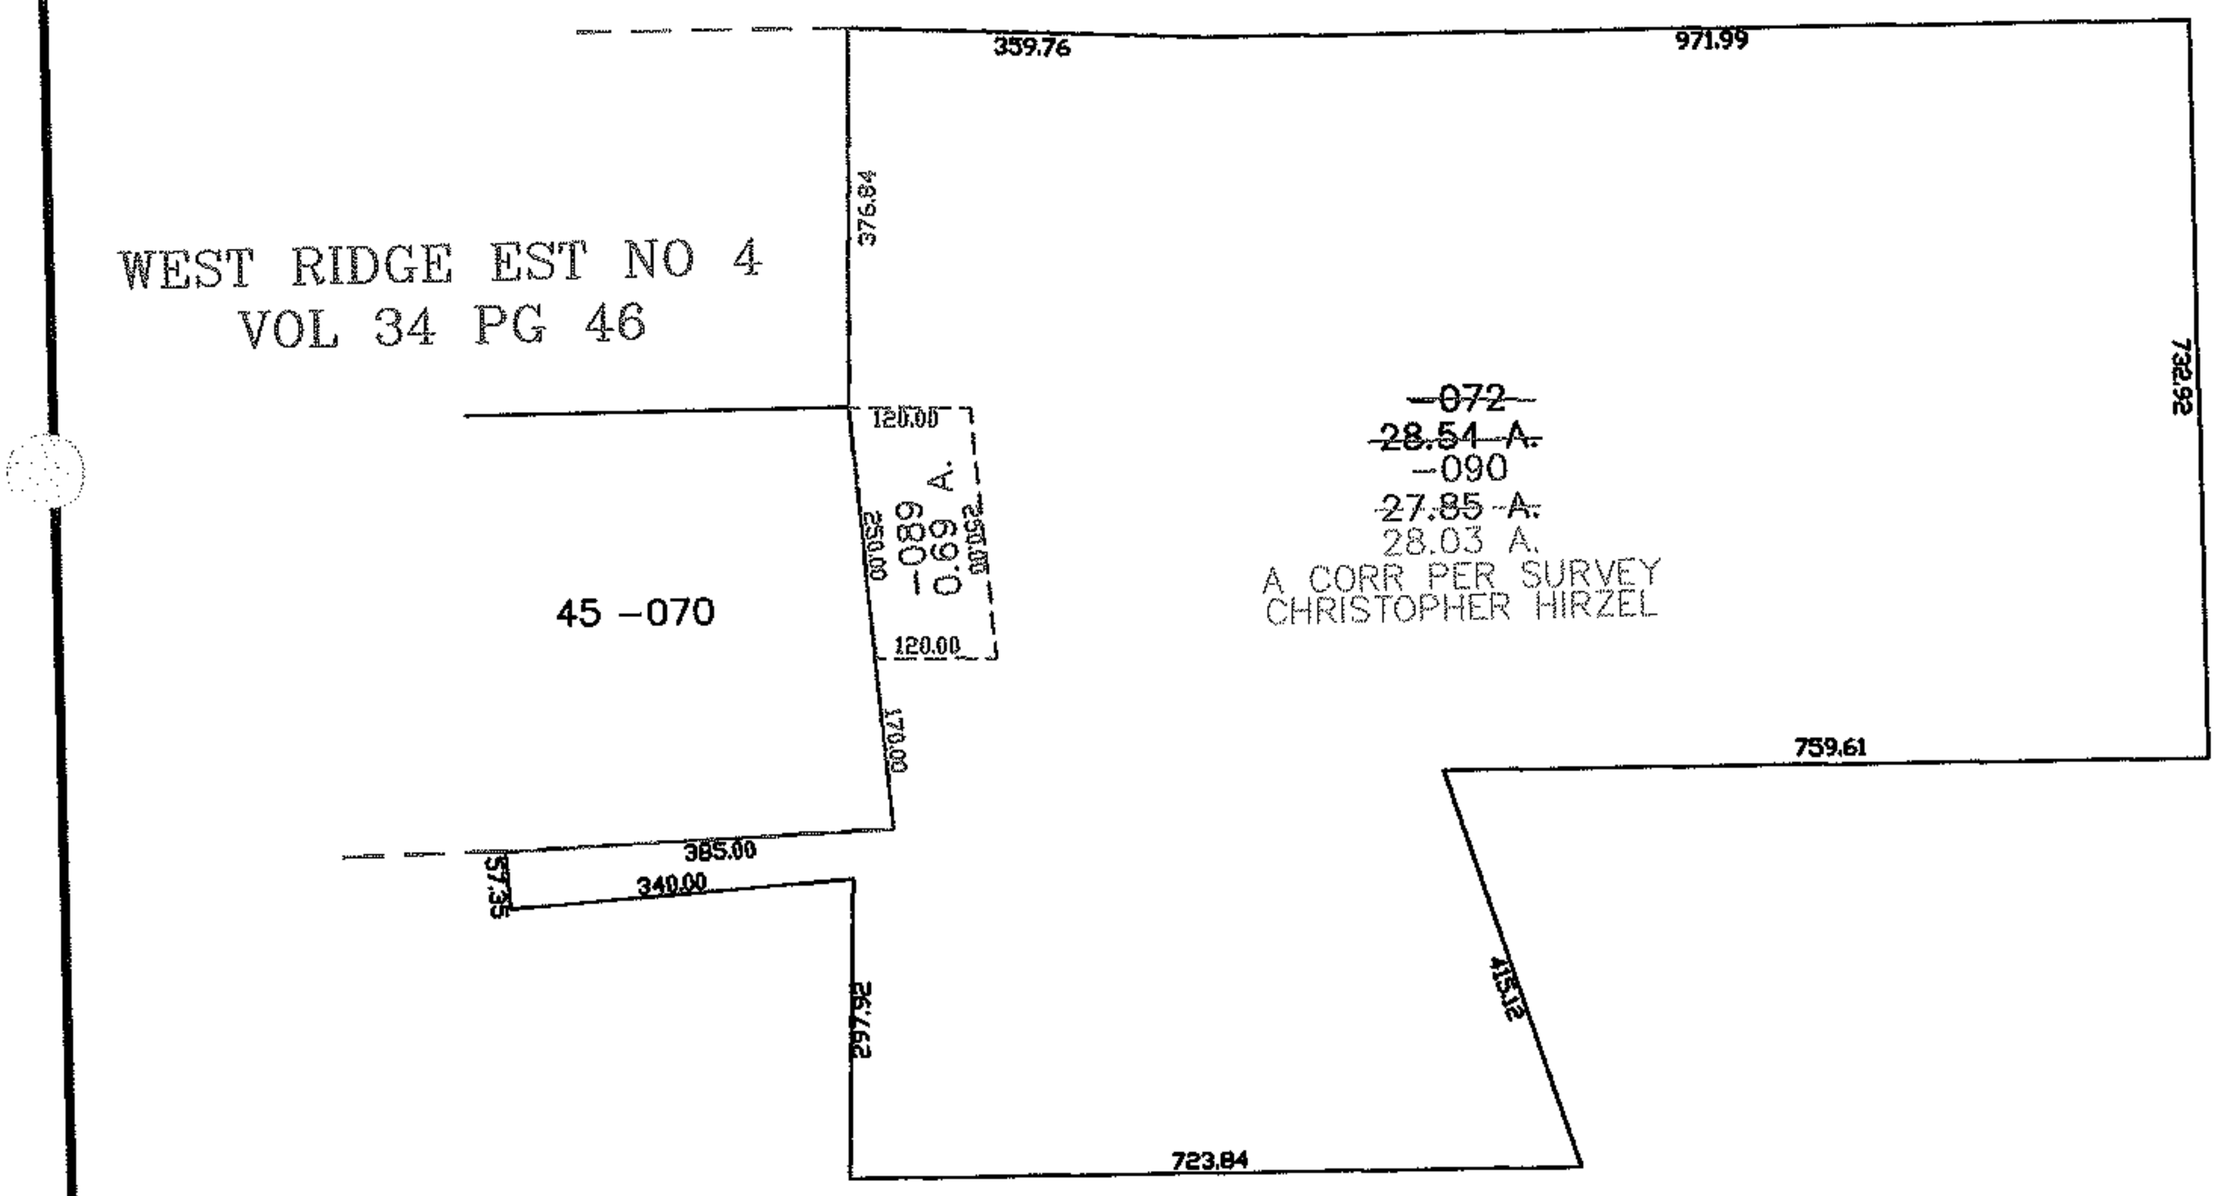

SPLITS/DEEDS PROCESSED

LORAIN COUNTY TAX MAP DEPARTMENT
226 MIDDLE AVE. ELYRIA, OHIO

SURVEYED BY: CHRISTOPHER HIRZEL

CLOSURE: 0.00 : 10,000

MAP PAGE(S): 6-111

APPROVED BY: JAH DATE: 4-19-07

SCALE: 1"= 300 PRIOR INSTRUMENT: DV 483/630