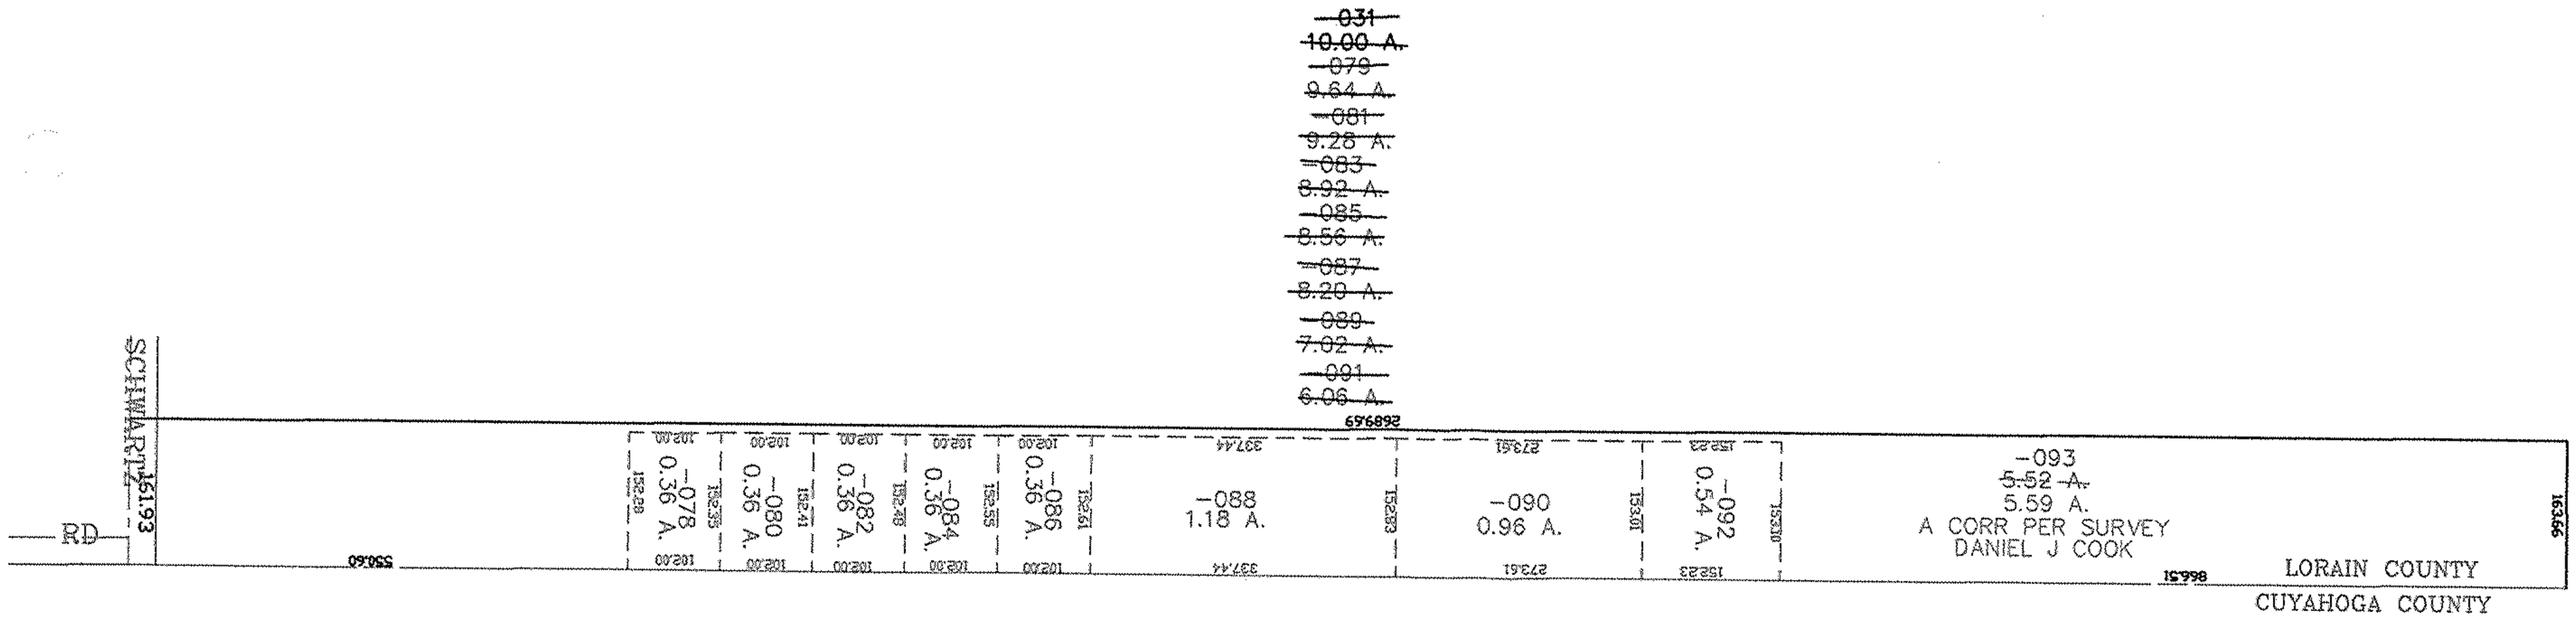
~~031~~
~~10.00 A.~~
~~079~~
~~9.64 A.~~
~~081~~
~~9.28 A.~~
~~083~~
~~8.92 A.~~
~~085~~
~~8.56 A.~~
~~087~~
~~8.20 A.~~
~~089~~
~~7.02 A.~~
~~091~~
~~6.06 A.~~
SCHWARTZ
16193
RD
078
0.36 A.
080
0.36 A.
082
0.36 A.
084
0.36 A.
086
0.36 A.
088
1.18 A.
090
0.96 A.
092
0.54 A.
093
~~5.52 A.~~
5.59 A.
A CORR PER SURVEY
DANIEL J COOK
LORAIN COUNTY
CUYAHOGA COUNTY

07-02371