PARENT PARCEL: ADD TO DUPLICATE

CHILD PARCEL: 06-23-002-102-053

RTING POINT: XXXXXX

11-02374-A

ADD TO DUPLICATE

PT. 06-23-002-102-053
PT. 3.37 A.

SHOULD HAVE NEVER SPLIT
06-23-002-102-036
#15736

N
W E
S

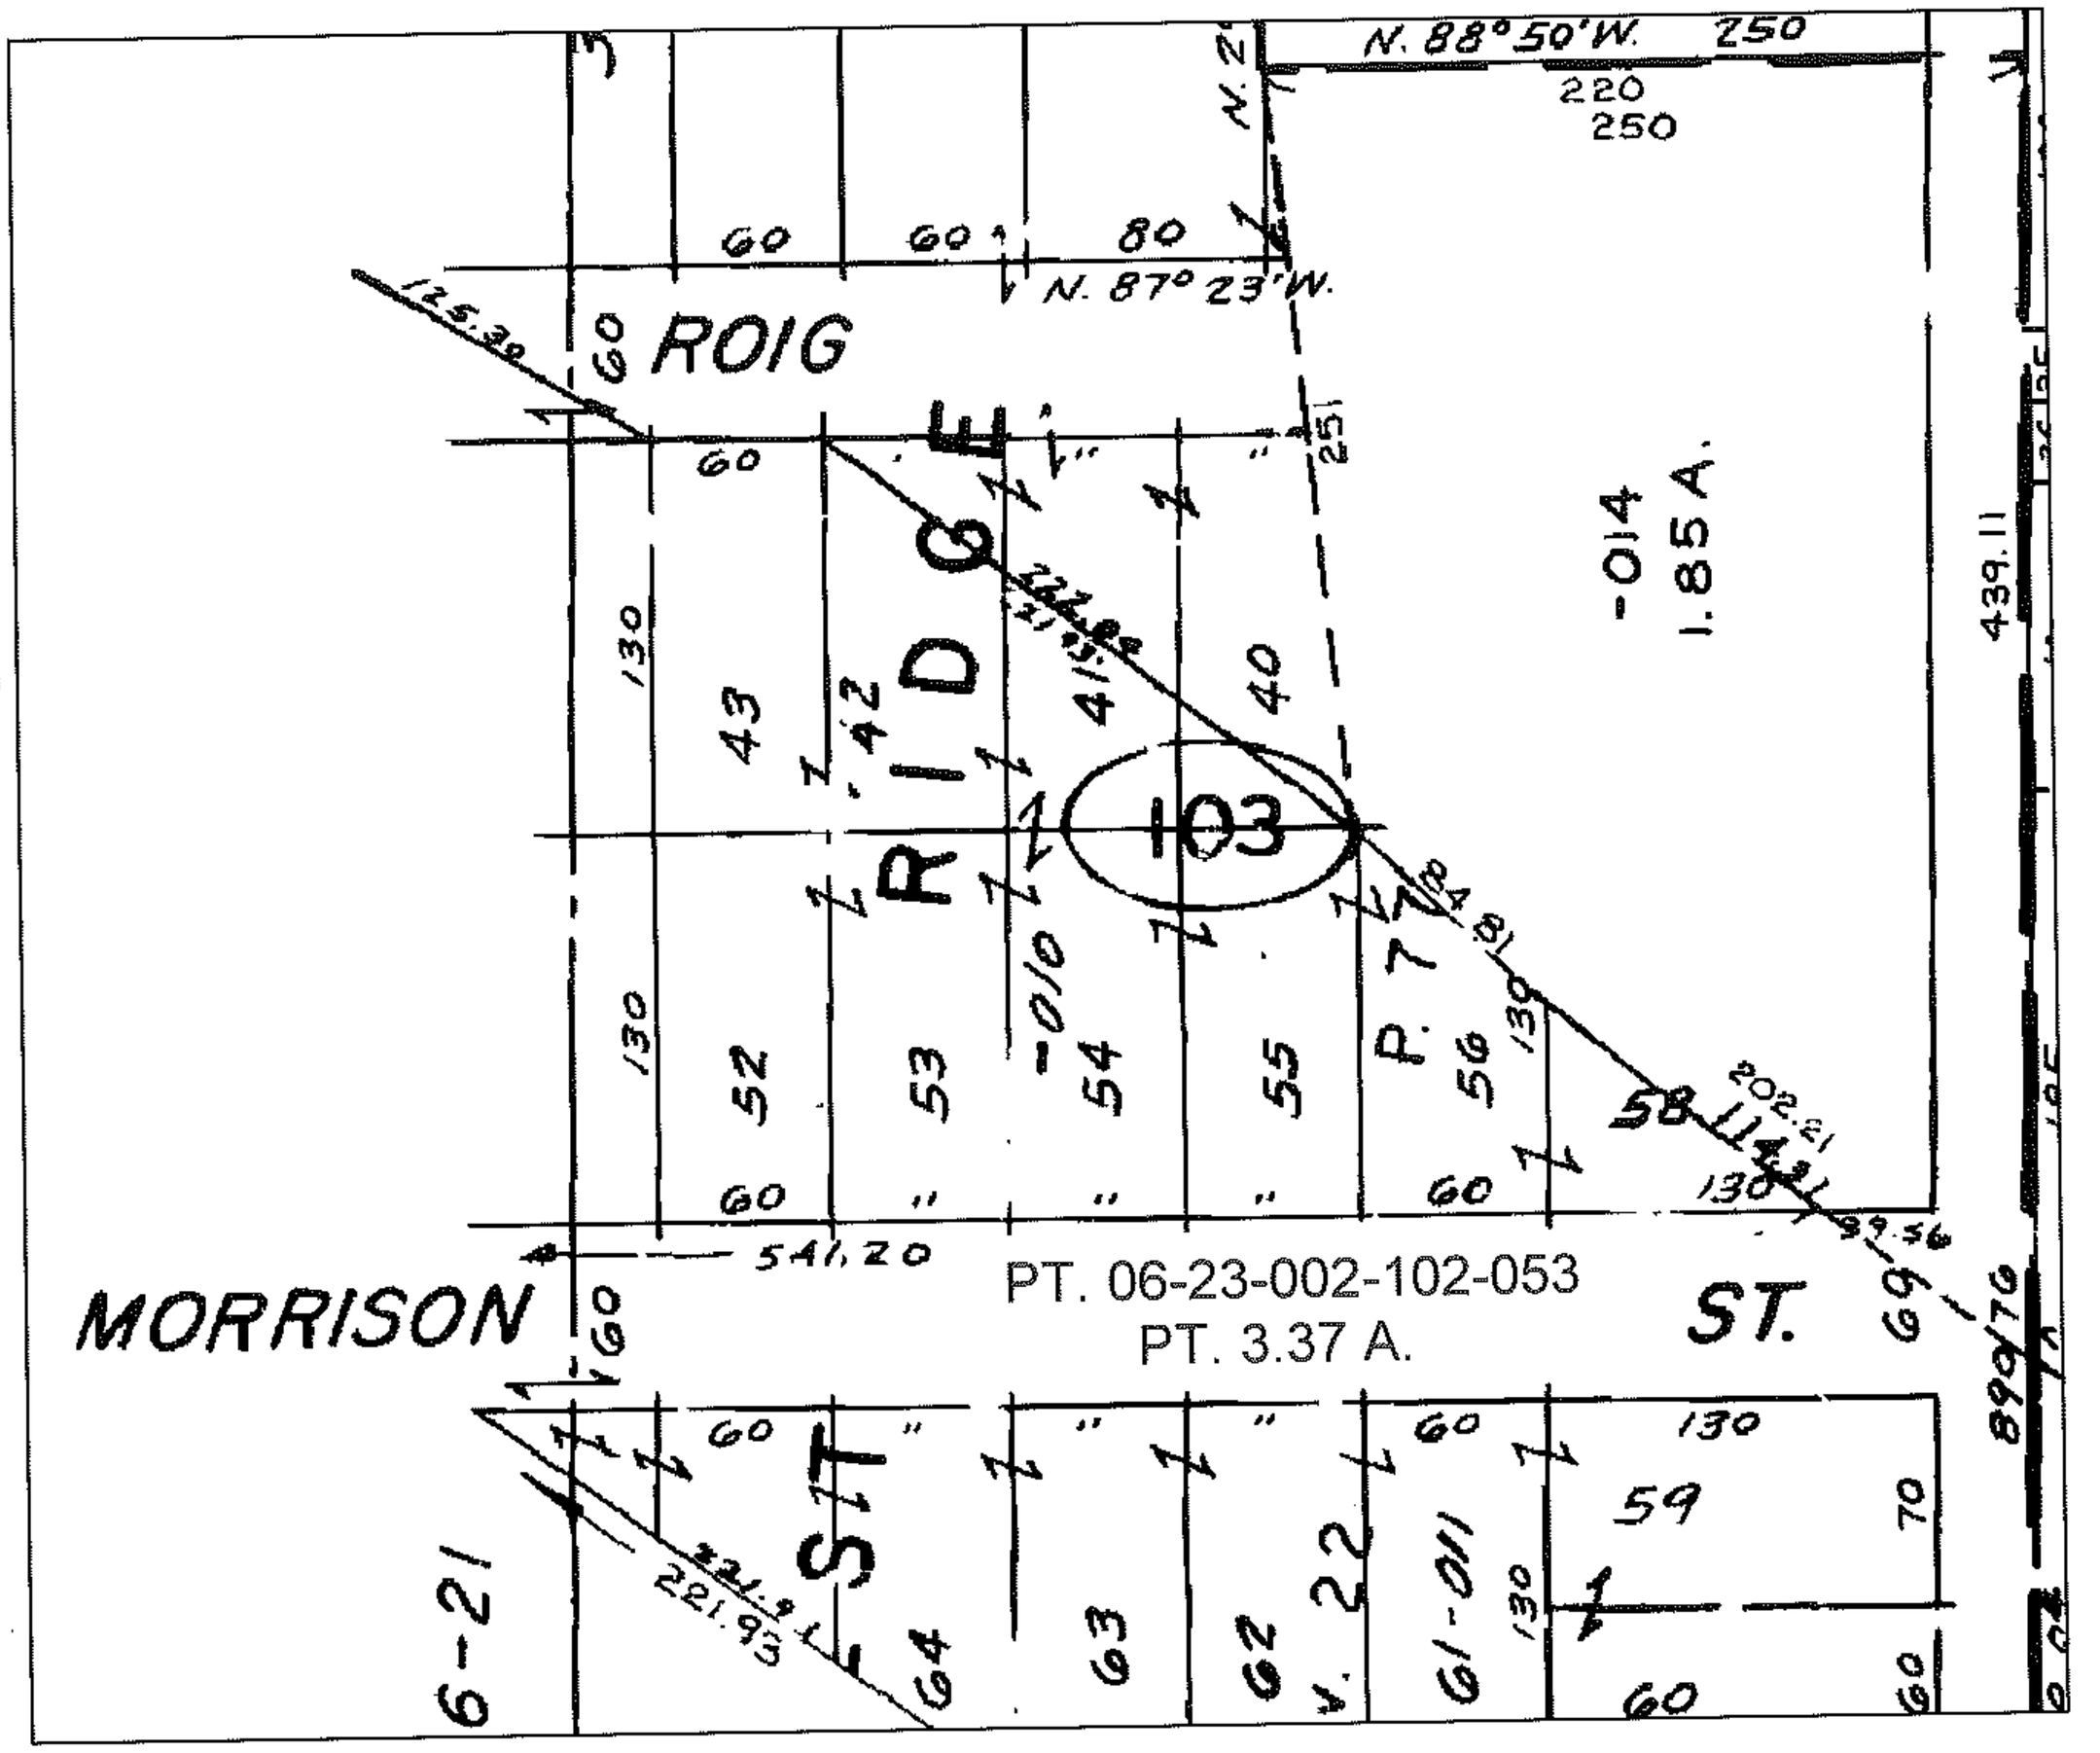

SPLITS/DEEDS PROCESSED

LORAIN COUNTY TAX MAP DEPARTMENT
226 MIDDLE AVE. ELYRIA, OHIO

SURVEYED BY: XXXXXXXXXX
CLOSURE: XXXXXX
MAP PAGE(S): 6-22
APPROVED BY: TJS DATE: 10/25/11
SCALE: 1"= 100 PRIOR INST.: DV XXXX/XXX