PARENT PARCEL: 05-00-020-000-121

CHILD PARCEL: 05-00-020-000-122, -123

STARTING POINT: CENTERLINE OF OAK POINT RD & COOPER FOSTER PARK RD

07-02386

N

W E

S

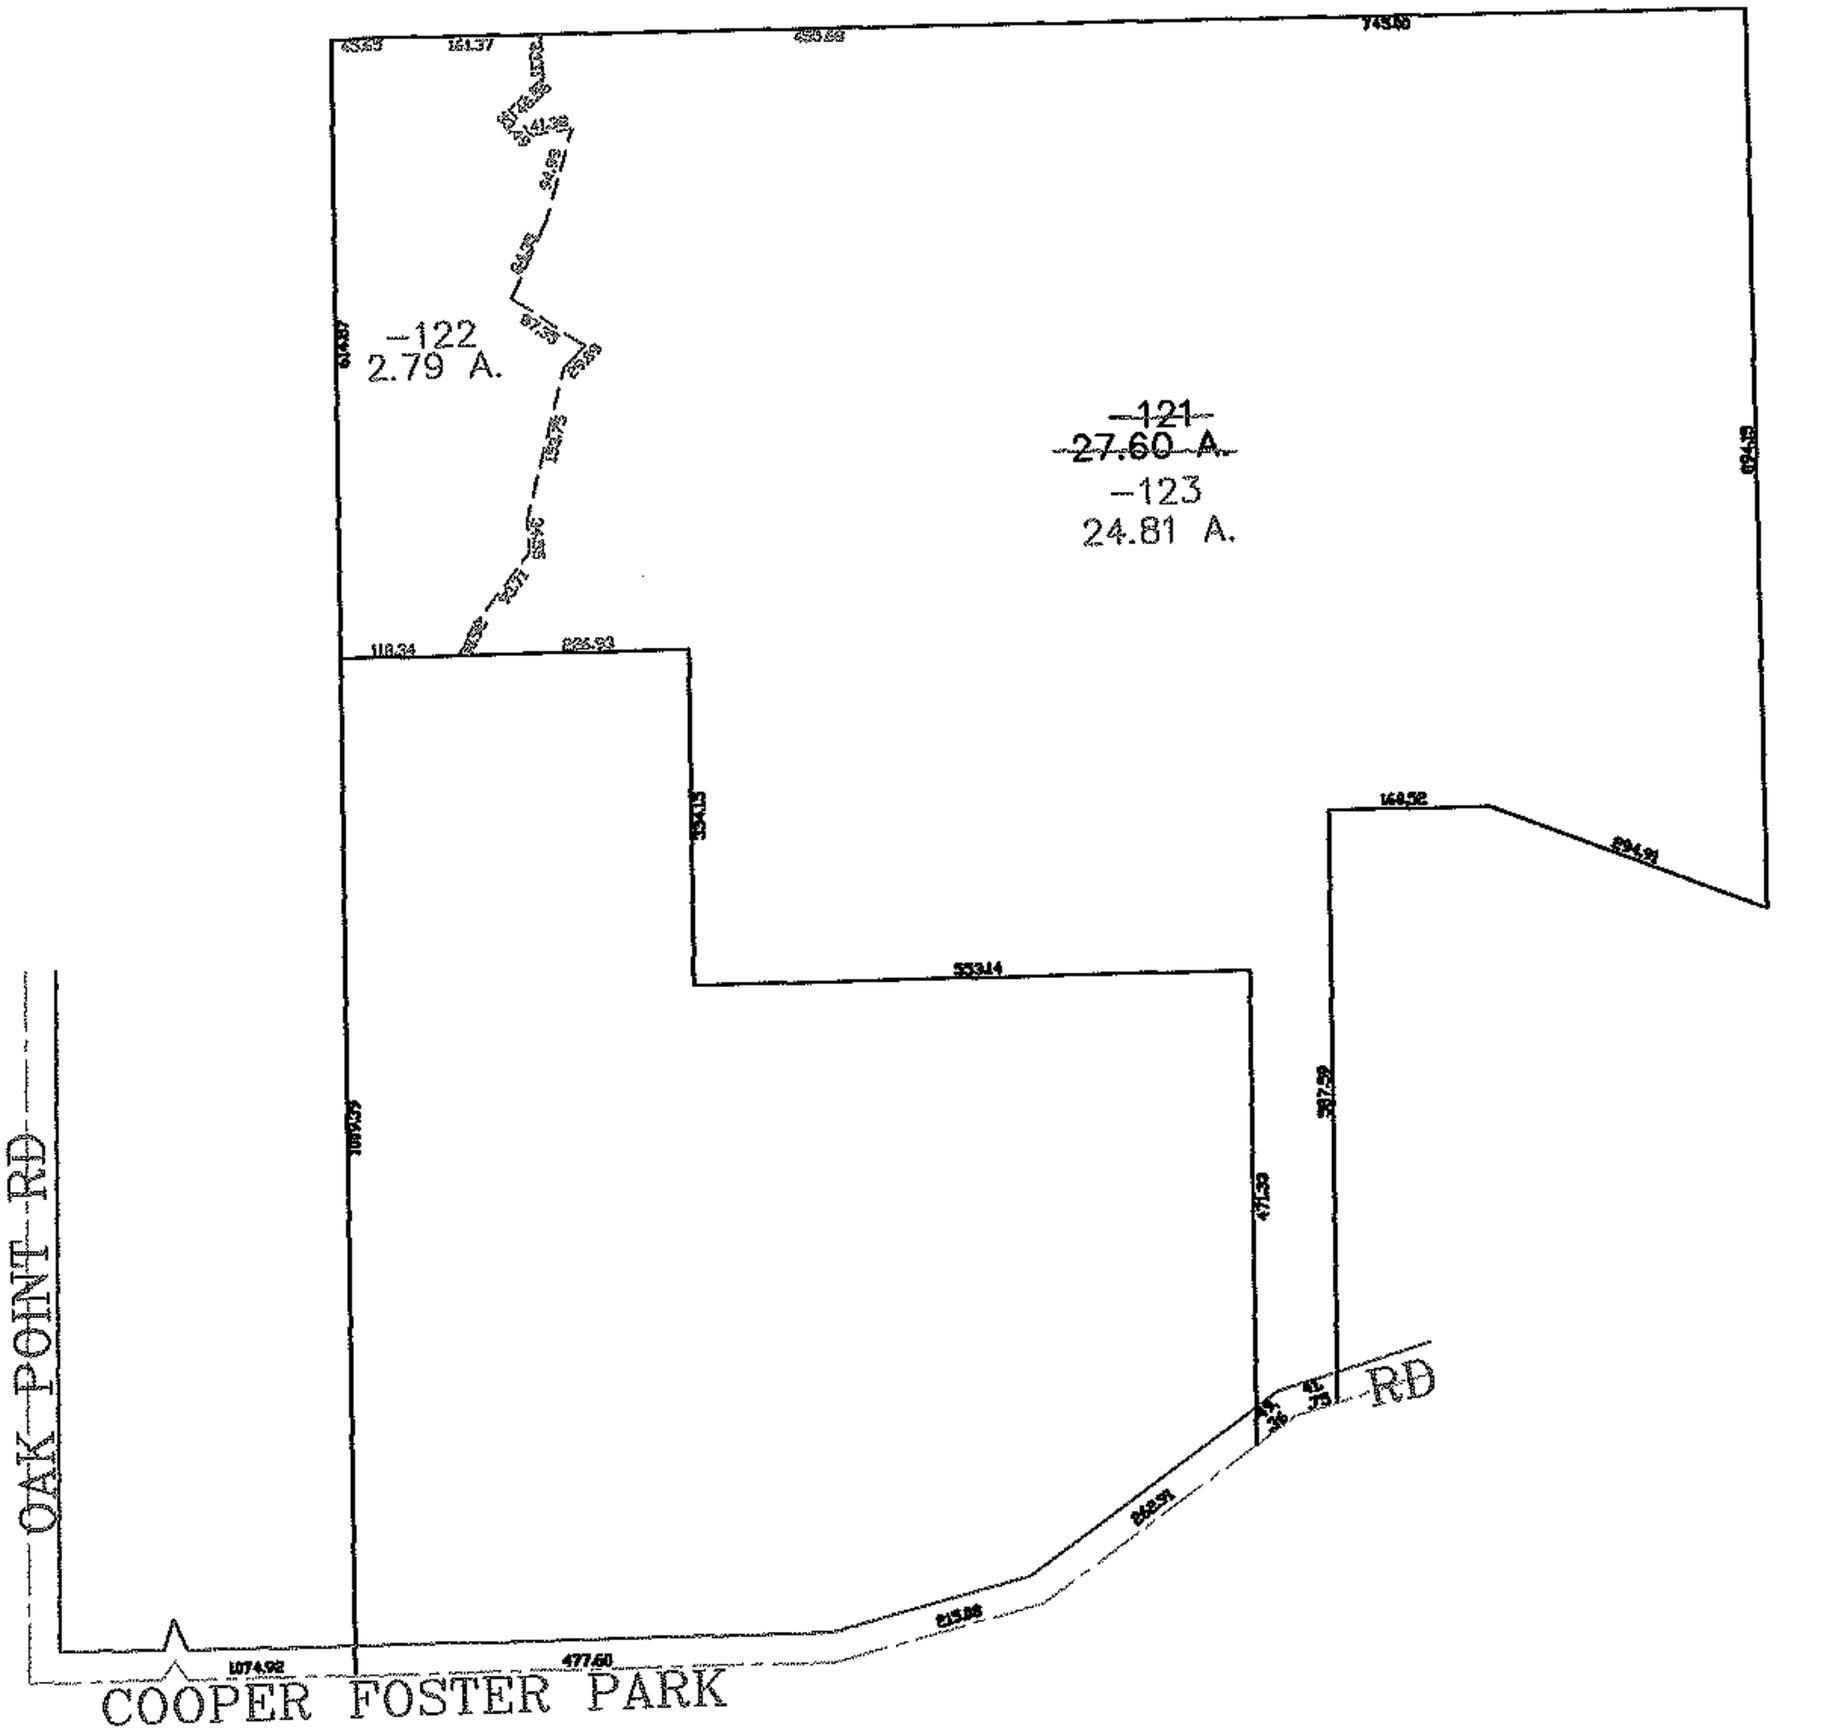

SPLITS/DEEDS PROCESSED

LORAIN COUNTY TAX MAP DEPARTMENT
226 MIDDLE AVE. ELYRIA, OHIO

SURVEYED BY: DALE HAYWOOD

CLOSURE: 0.00 : 10,000

MAP PAGE(S): 05-00-020-B

APPROVED BY: JAH DATE: 6-6-07

SCALE: 1"= 300 PRIOR INSTRUMENT: 20060148849