RASTER

PARENT PARCEL: 07-00-045-110-067
CHILD PARCEL: XX-XX-XXX-XXX-XXX
RTING POINT: MON. BOX, CL OF CASE RD.

11-02394-C

N
W E
S

ACREAGE CORRECTION

07-00-045-110-067

~~4.40 A.~~

4.59 A.

CORR. PER SURV.
THOMAS A. SIMON

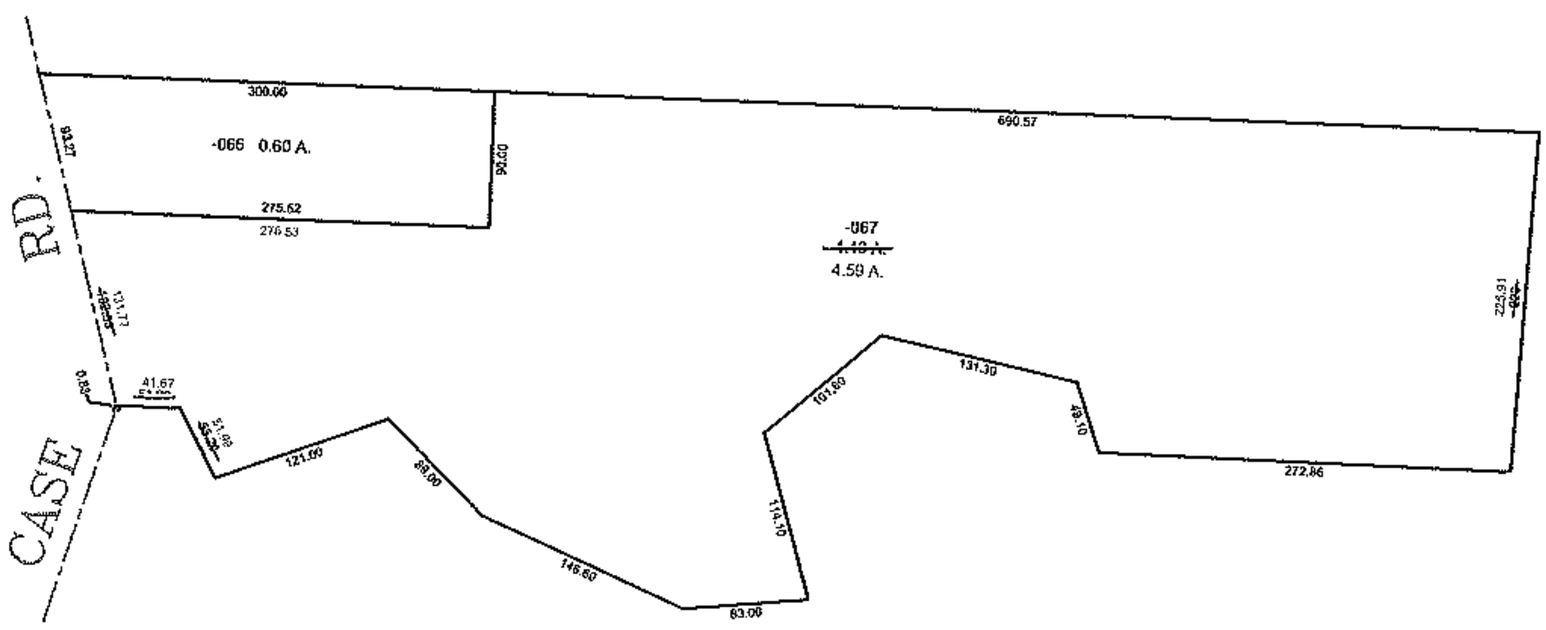

SPLITS/DEEDS PROCESSED

LORAIN COUNTY TAX MAP DEPARTMENT
226 MIDDLE AVE. ELYRIA, OHIO

SURVEYED BY: THOMAS A. SIMON
CLOSURE: 0.01 : 10,000
MAP PAGE(S): 7-00-045-B
APPROVED BY: TJS DATE: 11/28/11
SCALE: 1"= 200 PRIOR INST.: DV XXXX/XXX