RASTER

PARENT PARCEL: 09-00-066-000-032
CHILD PARCEL: 09-00-066-000-039 THRU -053
STARTING POINT: CENTERLINE OF MAPLE ST & OBERLIN NORTH RD

07-02396

N
W E
S

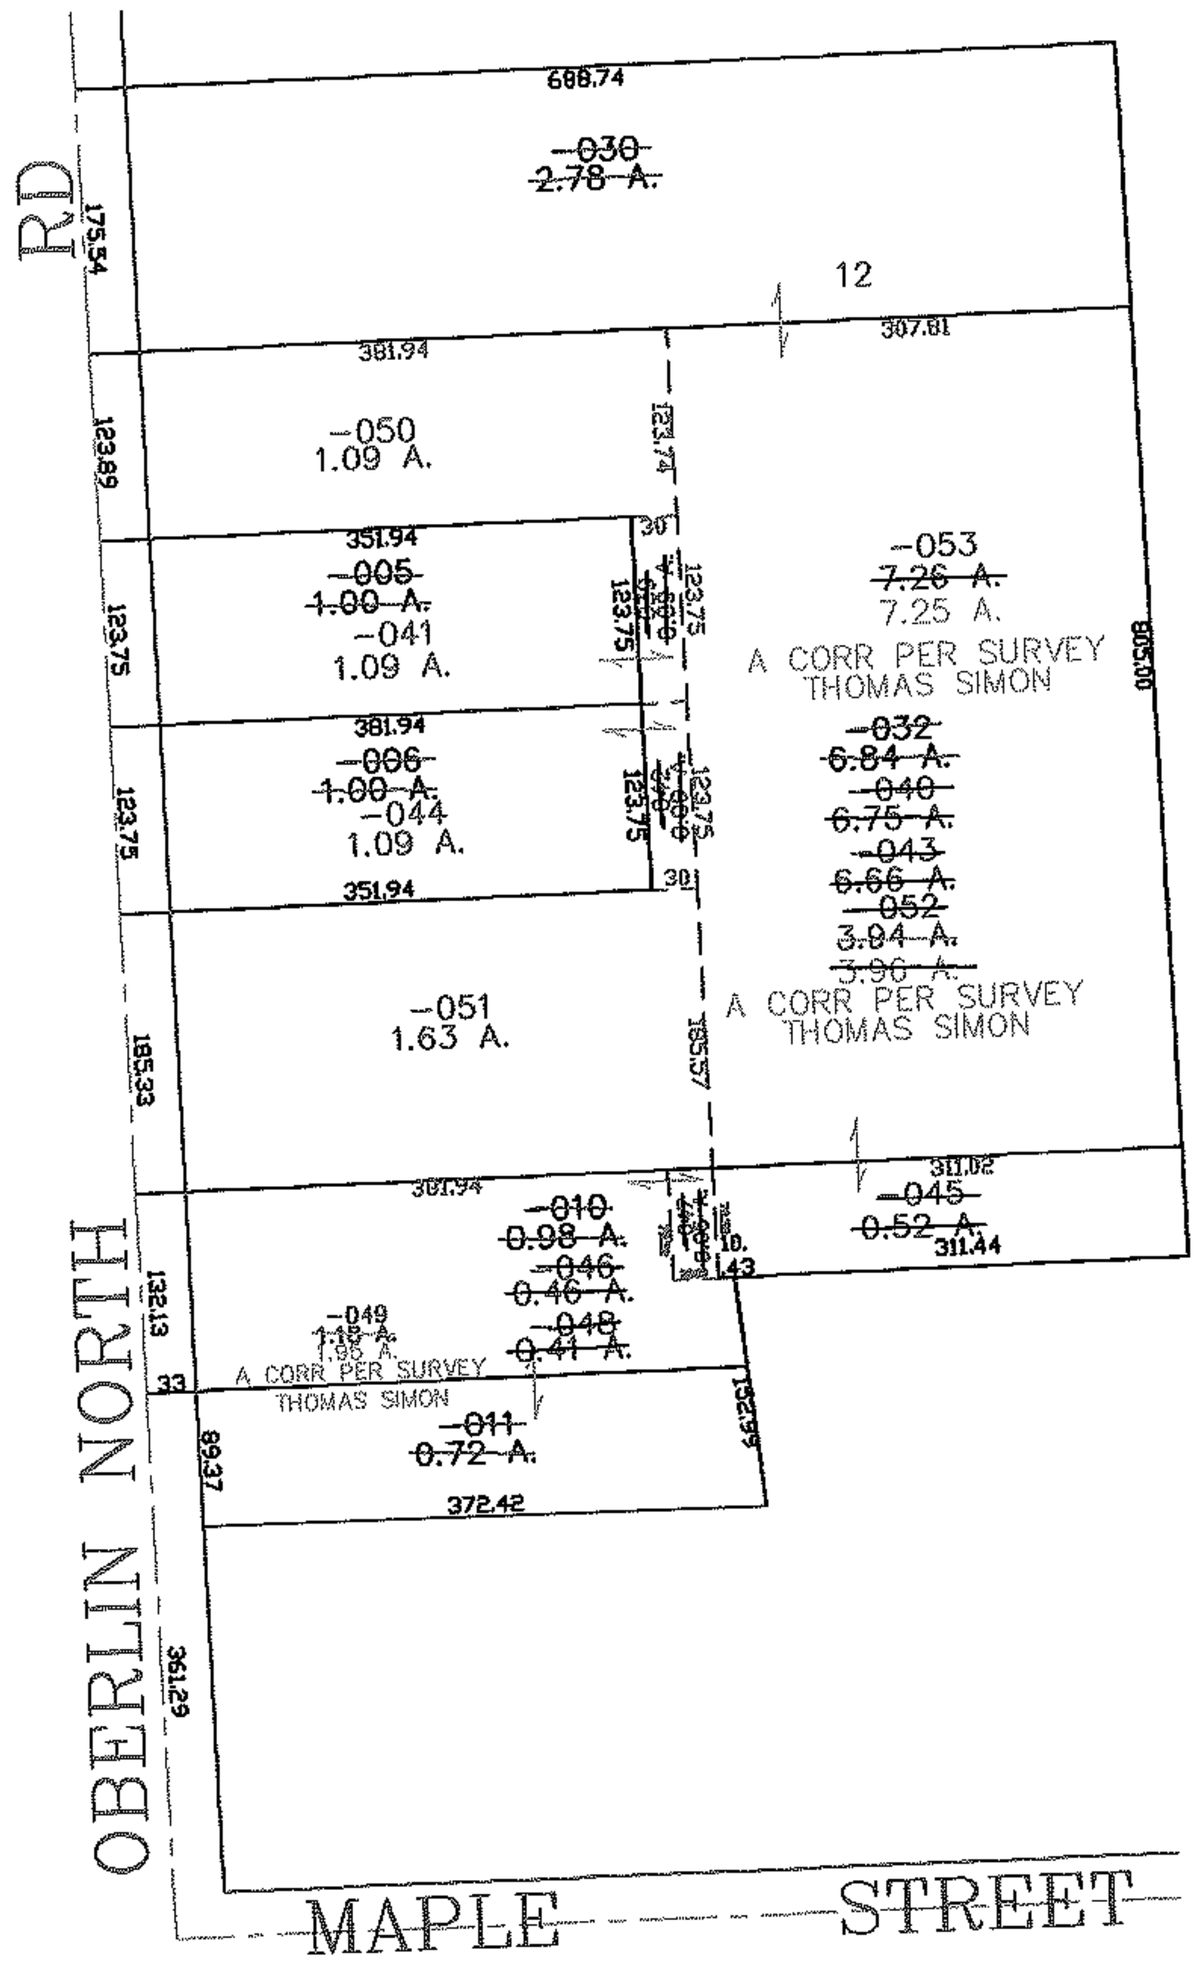

SPLITS/DEEDS PROCESSED
LORAIN COUNTY TAX MAP DEPARTMENT
226 MIDDLE AVE. ELYRIA, OHIO

SURVEYED BY: THOMAS SIMON
CLOSURE: 0.00 : 10,000
MAP PAGE(S): 09-00-066-A
APPROVED BY: JAH DATE: 6-13-07
SCALE: 1"= 200 PRIOR INSTRUMENT: OR 1248/864