RASTER

PARENT PARCEL: ADD TO DUPLICATE

CHILD PARCEL: 06-25-032-102-050

STARTING POINT: XXXXXX

11-02406-A

ADD TO DUPLICATE

06-25-032-102-050

0.06 A.

CALC.

OWNER ERNEST KORACH

PER DV 287 PG. 44

SEE PV. 49 PG. 1-2

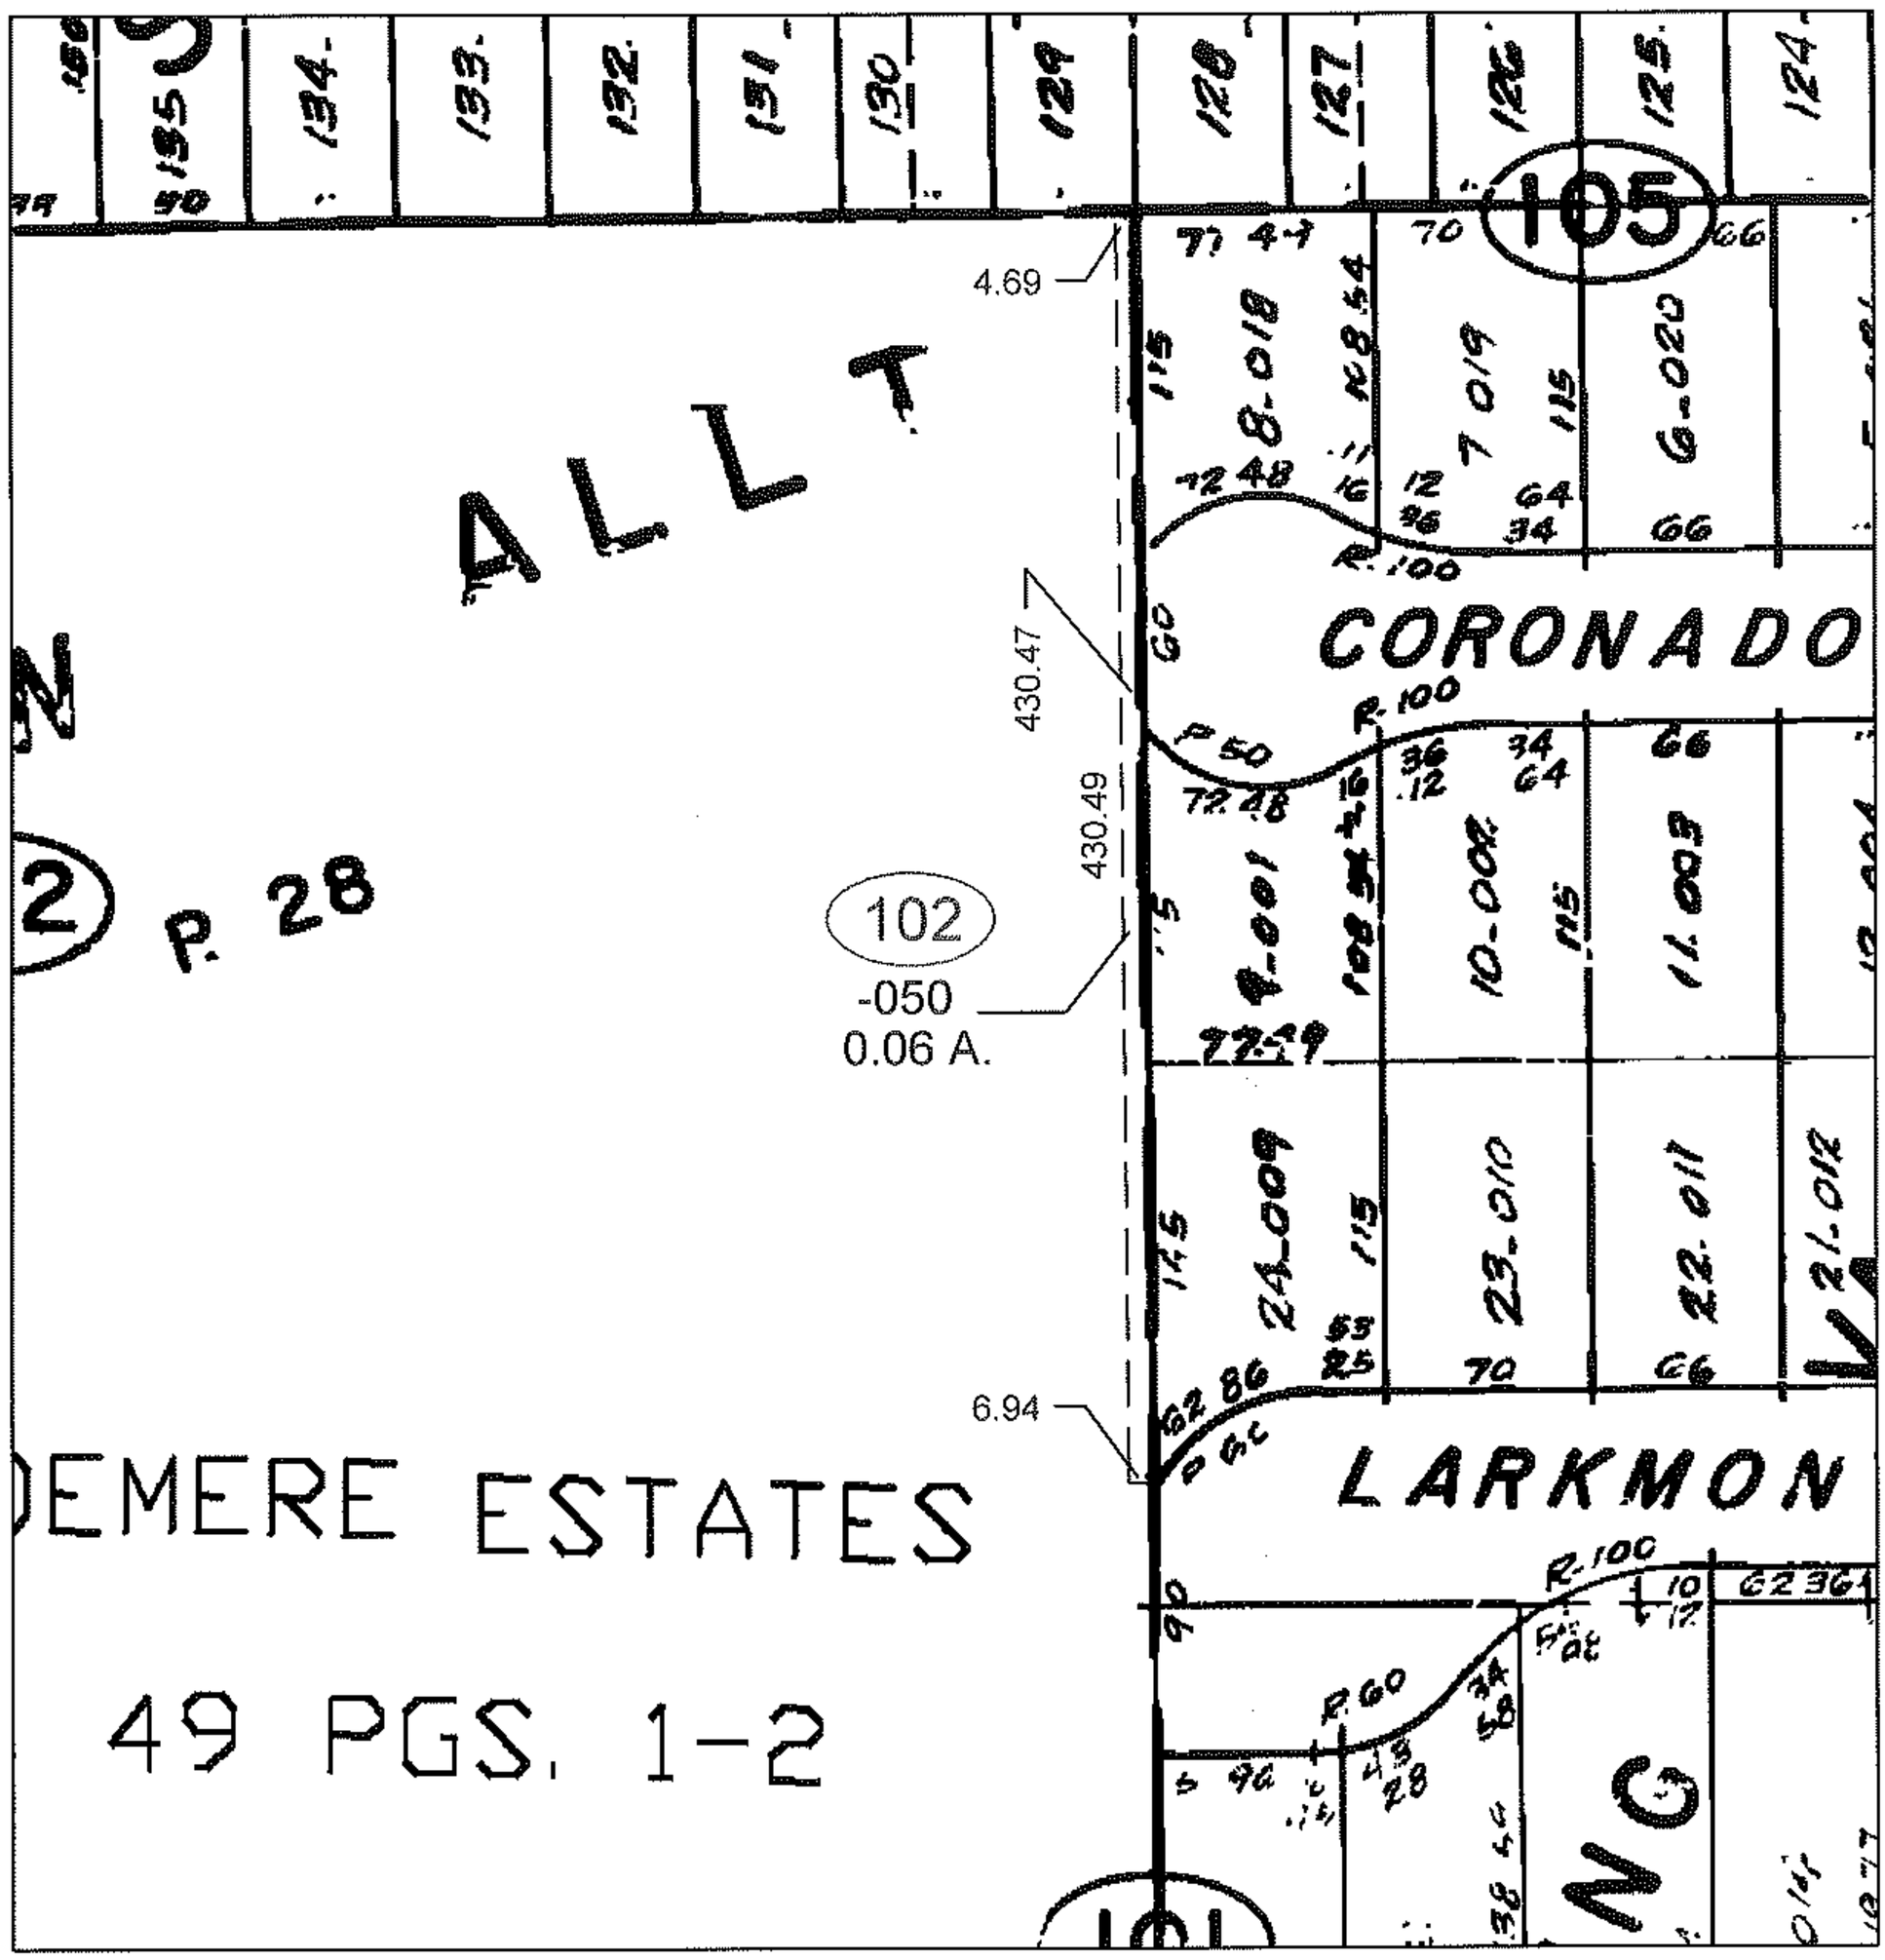


SPLITS/DEEDS PROCESSED

LORAIN COUNTY TAX MAP DEPARTMENT
226 MIDDLE AVE. ELYRIA, OHIO

SURVEYED BY: ROGER SIMON

CLOSURE: 0.01 : 10,000

MAP PAGE(S): 6-68

APPROVED BY: TJS DATE: 1/3/12

SCALE: 1"= 100 PRIOR INST.: DV 287/44