RASTER

PARENT PARCEL: 07-00-016-104-007, -034, -038, -072, -139, -141, -179

CHILD PARCEL: 07-00-016-104-181

STARTING POINT: CENTERLINE OF BAINBRIDGE RD & WAINWRIGHT RD

07-02406

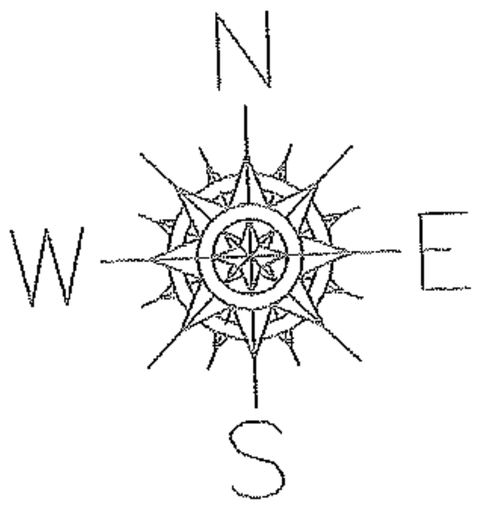

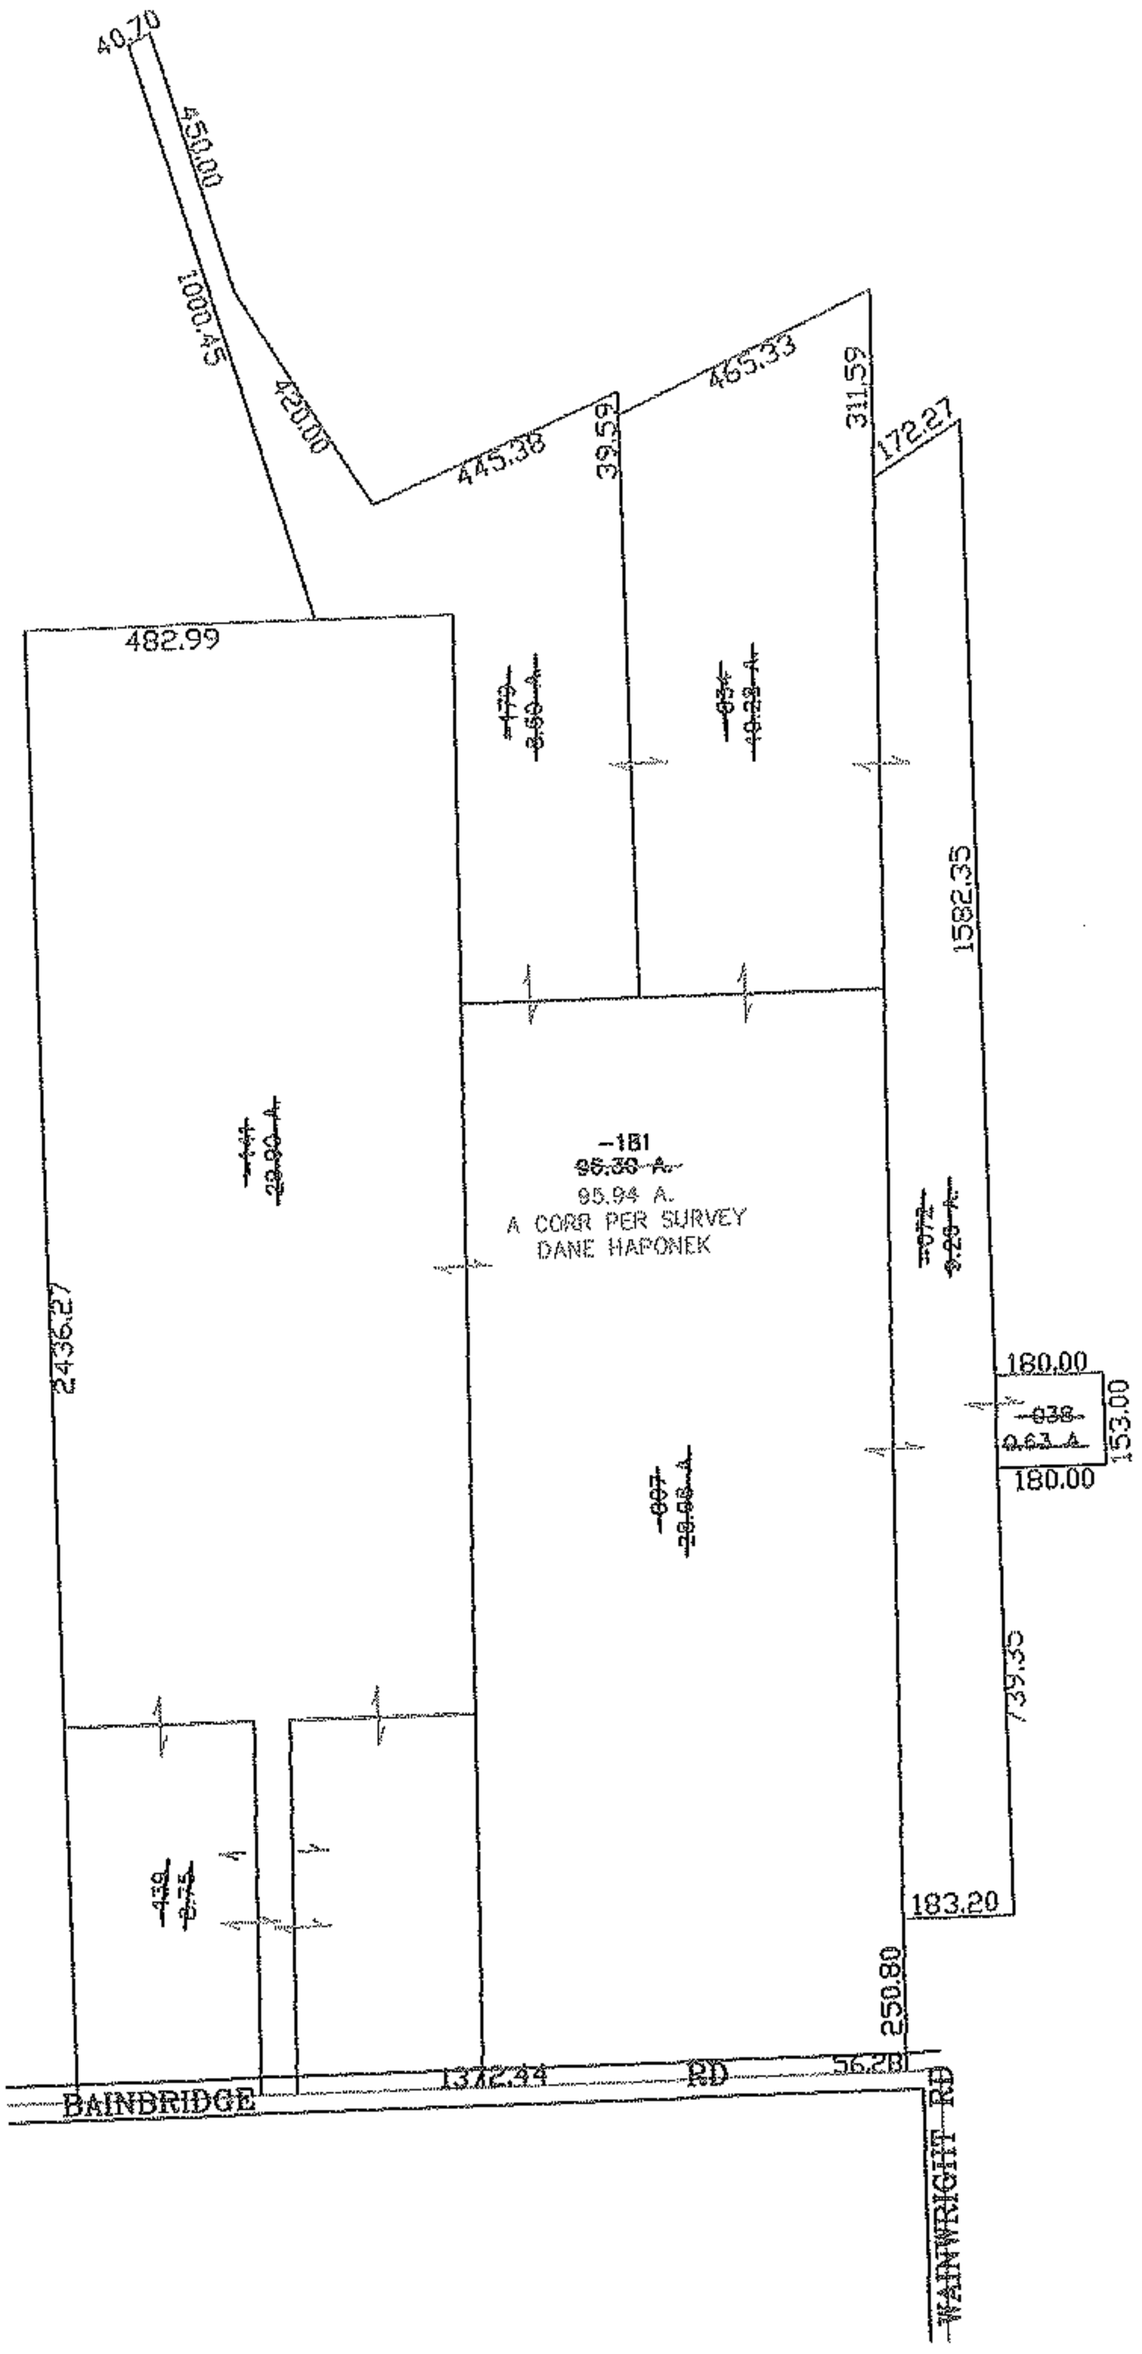

SPLITS/DEEDS PROCESSED

LORAIN COUNTY TAX MAP DEPARTMENT
226 MIDDLE AVE. ELYRIA, OHIO

SURVEYED BY: DANE HAPONEK

CLOSURE: 0.00 A: 10.000

MAP PAGE(S): 07-00-016-C

APPROVED BY: JAH DATE: 6-21-07

SCALE: 1"= 500 PRIOR INSTRUMENT: DV 715/245