RASTER

07-02408

PARENT PARCEL: 05-00-015-000-080, -079 05-00-016-101-170, -169

CHILD PARCEL: 05-00-015-000-083 THRU -085, 05-00-016-101-179 THRU 181

STARTING POINT: CENTERLINE OF MIDDLE RIDGE RD & PYLE SOUTH AMHERST RD

N

W E

S

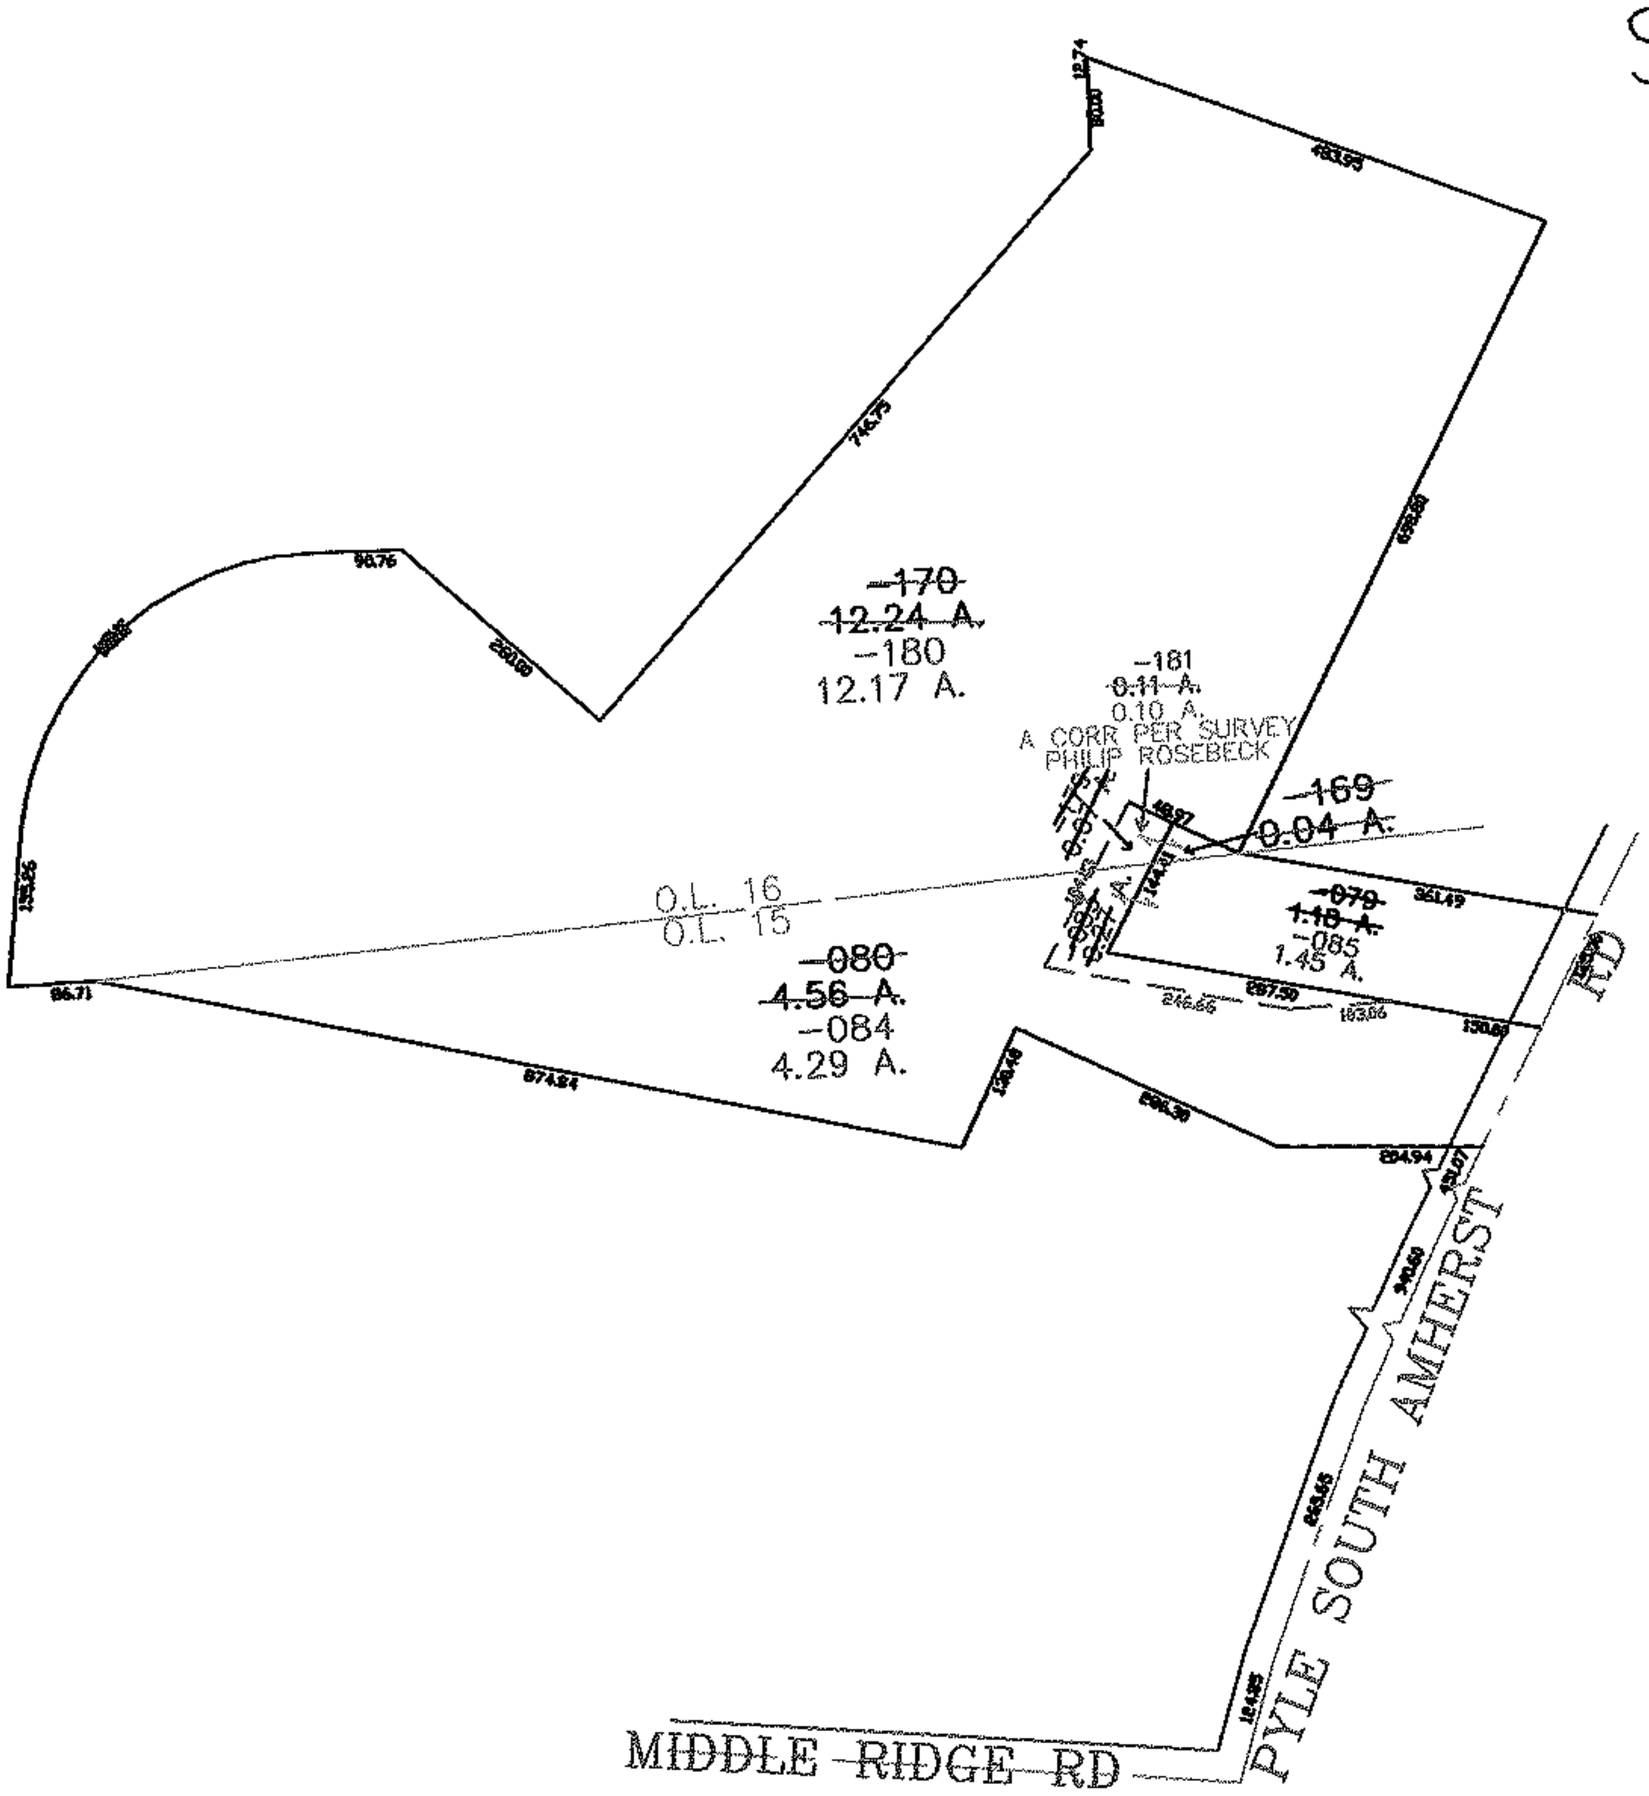

SPLITS/DEEDS PROCESSED

LORAIN COUNTY TAX MAP DEPARTMENT
226 MIDDLE AVE. ELYRIA, OHIO

SURVEYED BY: PHILIP ROSEBECK

CLOSURE: 0.00 : 10,000

MAP PAGE(S): 05-00-015-A

APPROVED BY: JAH DATE: 6-21-07

SCALE: 1"= 300 PRIOR INSTRUMENT: DV 1262/324