PARENT PARCEL: 11-00-096-000-039 & 11-00-097-000-031

CHILD PARCEL: 11-00-096-000-042 & -043

STARTING POINT: CL OF CAPEL RD. & CL OF GRAFTON RD.

12-02443-C

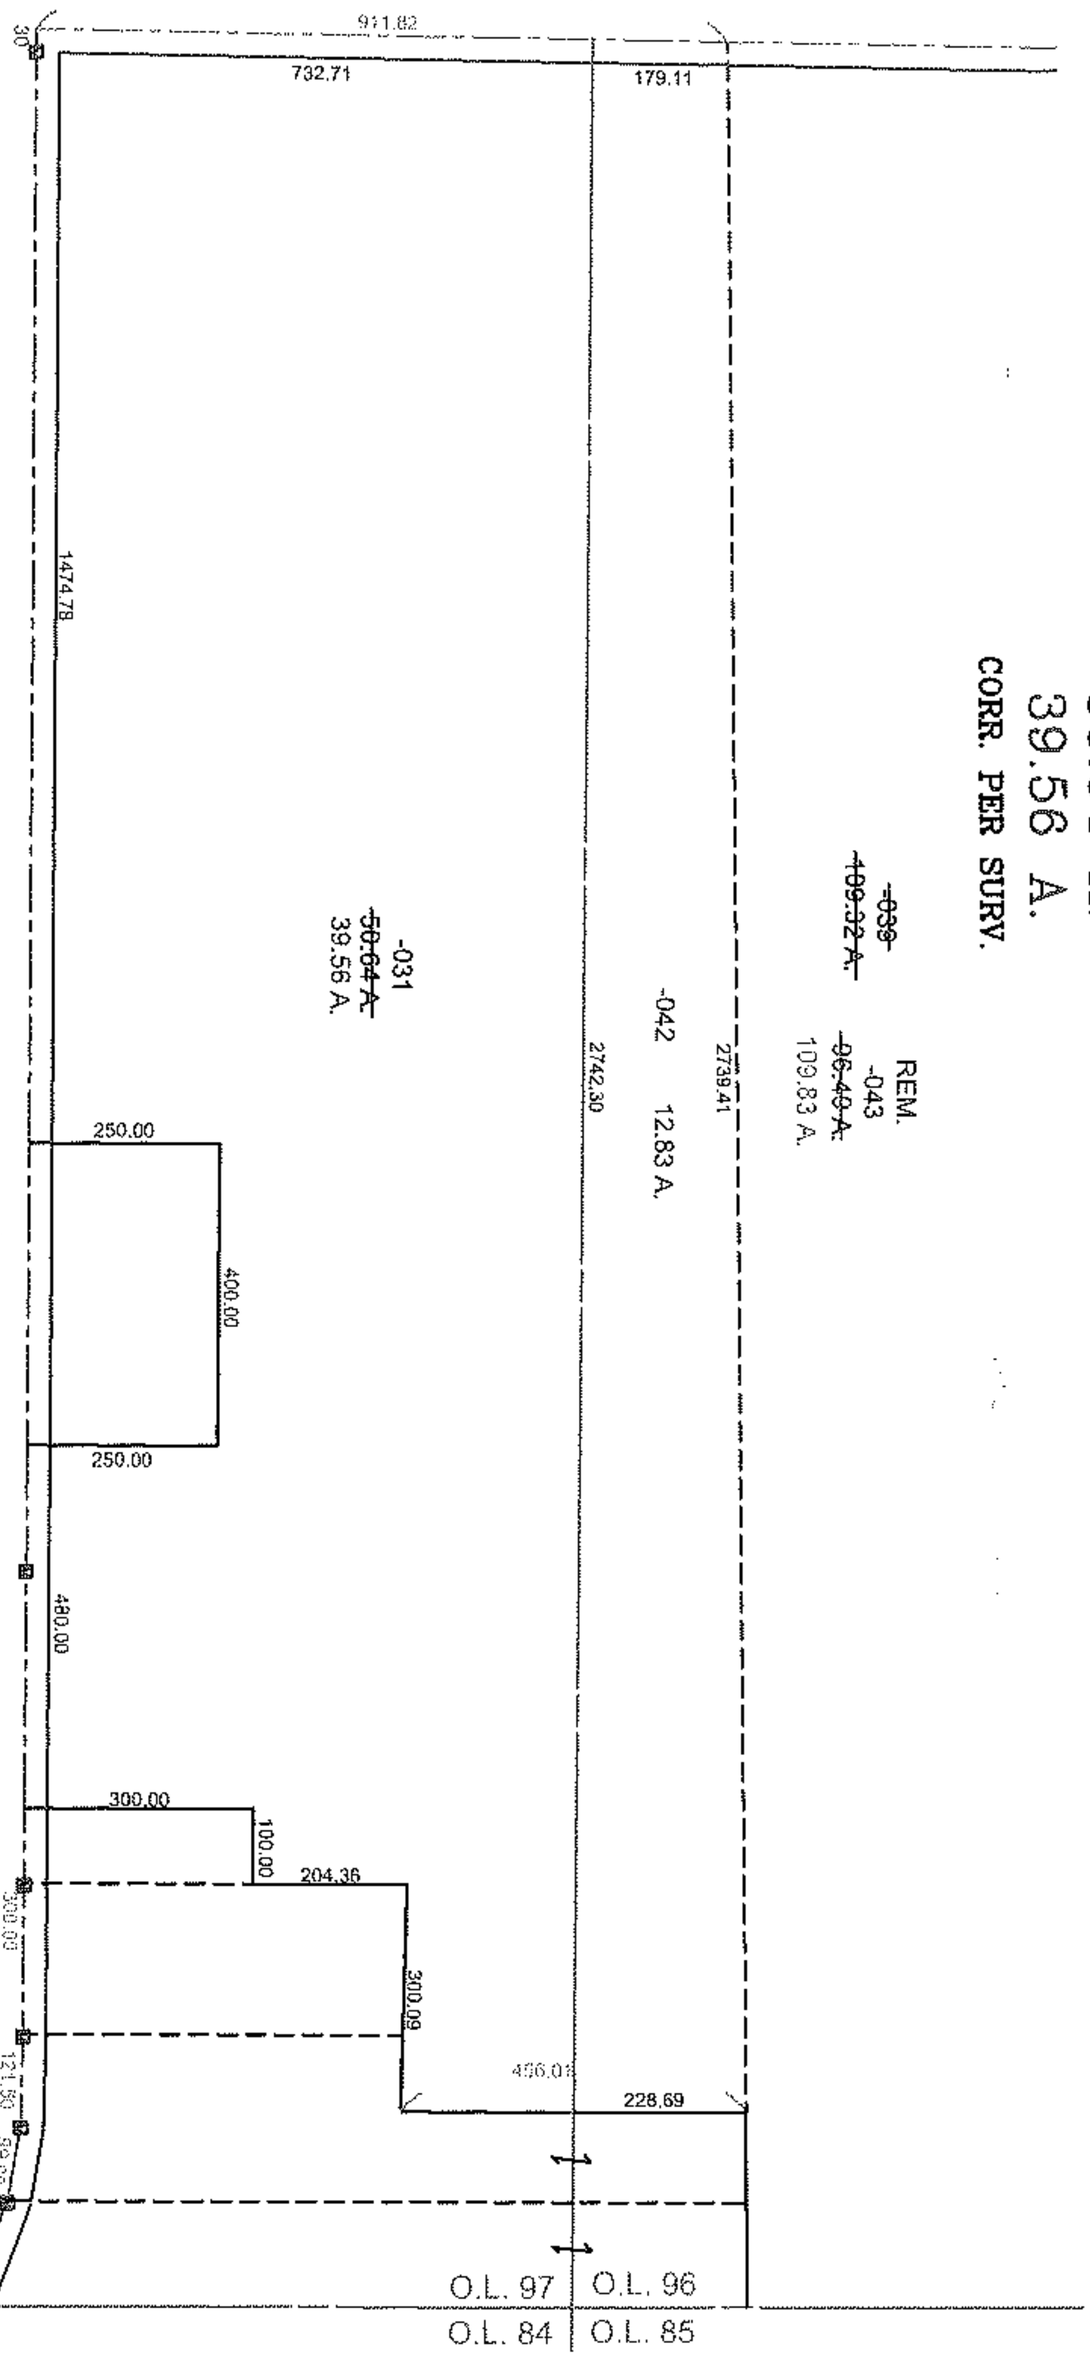

MAP CORR./SPLIT

~~11-00-096-000-039~~

~~109.32 A.~~

11-00-096-000-042

12.83 A.

ACREAGE CORR.

~~11-00-097-000-031~~

~~50.64 A.~~

39.56 A.

CORR. PER SURV.

	REM.
~~-039~~	-043
~~109.32 A.~~	~~96.49 A.~~
	109.83 A.

-031
~~50.64 A.~~
39.56 A.

-042 12.83 A.

REMAINDER SURVEY BEFORE NEXT TRANSFER

11-00-096-000-043

~~96.49 A.~~

109.83 A.

CORR. PER DEED
DV 1354/667
DV 1049/609

DEED SHOULD HAVE NEVER GONE TO SOUTH LINE OF O.L. 96

3 LEGALS 1 P.P.N

PRIOR INST.: DV 537/452

PRIOR INST.: DV 1173/116

SPLITS/DEEDS PROCESSED

LORAIN COUNTY TAX MAP DEPARTMENT
226 MIDDLE AVE. ELYRIA, OHIO

SURVEYED BY: CHRISTOPHER J. DEMPSEY

CLOSURE: 0.01 : 10,000

MAP PAGE(S): 11-E & 11-00-096-A & B

APPROVED BY: TJS DATE: 2/15/12

SCALE: 1"= 400