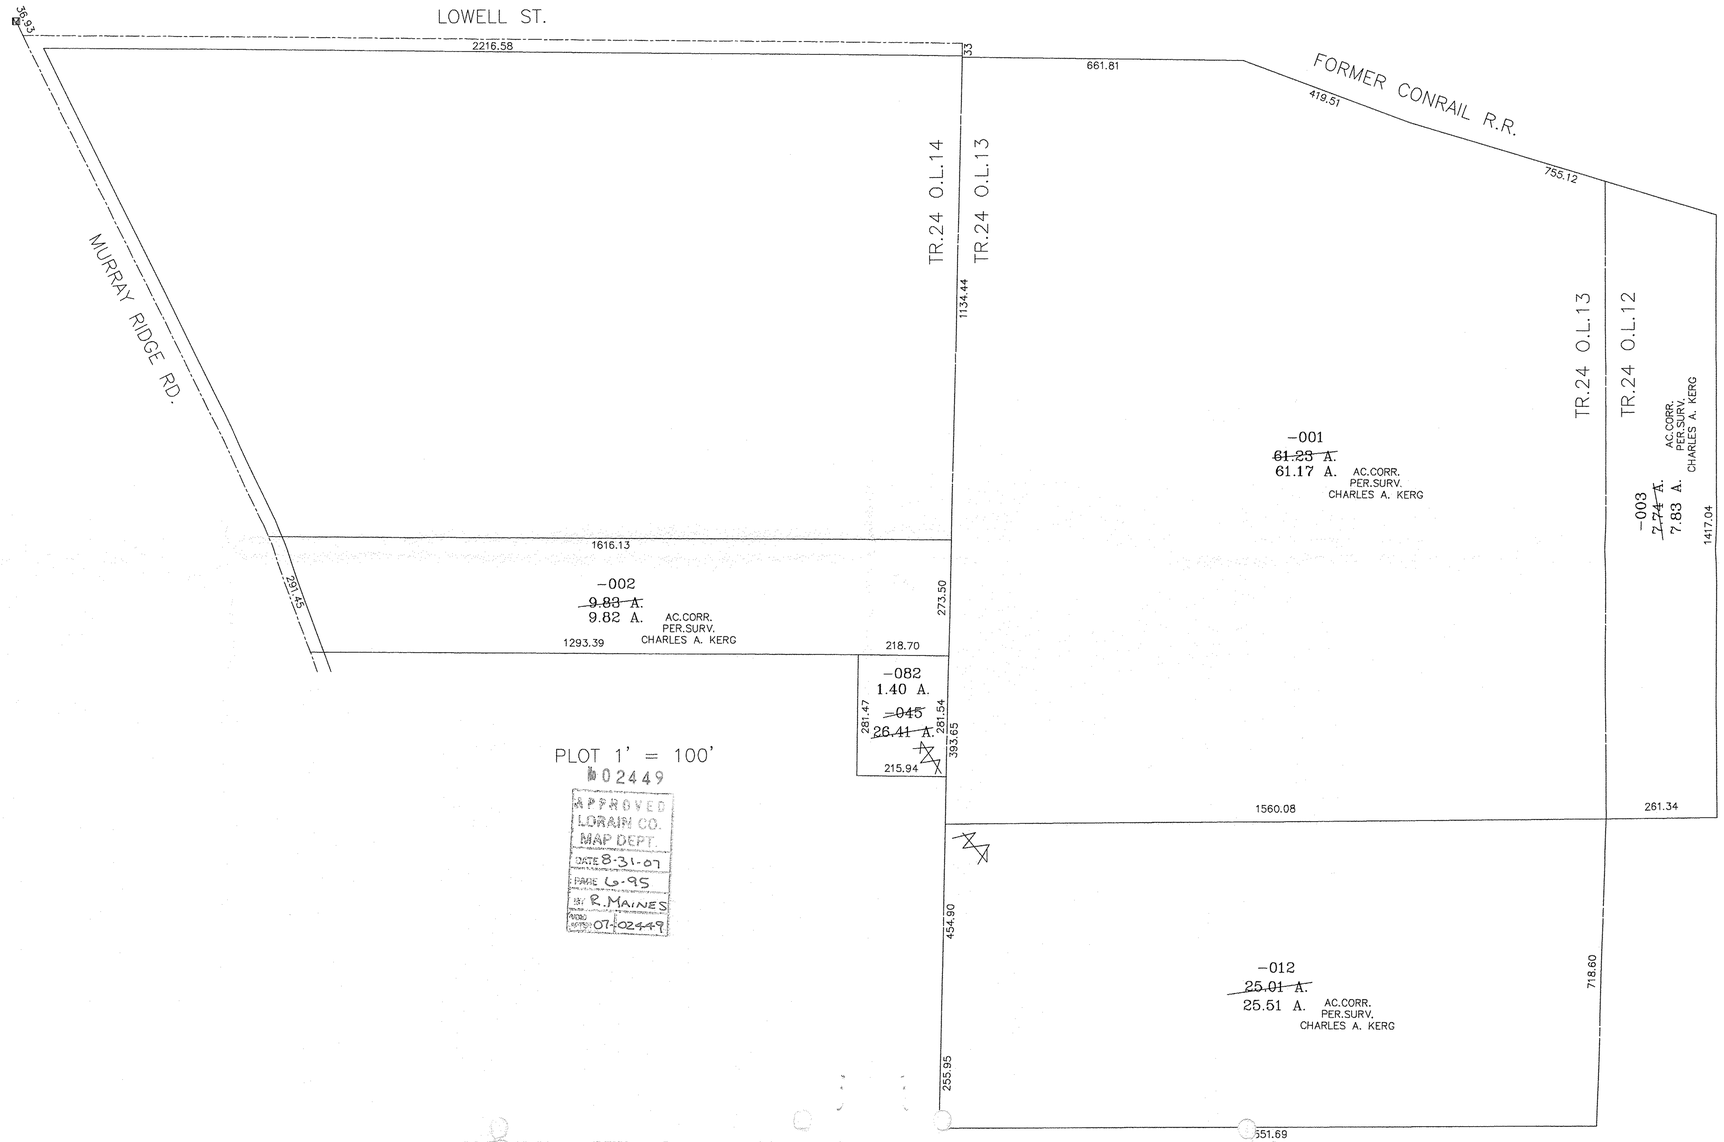
LOWELL ST.
36.93
2216.58
33
661.81
FORMER CONRAIL R.R.
419.51
755.12
MURRAY RIDGE RD.
TR.24 O.L.14
TR.24 O.L.13
1134.44
TR.24 O.L.13
TR.24 O.L.12
-001
~~61.23 A.~~
61.17 A.
AC.CORR.
PER.SURV.
CHARLES A. KERG
-003
~~7.74 A.~~
7.83 A.
AC.CORR.
PER.SURV.
CHARLES A. KERG
1417.04
1616.13
291.45
-002
~~9.83 A.~~
9.82 A.
AC.CORR.
PER.SURV.
CHARLES A. KERG
1293.39
273.50
218.70
-082
1.40 A.
~~-045~~
~~26.41 A.~~
281.47
281.54
393.65
215.94
PLOT 1' = 100'
02449
APPROVED
LORAIN CO.
MAP DEPT.
DATE 8-31-07
PAGE 6-95
BY R. MAINES
07-02449
1560.08
261.34
454.90
-012
~~25.01 A.~~
25.51 A.
AC.CORR.
PER.SURV.
CHARLES A. KERG
718.60
255.95
551.69