RASTER

PARENT PARCEL: ADD TO DUP.
CHILD PARCEL: 03-00-055-116-035 THRU -037, 03-00-055-117-030 THRU -032
STARTING POINT: NORTH LINE OF COLORADO AVE.

12-02450-V

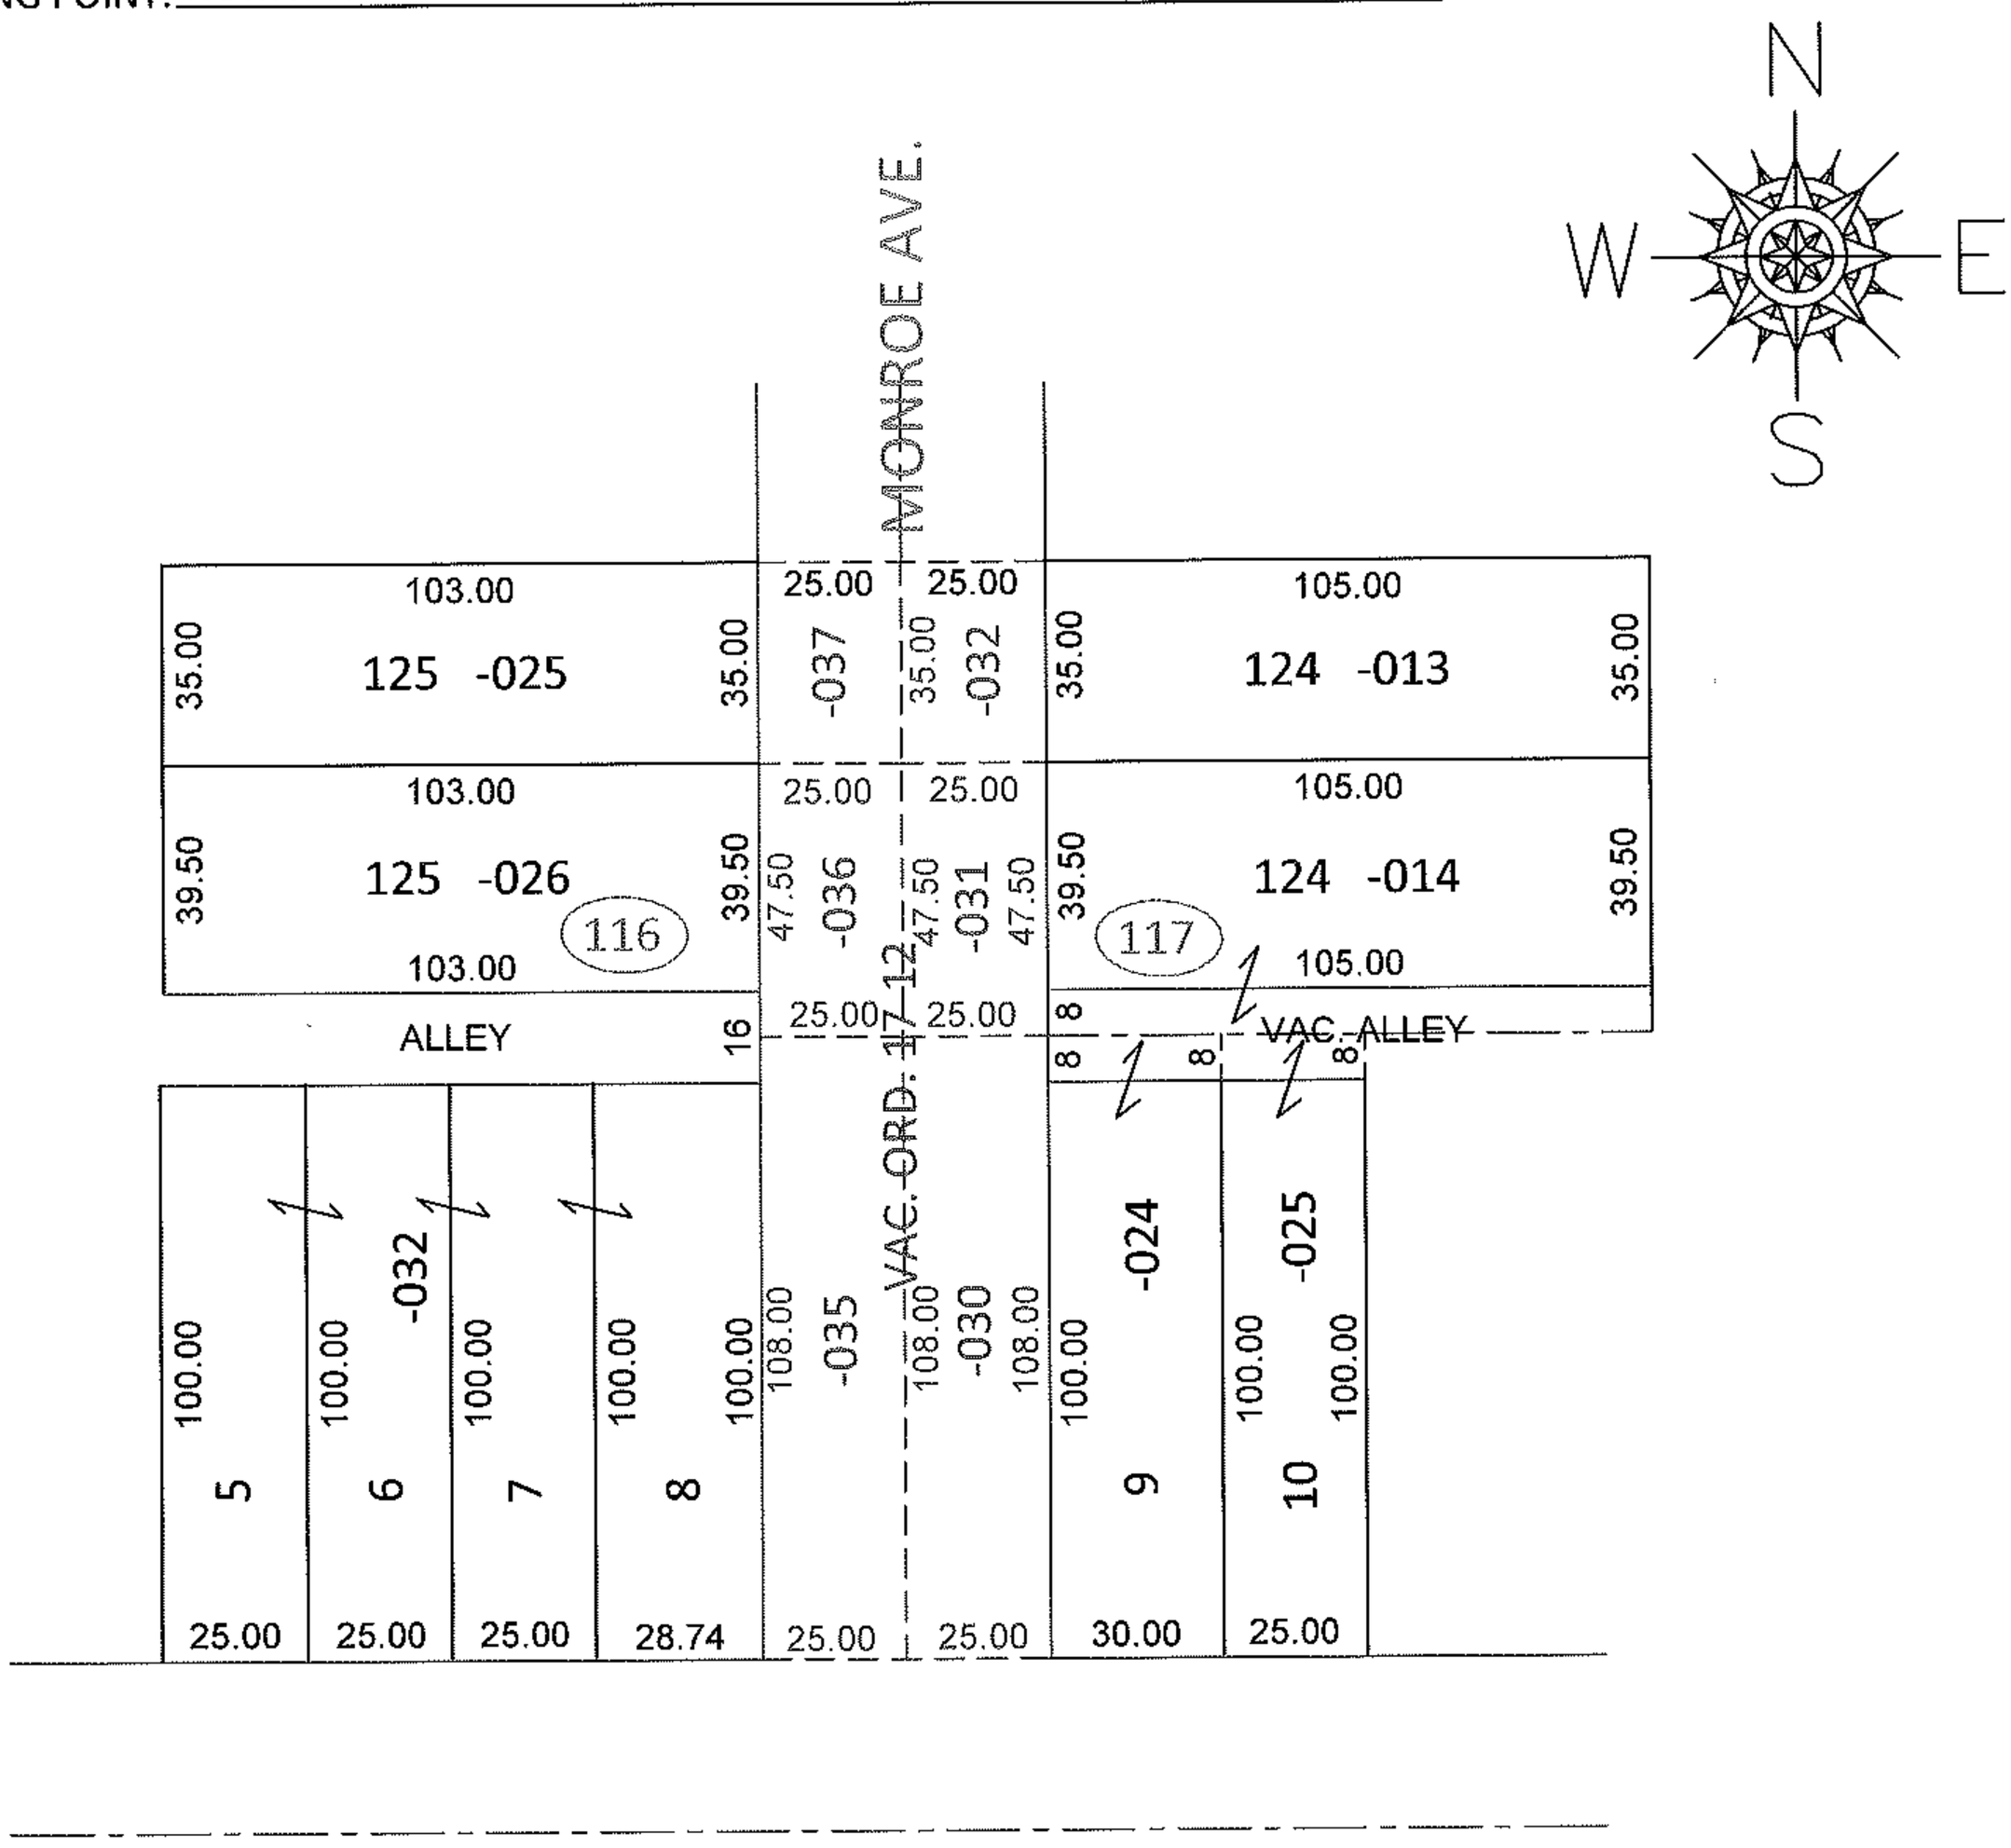

ADD TO DUP.

03-00-055-116-035 25 X 108	03-00-055-116-036 25 X 47.50	03-00-055-116-037 25 X 35
03-00-055-117-030 25 X 108	03-00-055-117-031 25 X 47.50	03-00-055-117-032 25 X 35

PER VACATION ORDINANCE 17-12

SPLITS/DEEDS PROCESSED

LORAIN COUNTY TAX MAP DEPARTMENT
226 MIDDLE AVE. ELYRIA, OHIO

SURVEYED BY: N/A
CLOSURE: N/A
MAP PAGE(S): 3-00-055-A
APPROVED BY: RRM DATE: 2-29-12
SCALE: 1"= 50' PRIOR INST.: ORD 17-12