RASTER

PARENT PARCEL: 12-00-044-000-061, -060 12-00-057-000-054, -053

CHILD PARCEL: 12-00-057-000-057 THRU -059

STARTING POINT: CENTERLINE OF FOLLEY RD & O.L. 57

07-02456

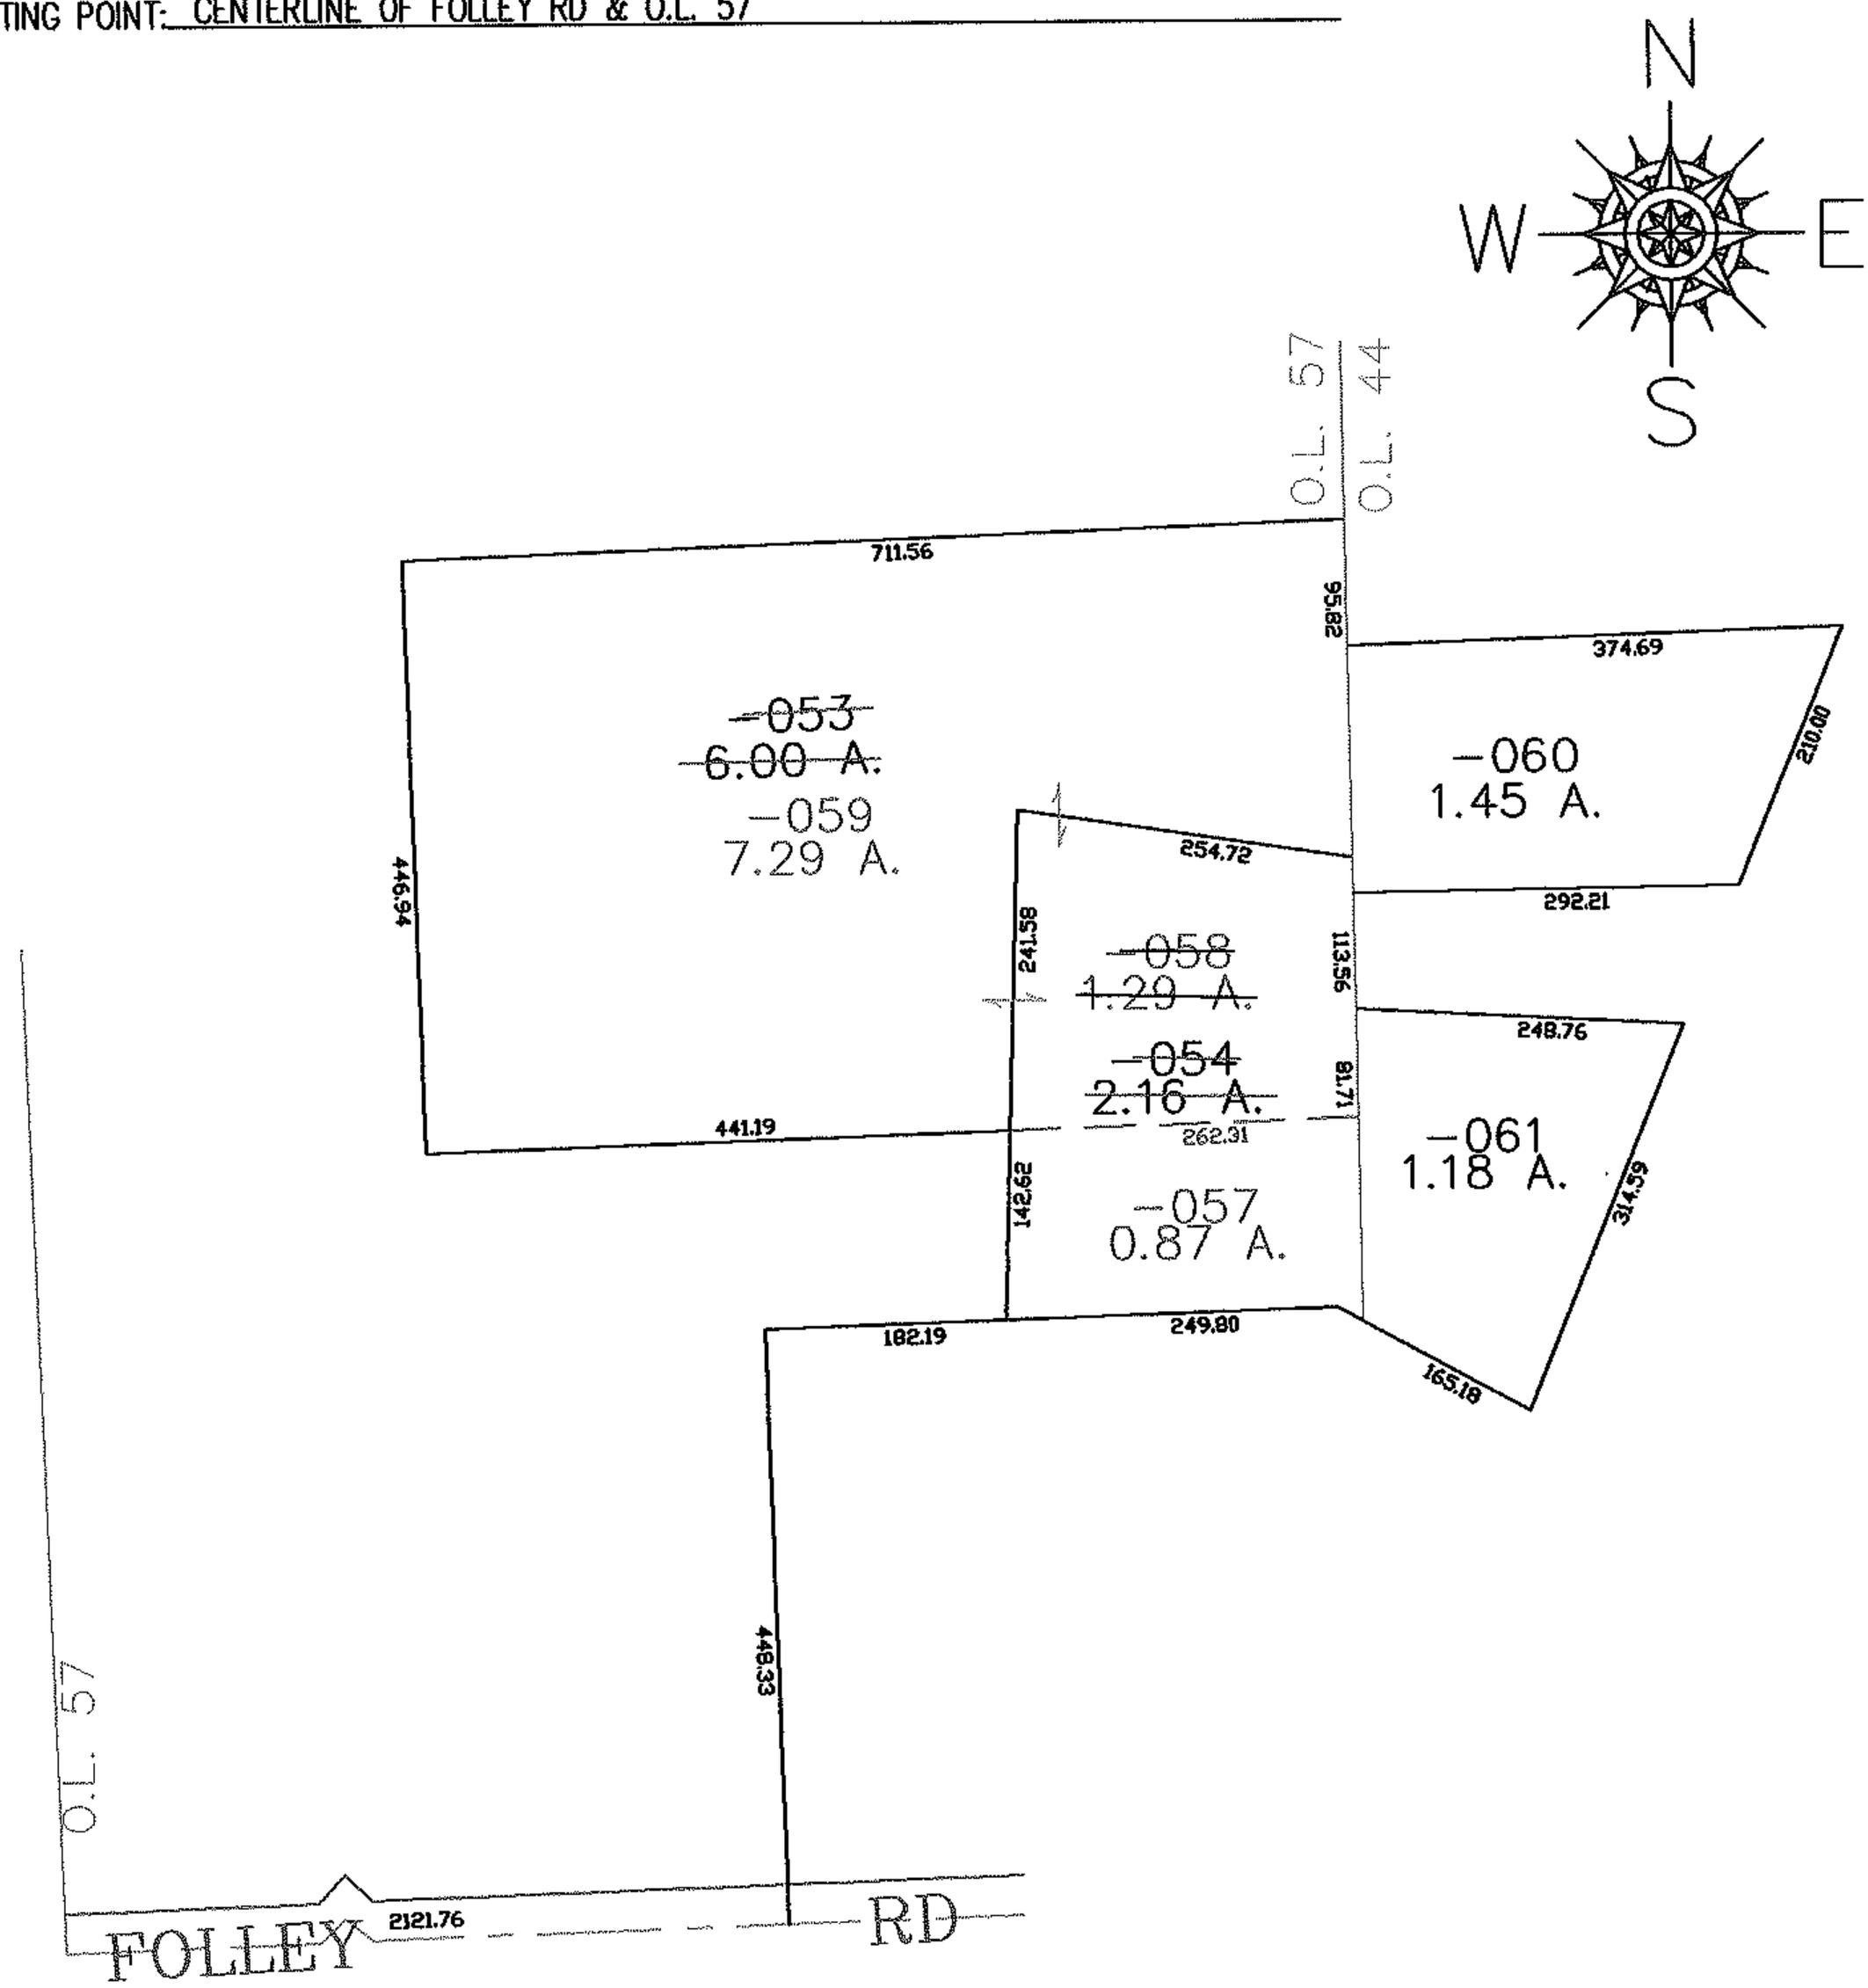

SPLITS/DEEDS PROCESSED

LORAIN COUNTY TAX MAP DEPARTMENT
226 MIDDLE AVE. ELYRIA, OHIO

SURVEYED BY: DALE HAYWOOD

CLOSURE: 0.00 : 10.000

MAP PAGE(S): 12-00-044-A

APPROVED BY: JAH DATE: 9-11-07

SCALE: 1"= 200 PRIOR INSTRUMENT: 20060164160