RASTER

PARENT PARCEL: 04-00-027-102-061

CHILD PARCEL: 04-00-027-102-072, -073

STARTING POINT: INTERSECTION OF O.L. 26 & 27 AND THE LORAIN/CUYAHOGA COUNTY LINE

07-02478

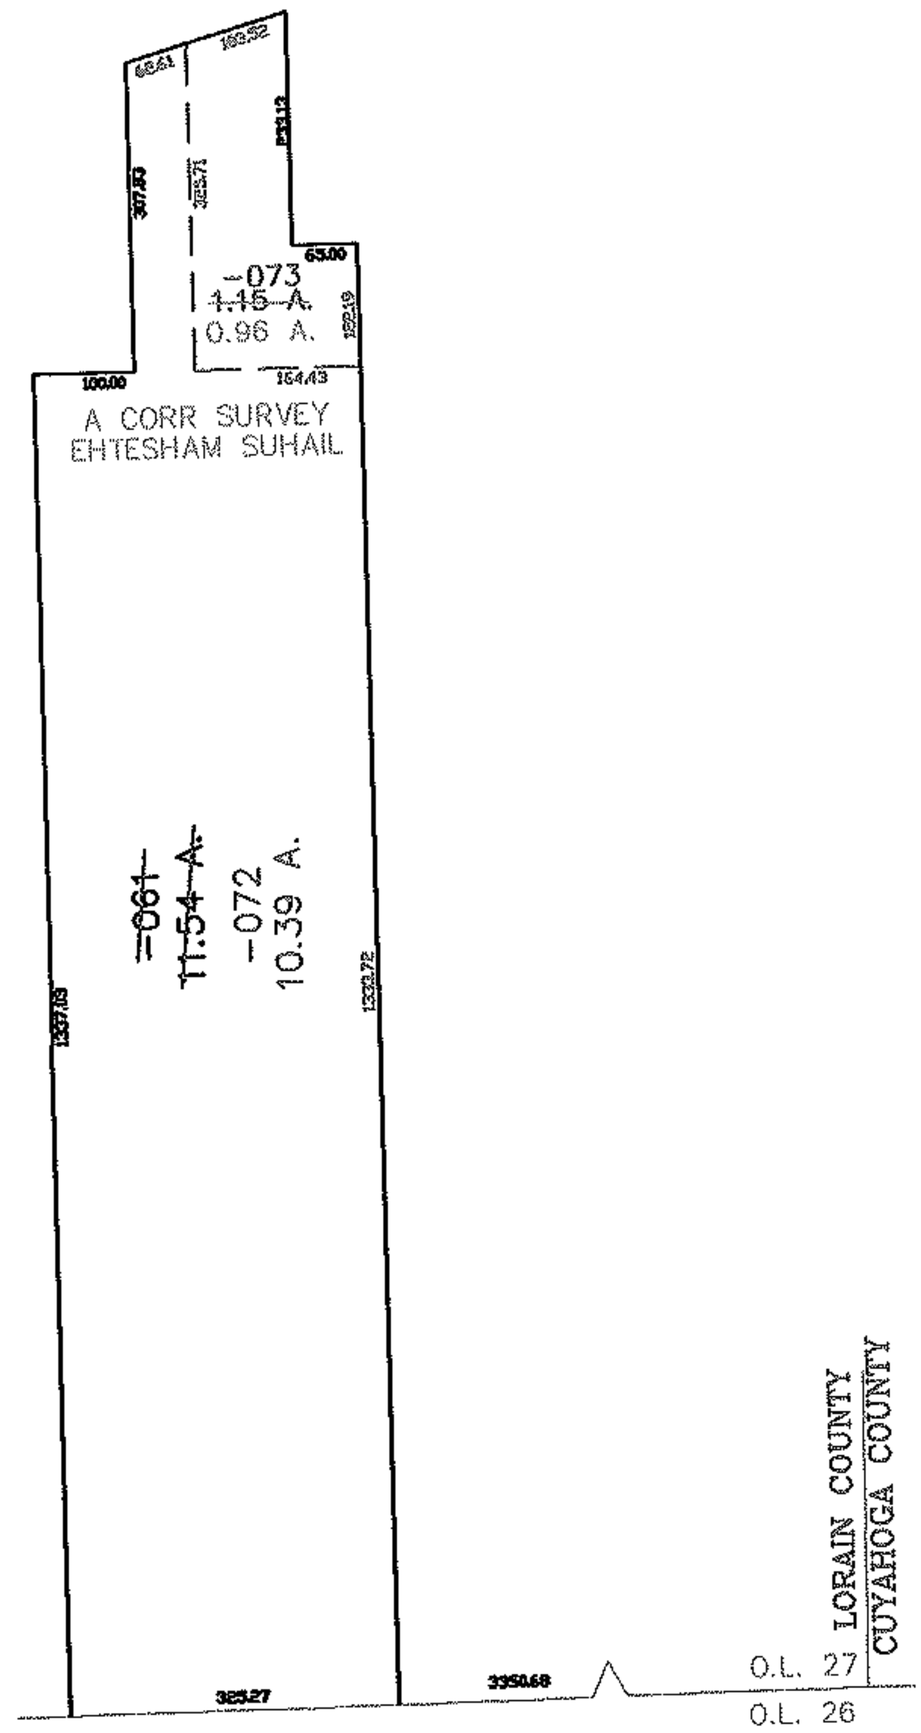

SPLITS/DEEDS PROCESSED

LORAIN COUNTY TAX MAP DEPARTMENT
226 MIDDLE AVE. ELYRIA, OHIO

SURVEYED BY: EHTASHAM SUHAIL

CLOSURE: 0.00 : 10,000

MAP PAGE(S): 04-00-027-F

APPROVED BY: JAH DATE: 10-25-07

SCALE: 1"= 300 PRIOR INSTRUMENT: 20030886048