RASTER

PARENT PARCEL: 19-04-048-000-036, -035

CHILD PARCEL: 19-04-048-000-037 THRU -039

STARTING POINT: CENTERLINE OF NORWALK-MEDINA RD. & VERMONT ST.

07-02489

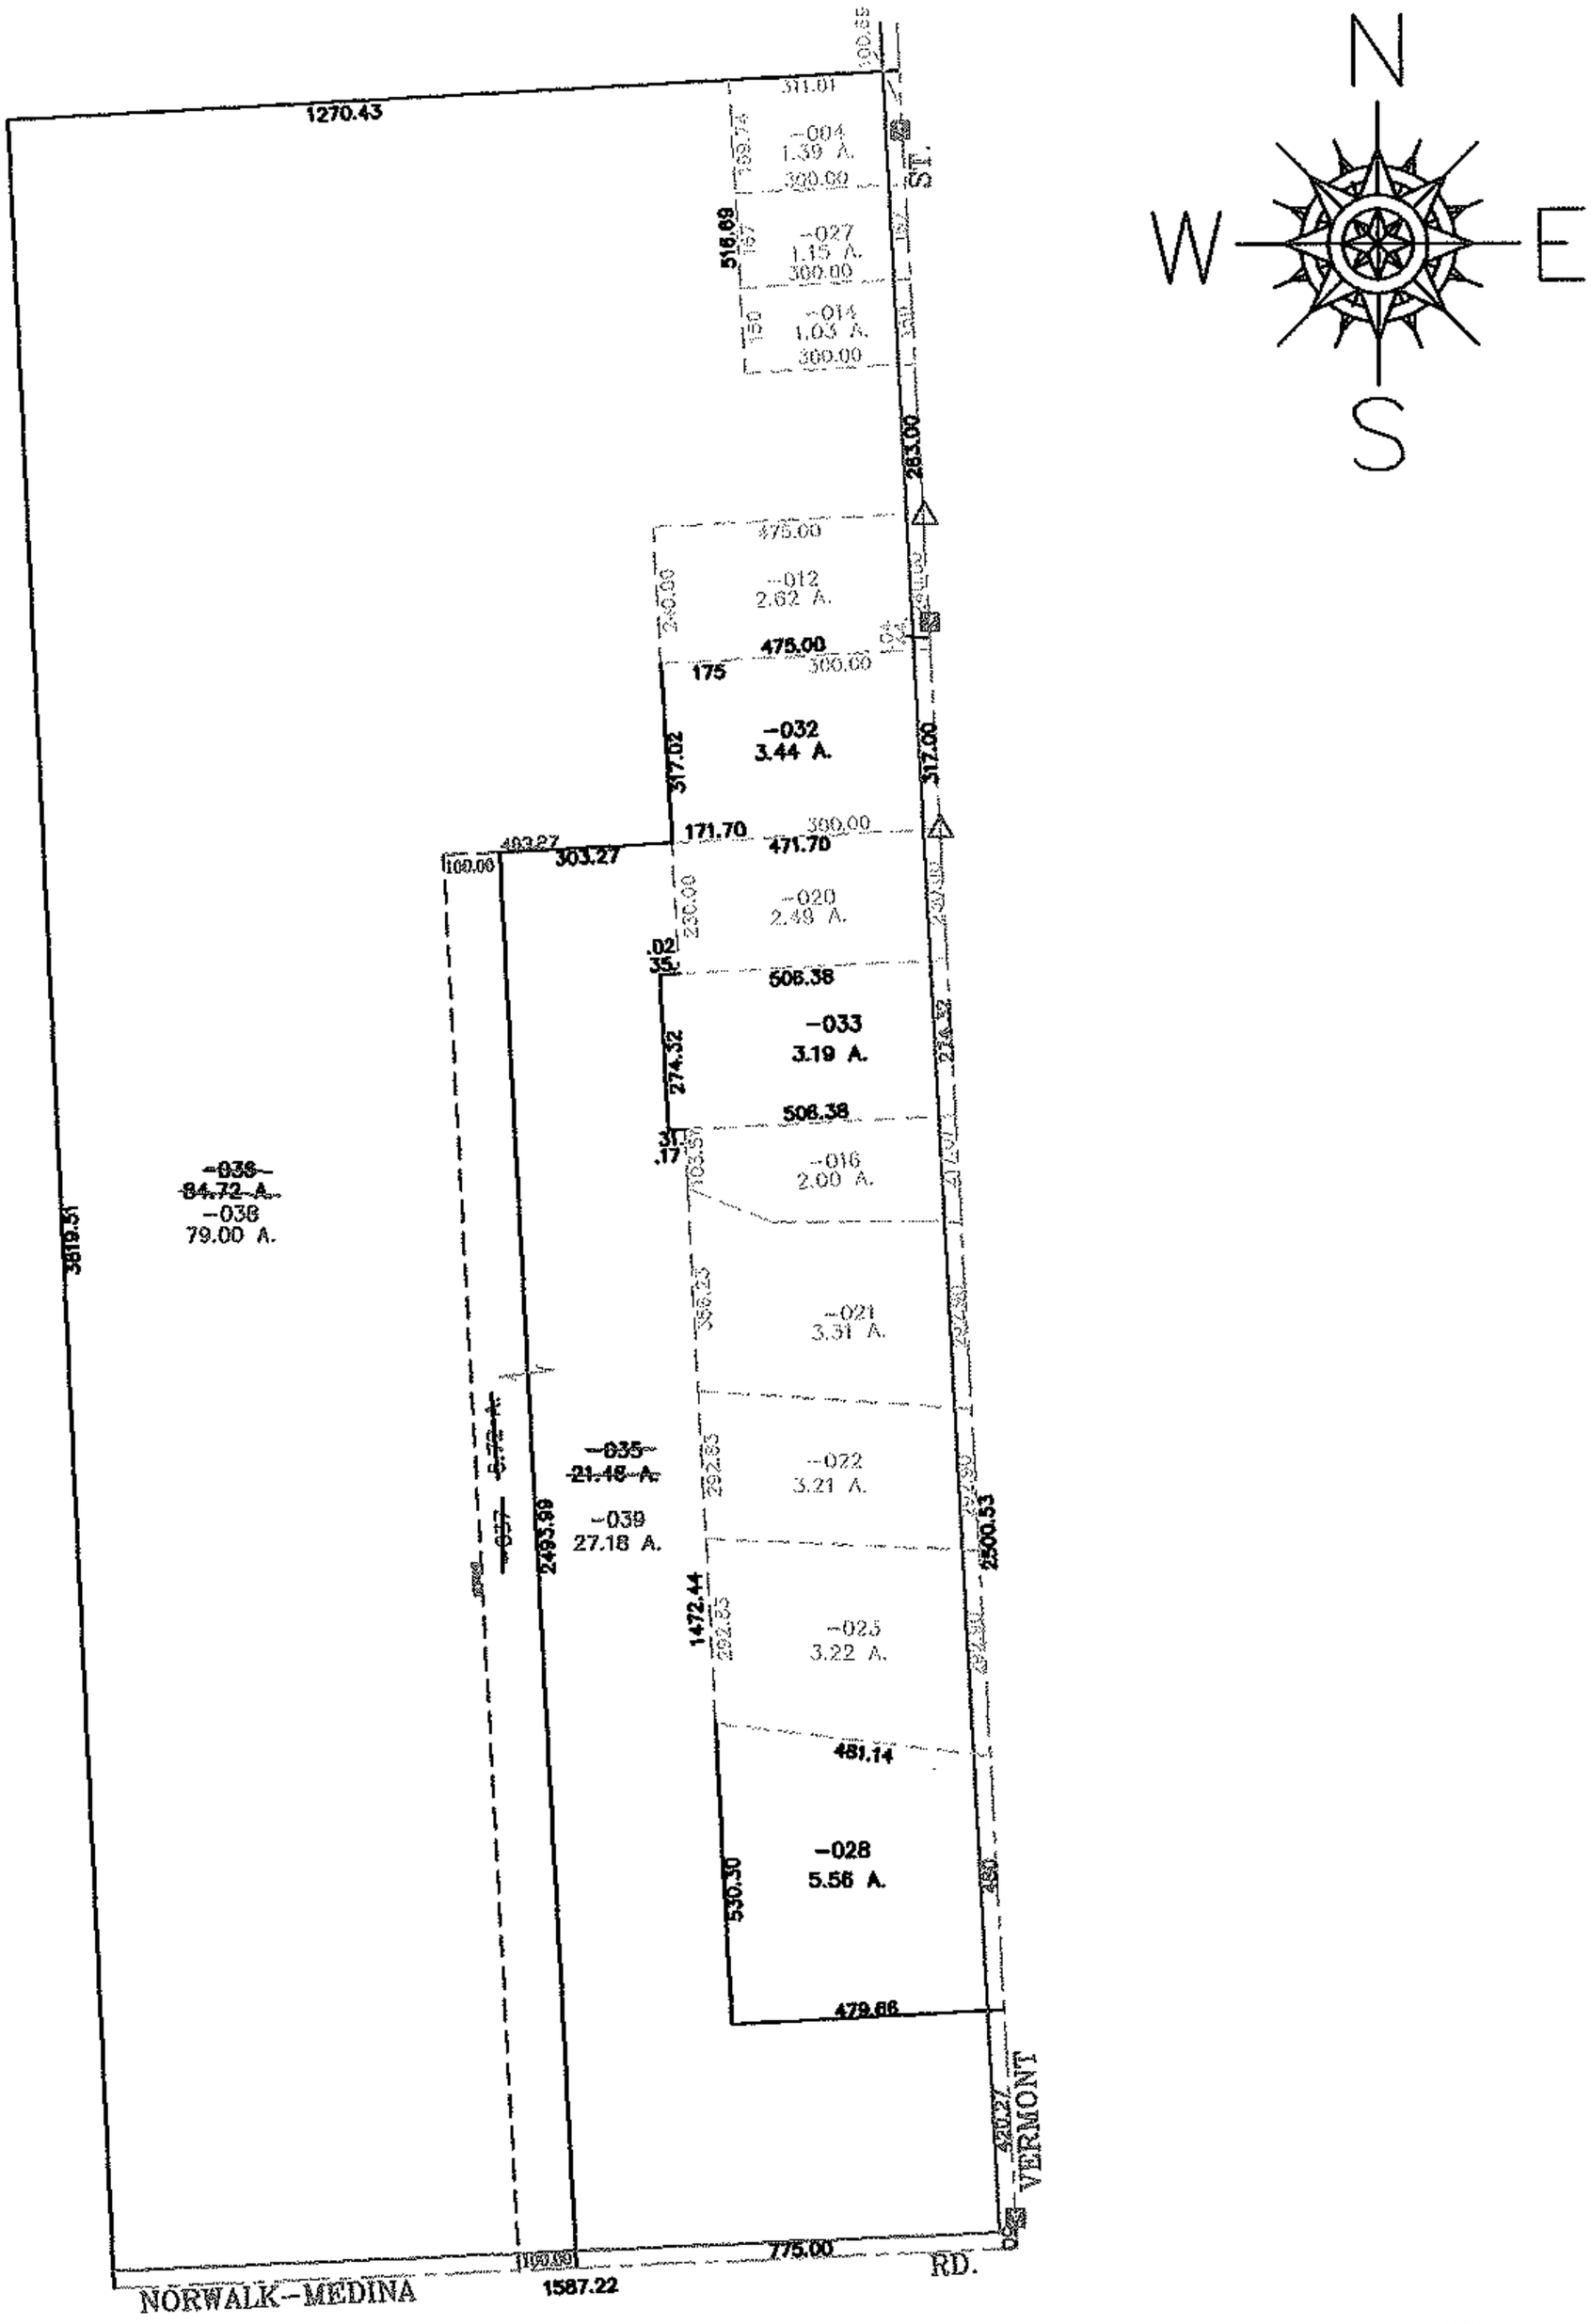

SPLITS/DEEDS PROCESSED

LORAIN COUNTY TAX MAP DEPARTMENT
226 MIDDLE AVE. ELYRIA, OHIO

SURVEYED BY: RICHARD D. CARLSON

CLOSURE: 0.01 : 10,000

MAP PAGE(S): 19-D

APPROVED BY: JAH DATE: 11-7-07

SCALE: 1"= 500 PRIOR INSTRUMENT: 20050061202