07-02510

REMAINDERS

~~-097~~
~~5.57 A.~~
~~-099~~
~~5.55 A.~~
~~-101~~
~~5.53 A.~~
~~-103~~
~~5.51 A.~~
~~-105~~
~~5.49 A.~~
~~-107~~
~~5.44 A.~~
~~-109~~
~~5.41 A.~~
~~-111~~
~~5.35 A.~~
~~-113~~
~~5.32 A.~~
~~-115~~
~~4.69 A.~~

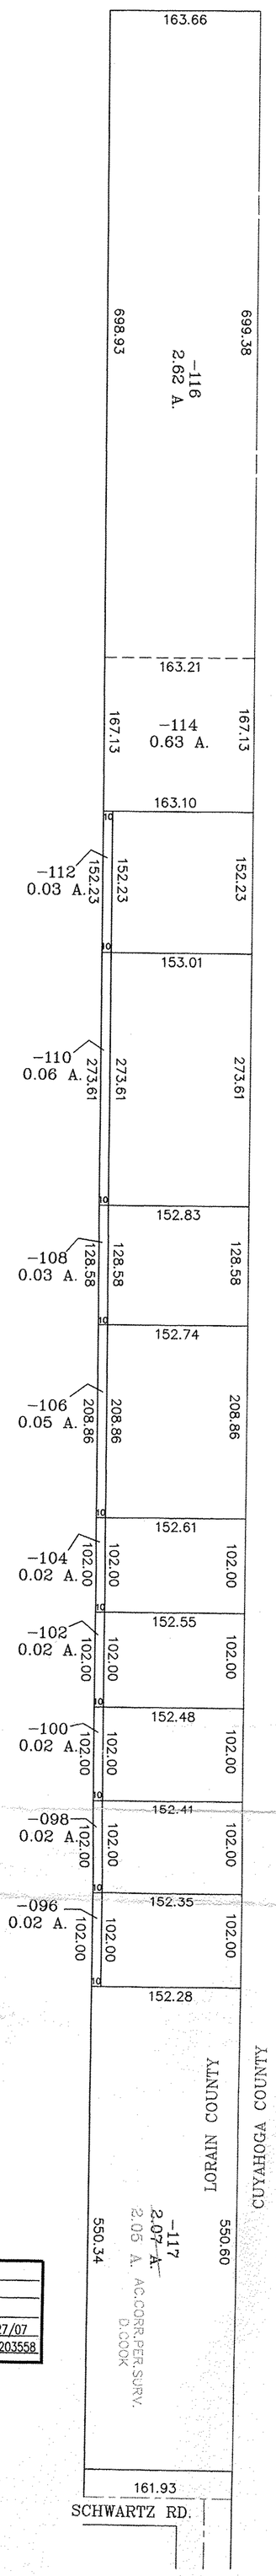

07-02510

SPLITS/DEEDS PROCESSED
LORAIN COUNTY TAX MAP DEPARTMENT
226 MIDDLE AVE. ELYRIA, OHIO

SURVEYED BY: DANIEL J. COOK
CLOSURE: 00:10.000
MAP PAGE(S): 04-00-026-D
APPROVED BY: RRM DATE: 12/27/07
SCALE: 1"= 100 PRIOR INSTRUMENT: 20070203558