RASTER

PARENT PARCEL: 04-00-012-102-015, -016

CHILD PARCEL: 04-00-012-102-067 THRU -072

STARTING POINT: SOUTHERLY RIGHT AWAY LINE OF MEADOW LN IN HRICOVEC ALLT

08-02519

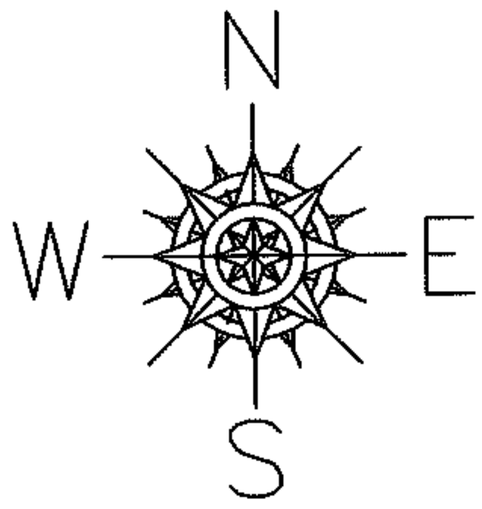

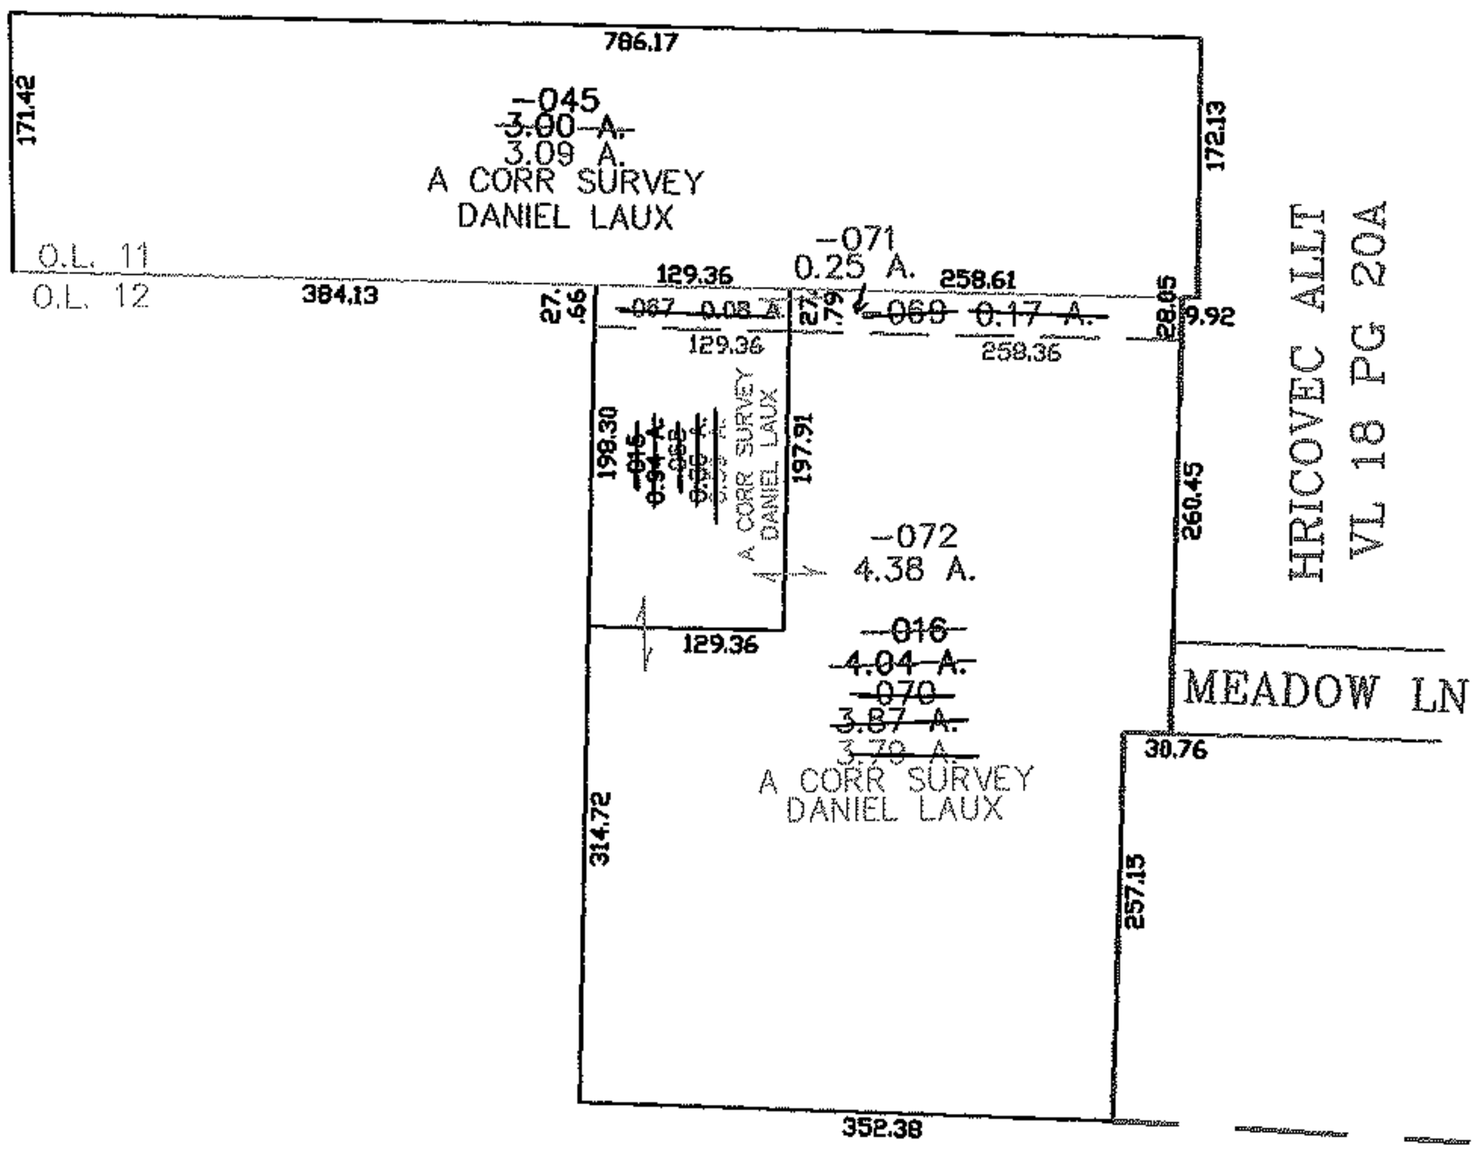

SPLITS/DEEDS PROCESSED

LORAIN COUNTY TAX MAP DEPARTMENT
226 MIDDLE AVE. ELYRIA, OHIO

SURVEYED BY: DANIEL LAUX

CLOSURE: 0.00 : 10,000

MAP PAGE(S): 04-00-012-B

APPROVED BY: JAH DATE: 1-29-08

SCALE: 1"= 200 PRIOR INSTRUMENT: 20070192407