PARENT PARCEL: 07-00-045-110-074, -097

CHILD PARCEL: 07-00-045-110-101 THRU -104

STARTING POINT: CENTERLINE OF QUAILS NEST LN & SONGBIRD LN

08-02525

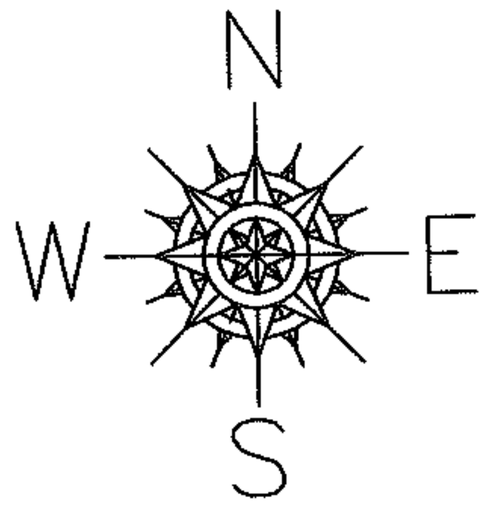

BLOCK "B"

~~-097~~

~~8.30 A.~~

-104

8.29 A.

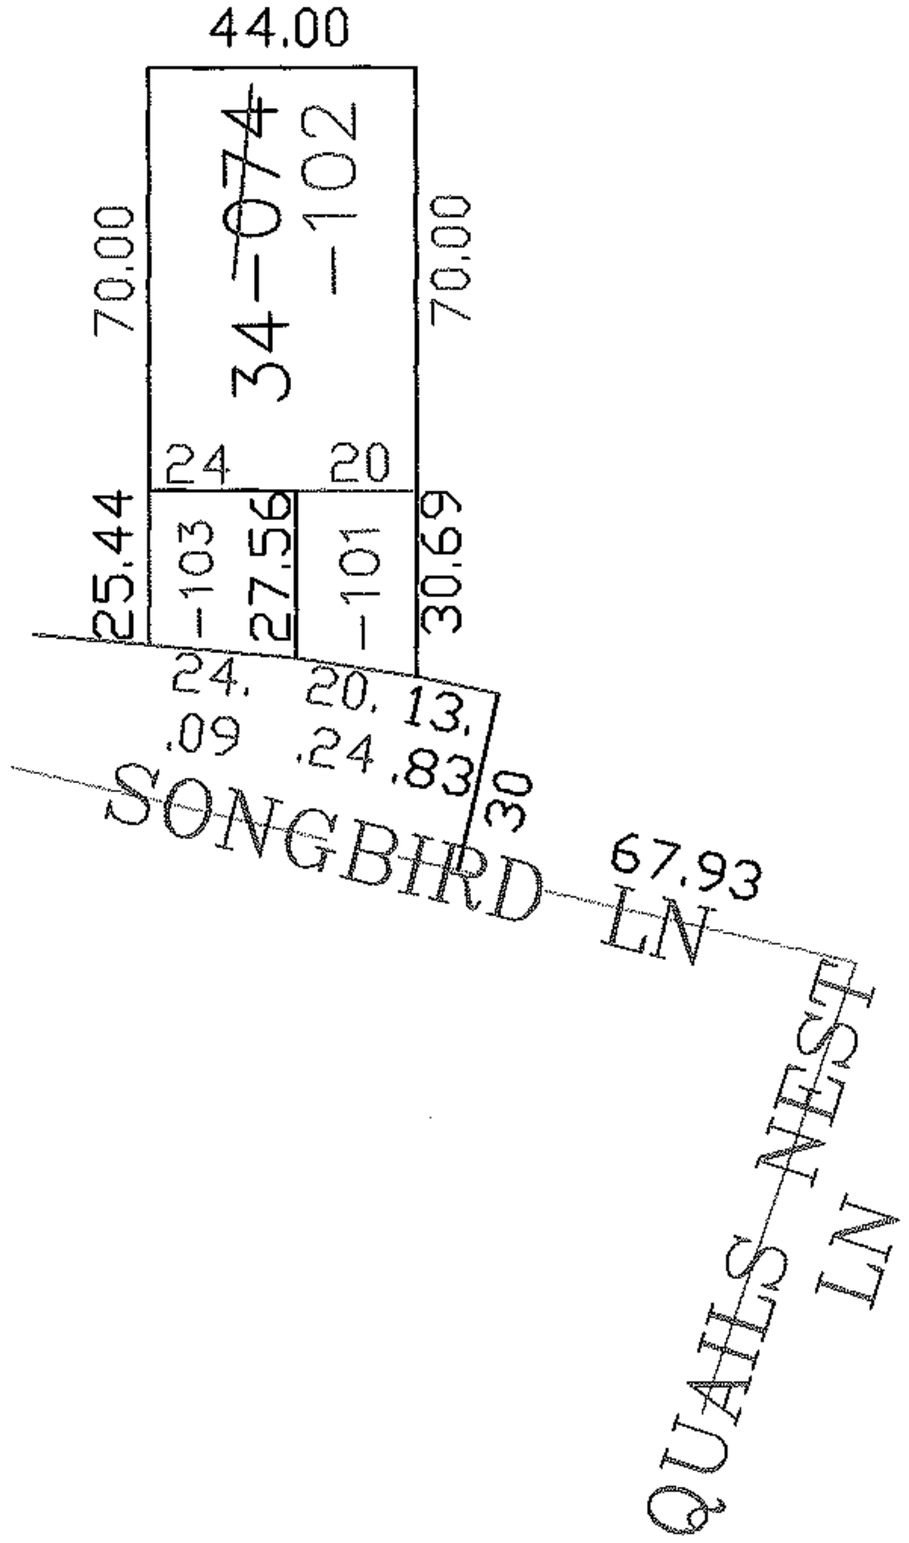

SPLITS/DEEDS PROCESSED

LORAIN COUNTY TAX MAP DEPARTMENT
226 MIDDLE AVE. ELYRIA, OHIO

SURVEYED BY: DAVE ELWELL

CLOSURE: 0.00 : 10,000

MAP PAGE(S): 07-00-045-D

APPROVED BY: JAH DATE: 2-12-08

SCALE: 1"= 100 PRIOR INSTRUMENT: PL VL 87/1