RASTER

PARENT PARCEL: 04-00-022-102-037, -063, -066, -076 THRU -079

CHILD PARCEL:

STARTING POINT: AT A MON BOX AT THE NORTHEAST CORNER OF SEC. 22

12-02526-A

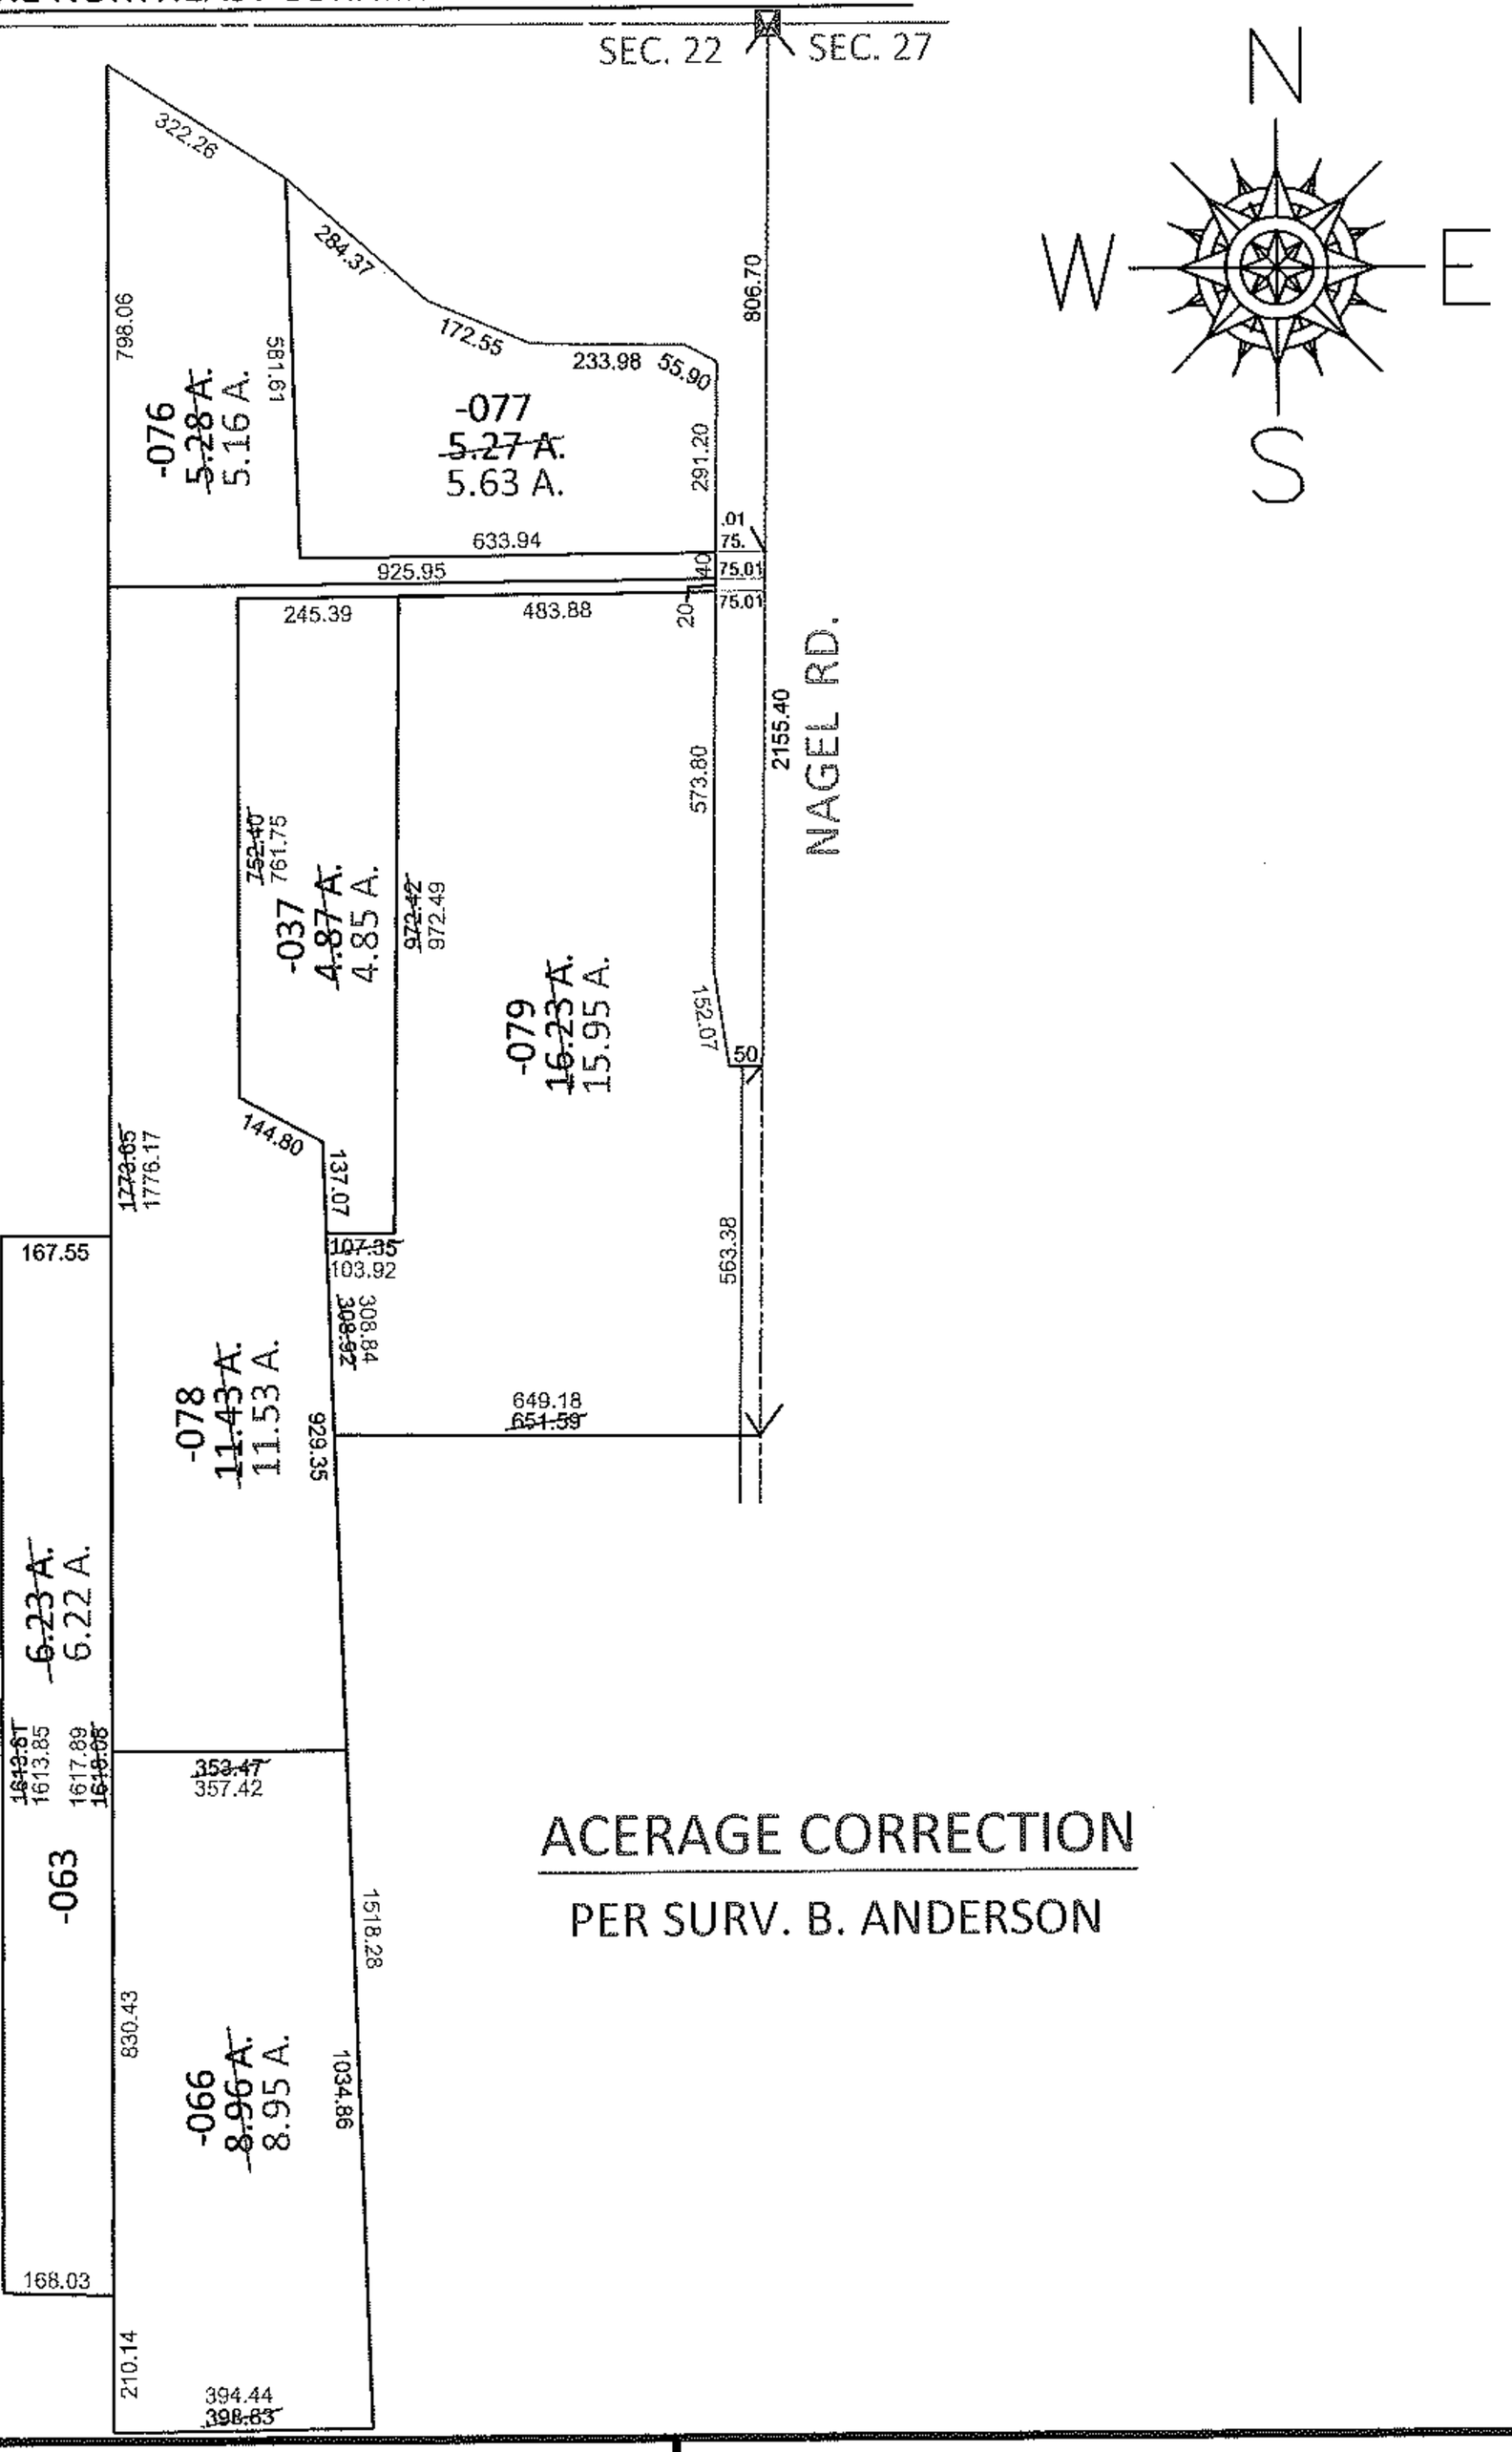

ACERAGE CORRECTION

PER SURV. B. ANDERSON

SPLITS/DEEDS PROCESSED

LORAIN COUNTY TAX MAP DEPARTMENT
226 MIDDLE AVE. ELYRIA, OHIO

SURVEYED BY: BRENT D. ANDERSON
CLOSURE: .01:10,000
MAP PAGE(S): 4-00-022-D & H
APPROVED BY: RRM DATE: 6-19-12
SCALE: 1"= 450 PRIOR INST.: 19970493429