


PARENT PARCEL: 04-00-002-101-021
CHILD PARCEL: _____
STARTING POINT: AT A MON BOX AT THE INTERSECTION OF C/L OF MOON RD. AND
C/L OF DETROIT RD.

12-02529-C

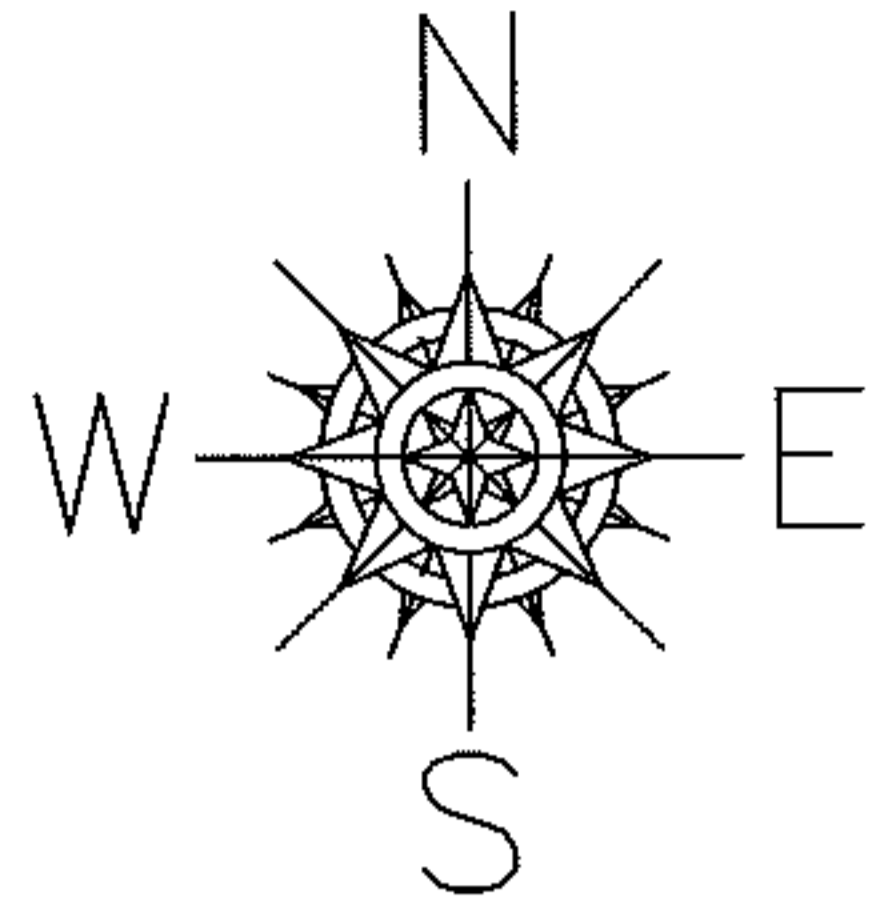


394.02
2244.22
-021
~~19.35 A.~~
20.86 A. AC. CORR. PER. SURV.
2303.05 L. VEVERKA

409.50
MOON RD.
884.23

FIRST DONE UNDER TICKET
NO. 09-01899-C

739.26 RD.
DETROIT RD.

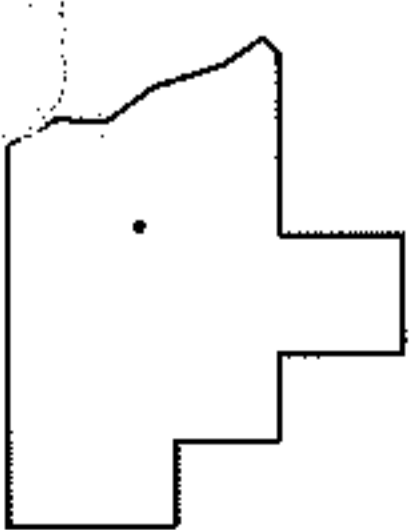

SPLITS/DEEDS PROCESSED
LORAIN COUNTY TAX MAP DEPARTMENT
226 MIDDLE AVE. ELYRIA, OHIO

SURVEYED BY: LOUISE A. VEVERKA
CLOSURE: .01:10,000
MAP PAGE(S): 04-00-002-E & F
APPROVED BY: RRM DATE: 10-13-09
SCALE: 1"= 400 PRIOR INST.: 20000688792