RASTER

PARENT PARCEL: 13-10-024-000-001, 13-10-025-000-001, -004

CHILD PARCEL: 13-10-024-000-001, 13-10-025-000-005

STARTING POINT: CENTERLINE OF WAKEMAN-LAGRANGE-RICHFIELD RD & ROWELL RD

08-02529

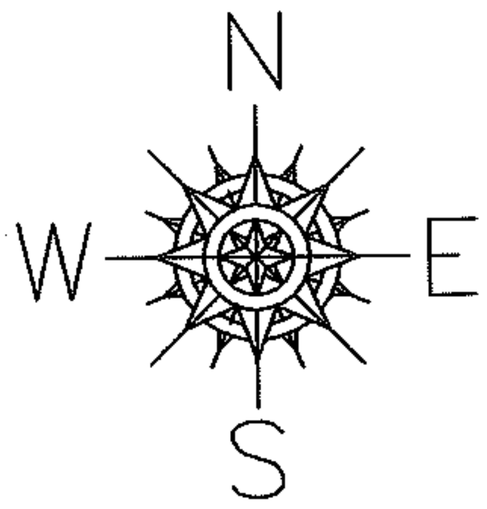

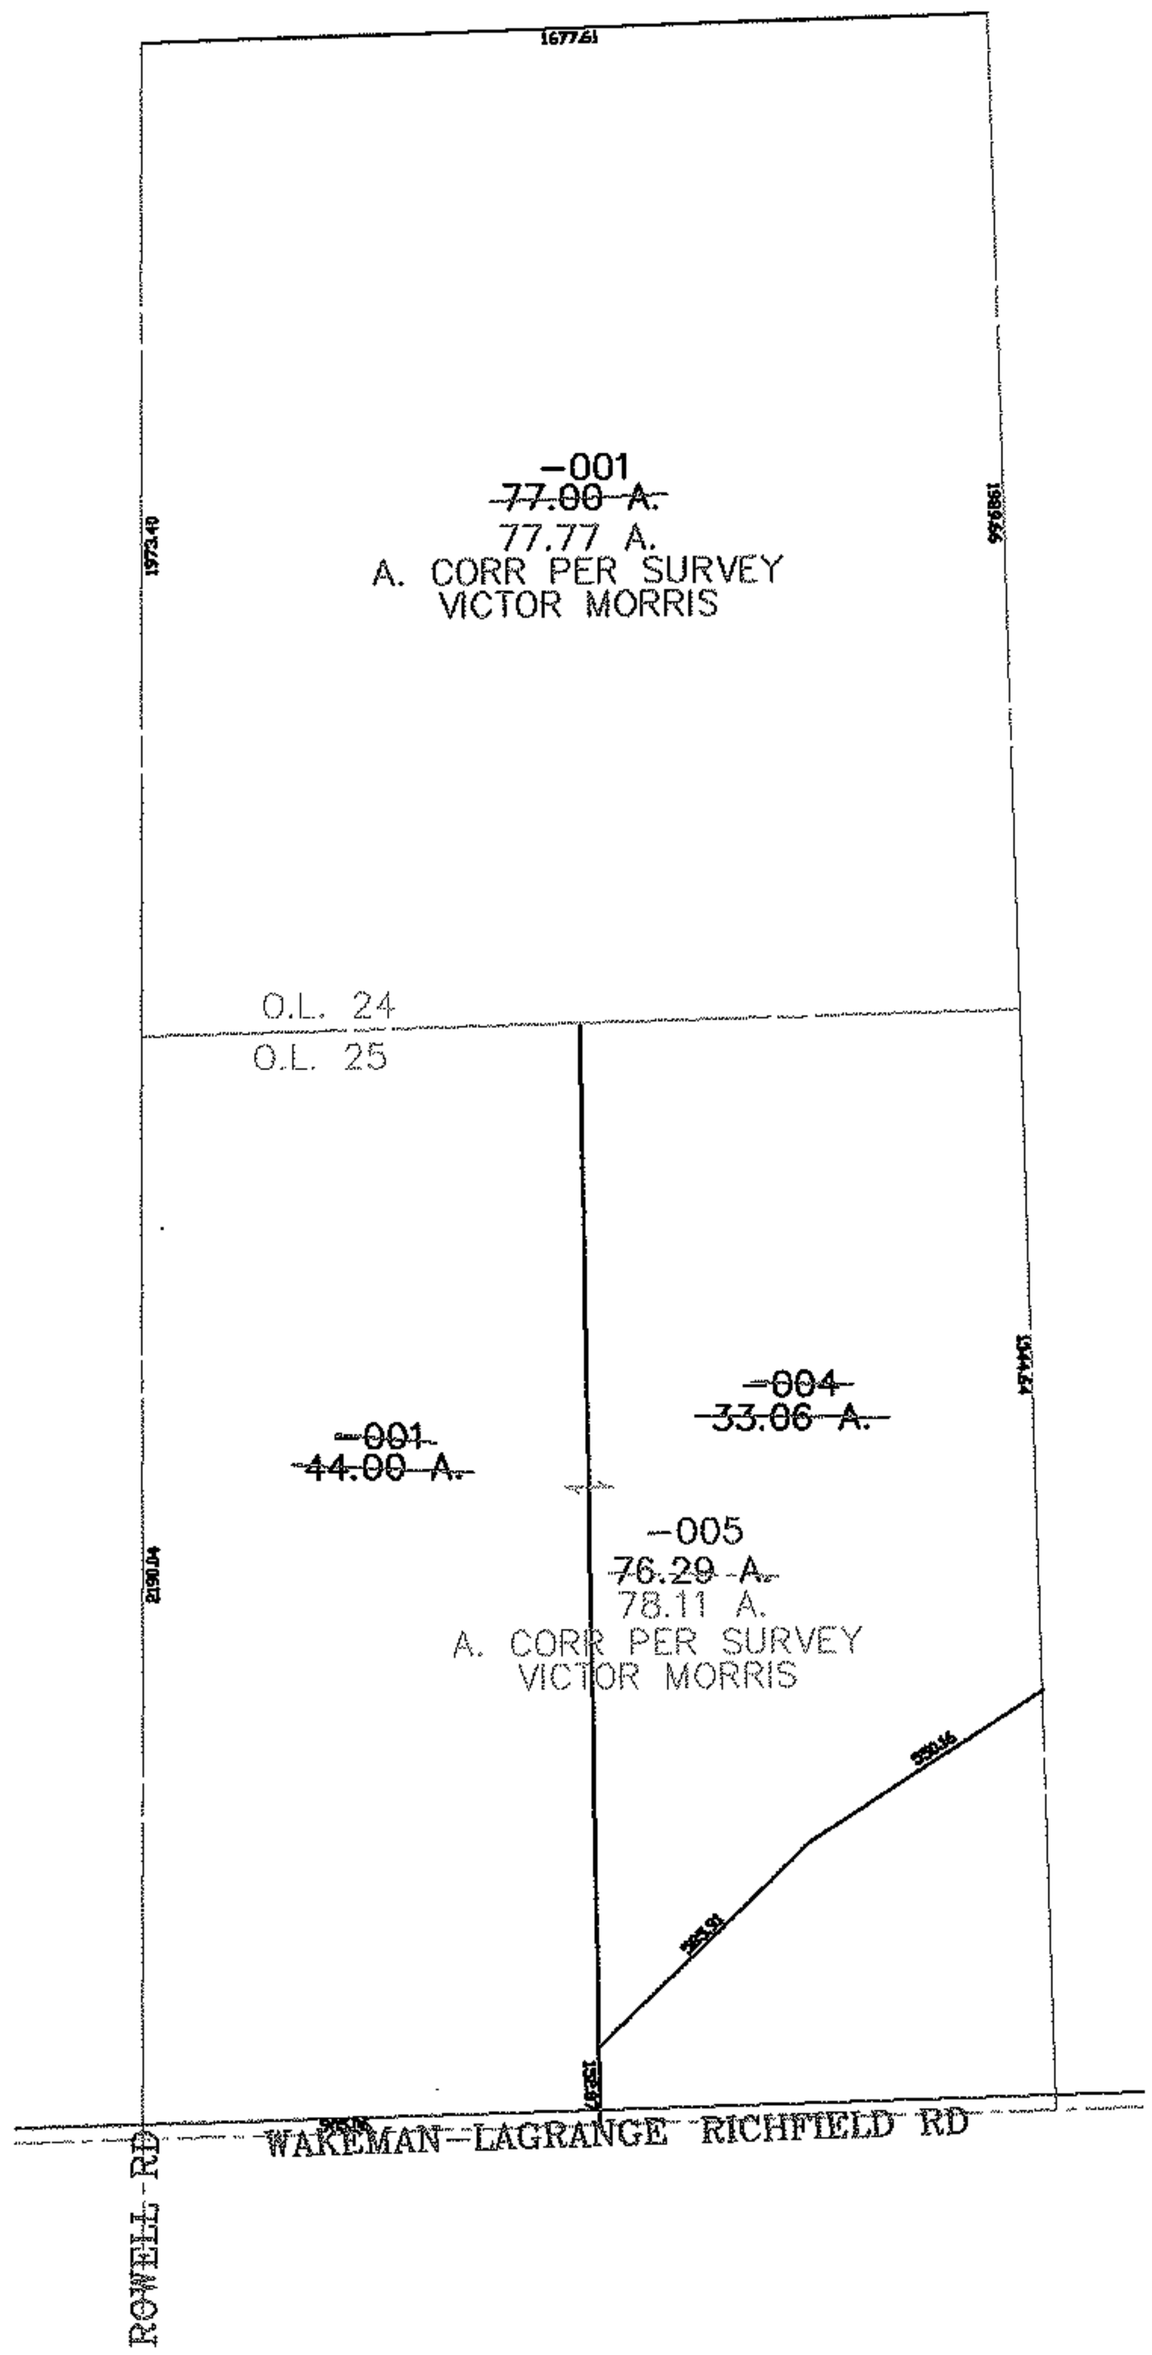

SPLITS/DEEDS PROCESSED

LORAIN COUNTY TAX MAP DEPARTMENT
226 MIDDLE AVE. ELYRIA, OHIO

SURVEYED BY: VICTOR MORRIS

CLOSURE: 0.00 : 10,000

MAP PAGE(S): 13-B

APPROVED BY: JAH DATE: 02-26-08

SCALE: 1"= 600 PRIOR INSTRUMENT: 20050076874