RASTER

PARENT PARCEL: 01-00-062-000-046, -036, -035, -038

CHILD PARCEL: 01-00-062-000-047 THRU -055

STARTING POINT: CENTERLINE OF BANK ST & O.L. 62

08-02535

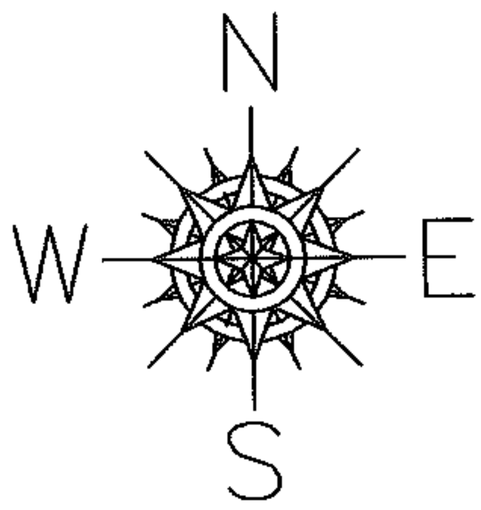

~~-046~~
~~27.78 A.~~
~~-048~~
~~26.90 A.~~
~~-051~~
~~26.02 A.~~
-054
25.47 A.

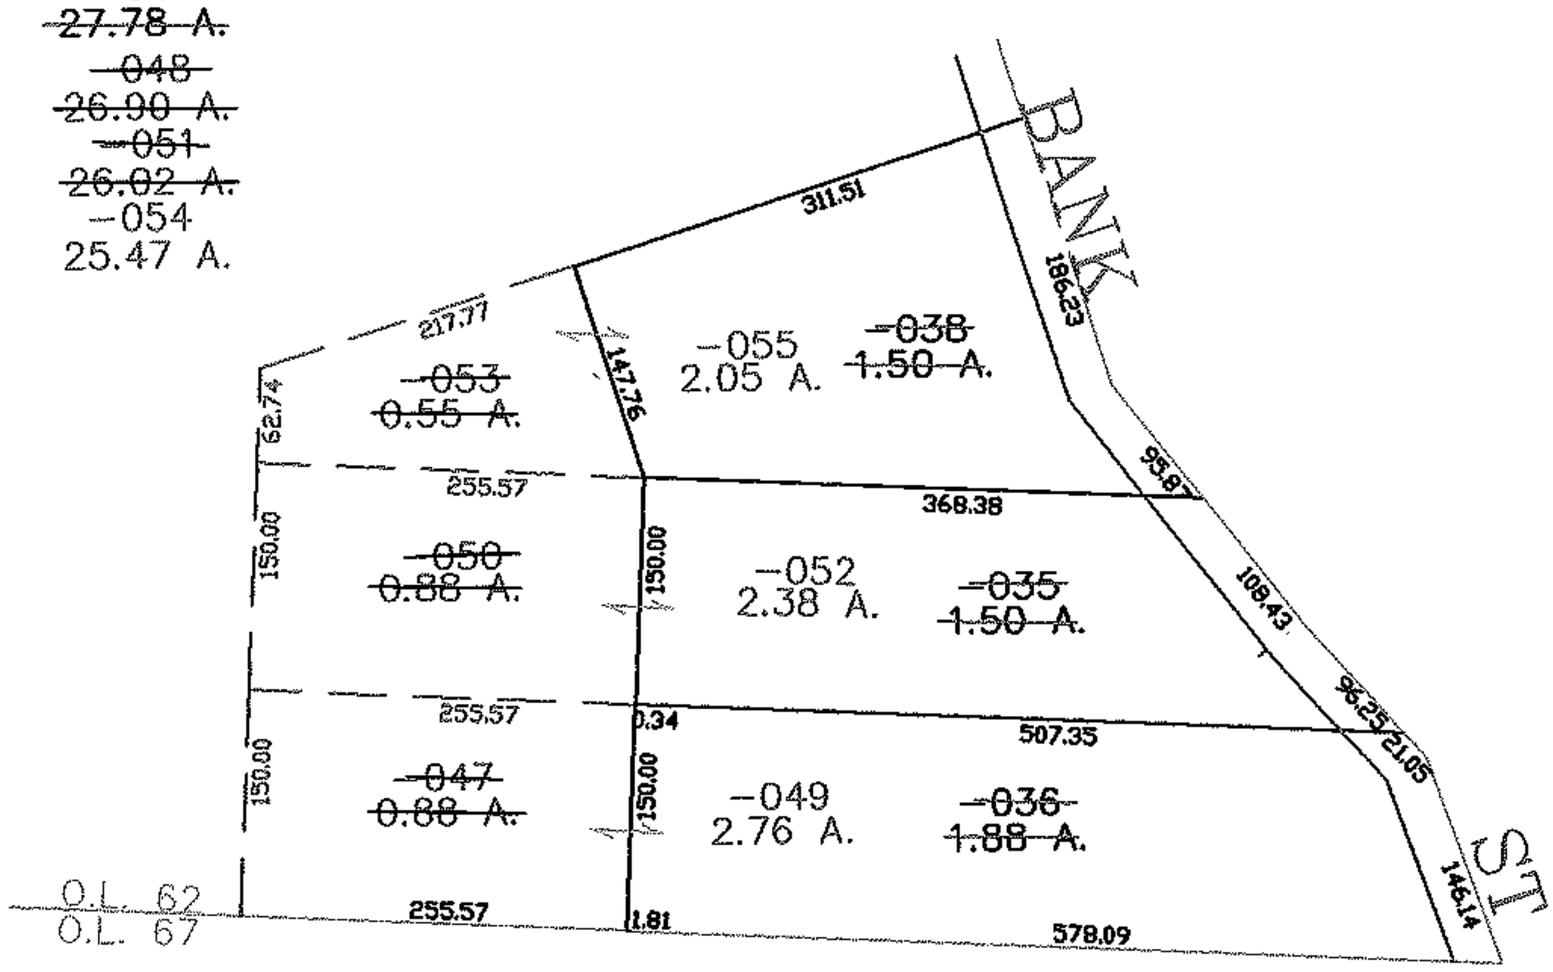

SPLITS/DEEDS PROCESSED

LORAIN COUNTY TAX MAP DEPARTMENT
226 MIDDLE AVE. ELYRIA, OHIO

SURVEYED BY: CHARLES P WARYU
CLOSURE: 0.00 ; 10.000
MAP PAGE(S): 1-J
APPROVED BY: JAH DATE: 3-4-08
SCALE: 1"= 200 PRIOR INSTRUMENT: OR 1201/550