PARENT PARCEL: 07-00-023-102-002

CHILD PARCEL: 07-00-023-102-069

STARTING POINT: SOUTH LINE OF O.L.23 AT THE SOUTHWEST CORNER OF LAND CONVEYED TO DIEDERICK VONKAMP(DV 162/227)

12-02543-D

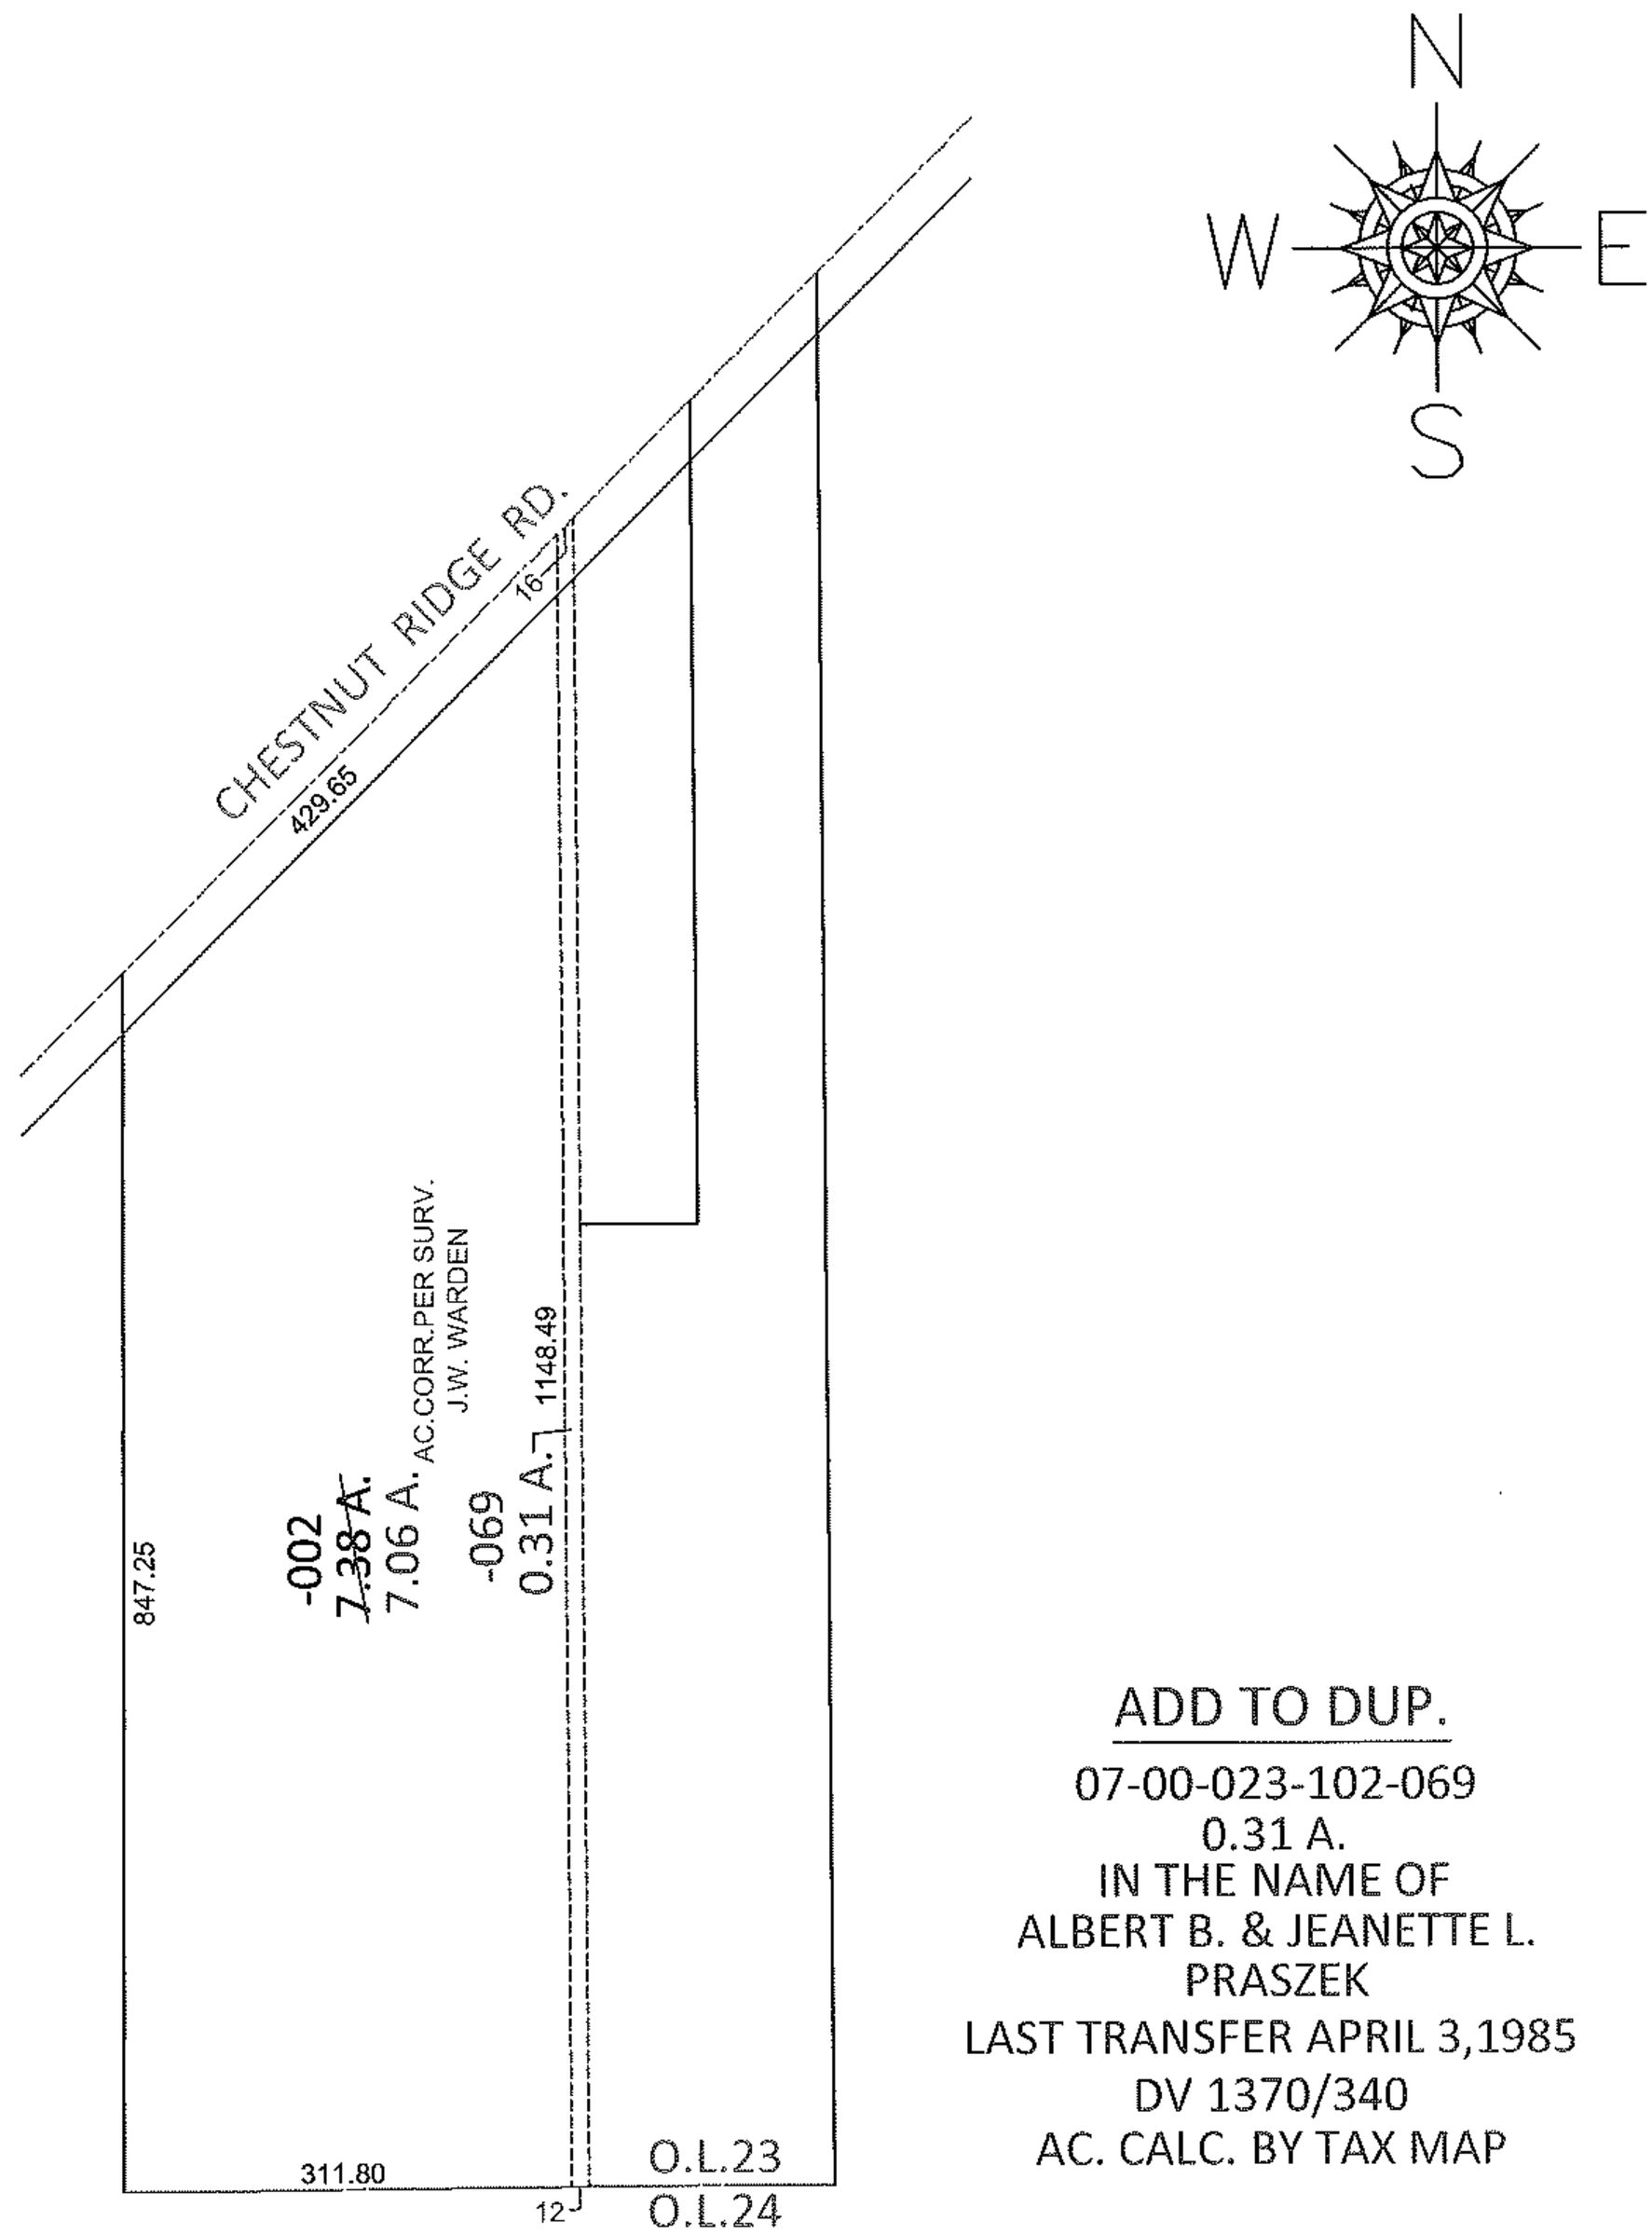

ADD TO DUP.

07-00-023-102-069
0.31 A.
IN THE NAME OF
ALBERT B. & JEANETTE L.
PRASZEK
LAST TRANSFER APRIL 3,1985
DV 1370/340
AC. CALC. BY TAX MAP

SPLITS/DEEDS PROCESSED

LORAIN COUNTY TAX MAP DEPARTMENT
226 MIDDLE AVE. ELYRIA, OHIO

SURVEYED BY: J.W. WARDEN

CLOSURE: 1:4734.48

MAP PAGE(S): 7-00-023-C

APPROVED BY: RRM DATE: 7-30-12

SCALE: 1"= 200 PRIOR INST.: DV XXXX/XXX