RASTER

PARENT PARCEL: 12-00-001-000-028, -029

CHILD PARCEL: 12-00-001-000-038 THRU -043

STARTING POINT: INTERSECTION OF C/L OF REDFERN RD. AND C/L OF N. MARKS RD.

08-02592

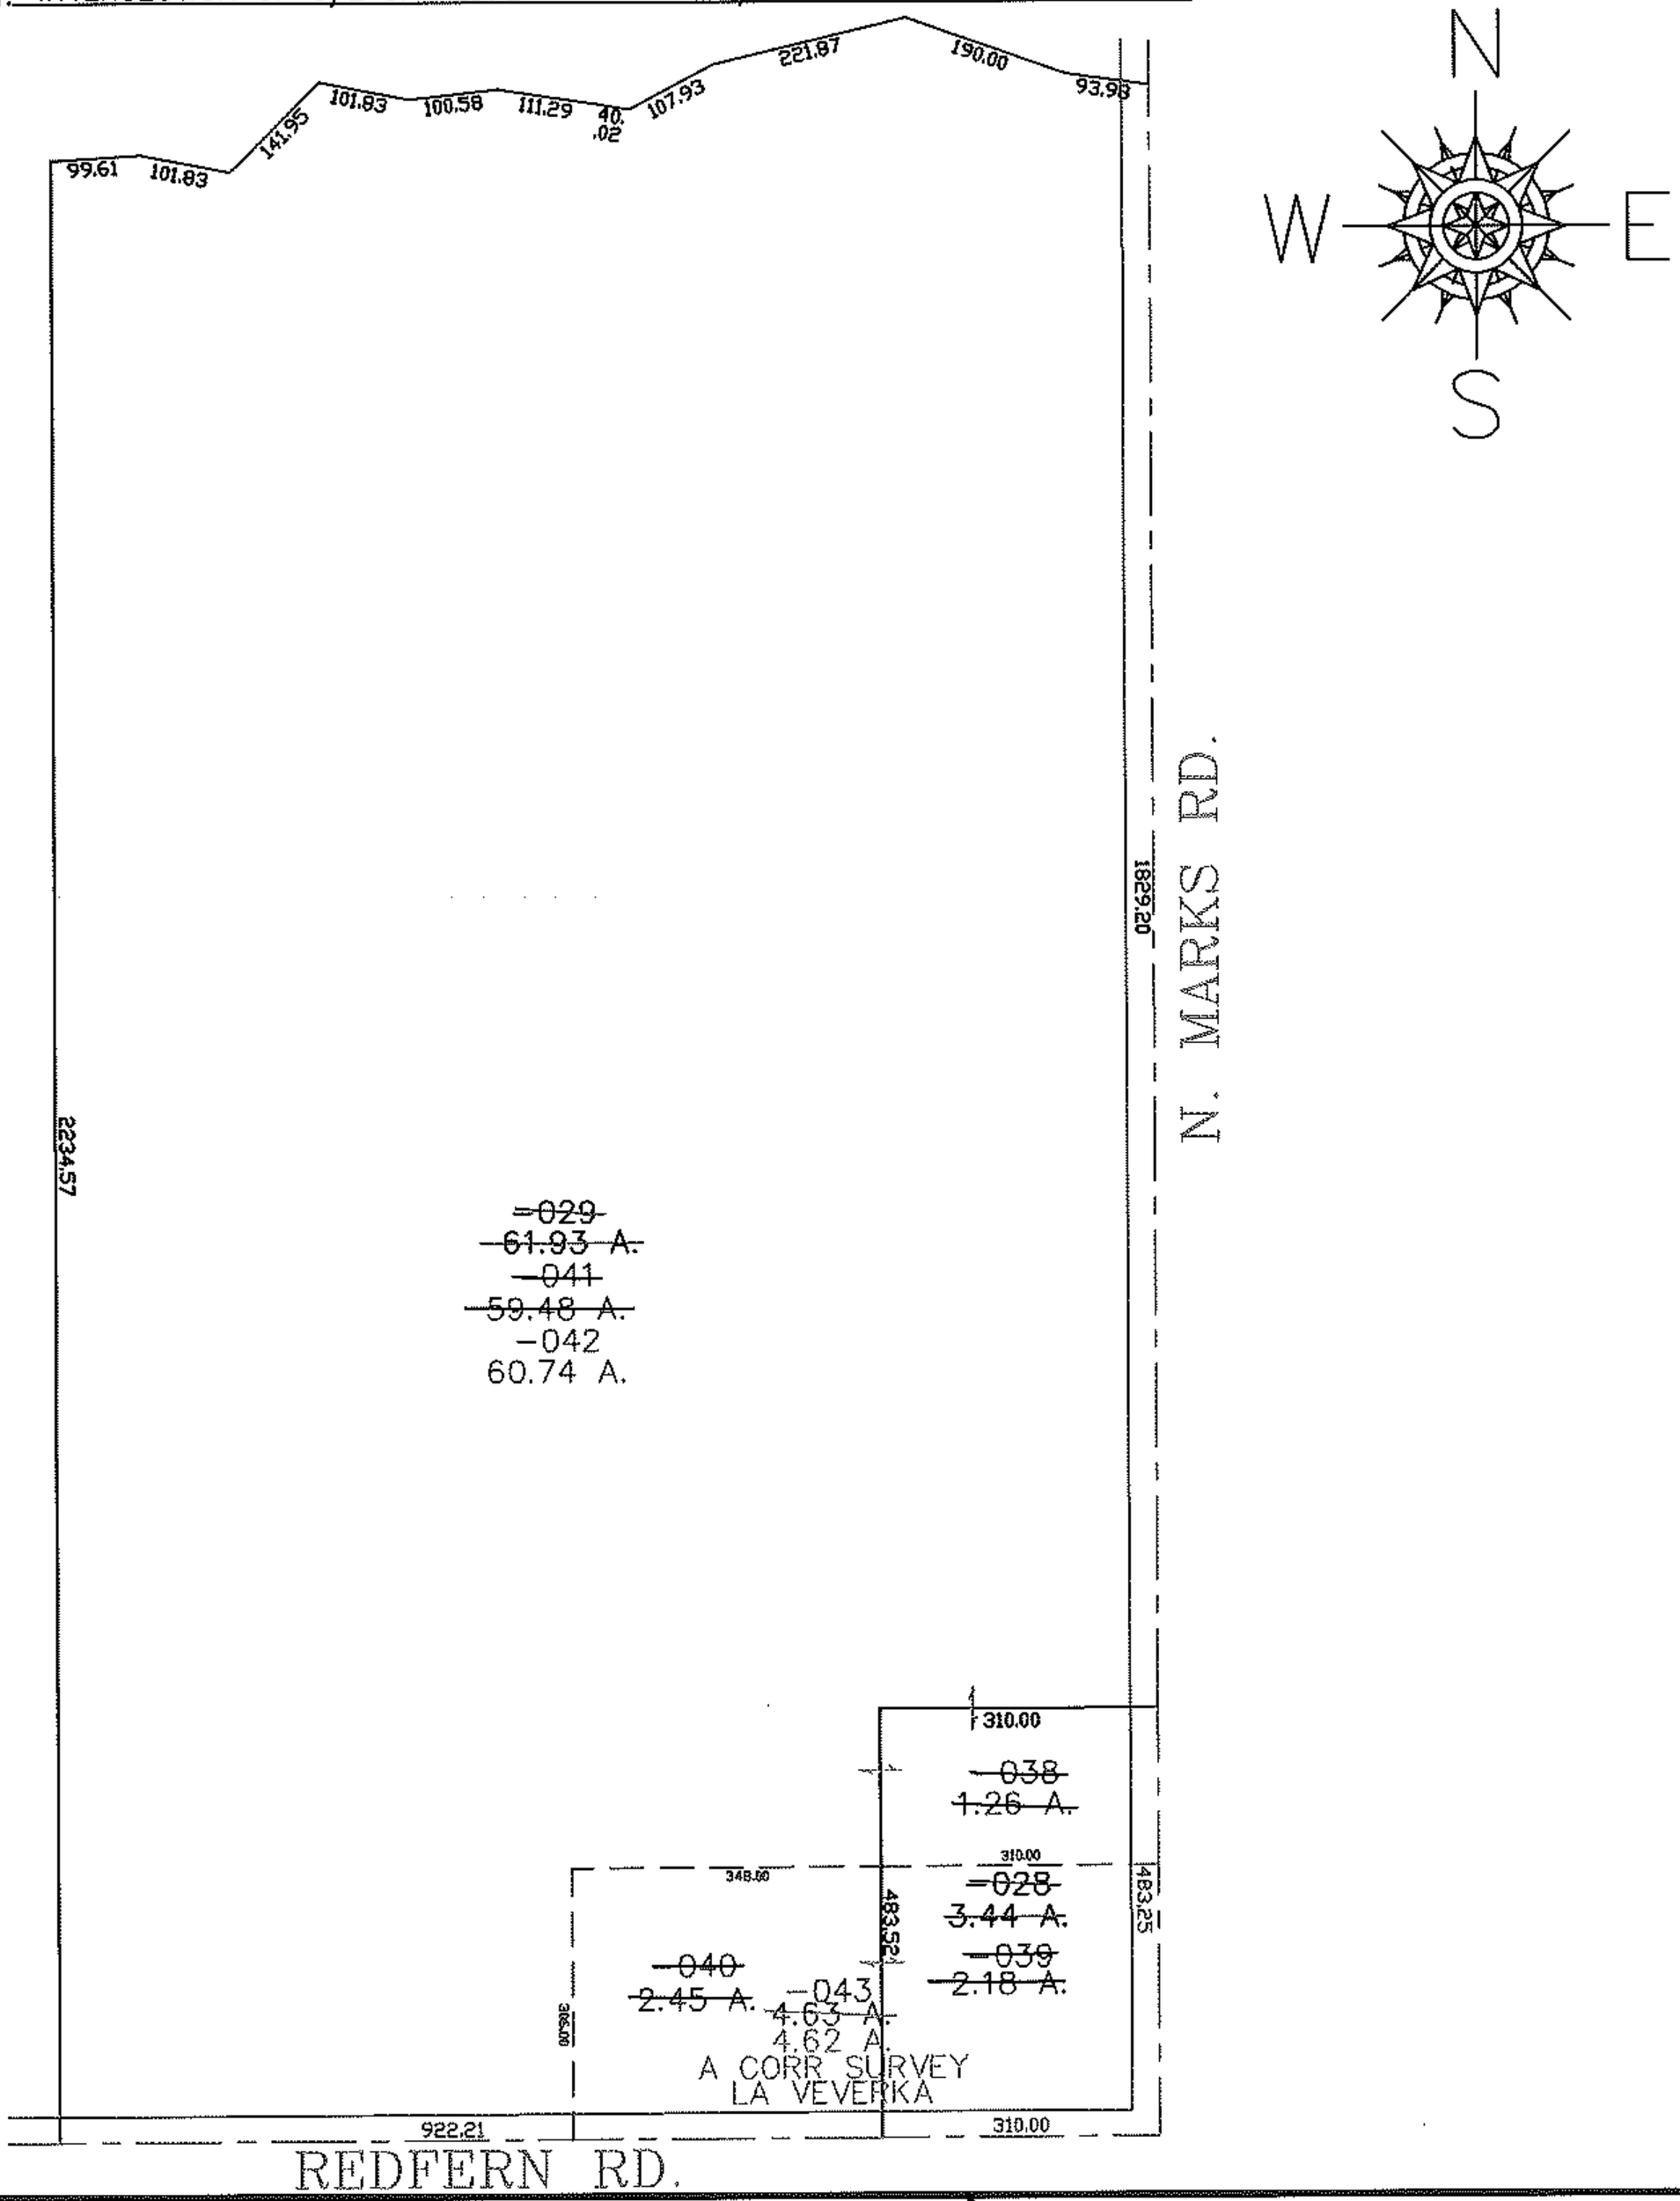


SPLITS/DEEDS PROCESSED

LORAIN COUNTY TAX MAP DEPARTMENT
226 MIDDLE AVE. ELYRIA, OHIO

SURVEYED BY: LOUISE VEVERKA

CLOSURE: .01:10,000

MAP PAGE(S): 12-00-001-B

APPROVED BY: JAH DATE: 7-28-08

SCALE: 1"= 300 PRIOR INSTRUMENT: 20040026977