PARENT PARCEL: 04-00-005-000-119

CHILD PARCEL: 04-00-005-000-120, -121

STARTING POINT: CENTERLINE OF PIN OAK PKWY & MOORE RD

08-02598

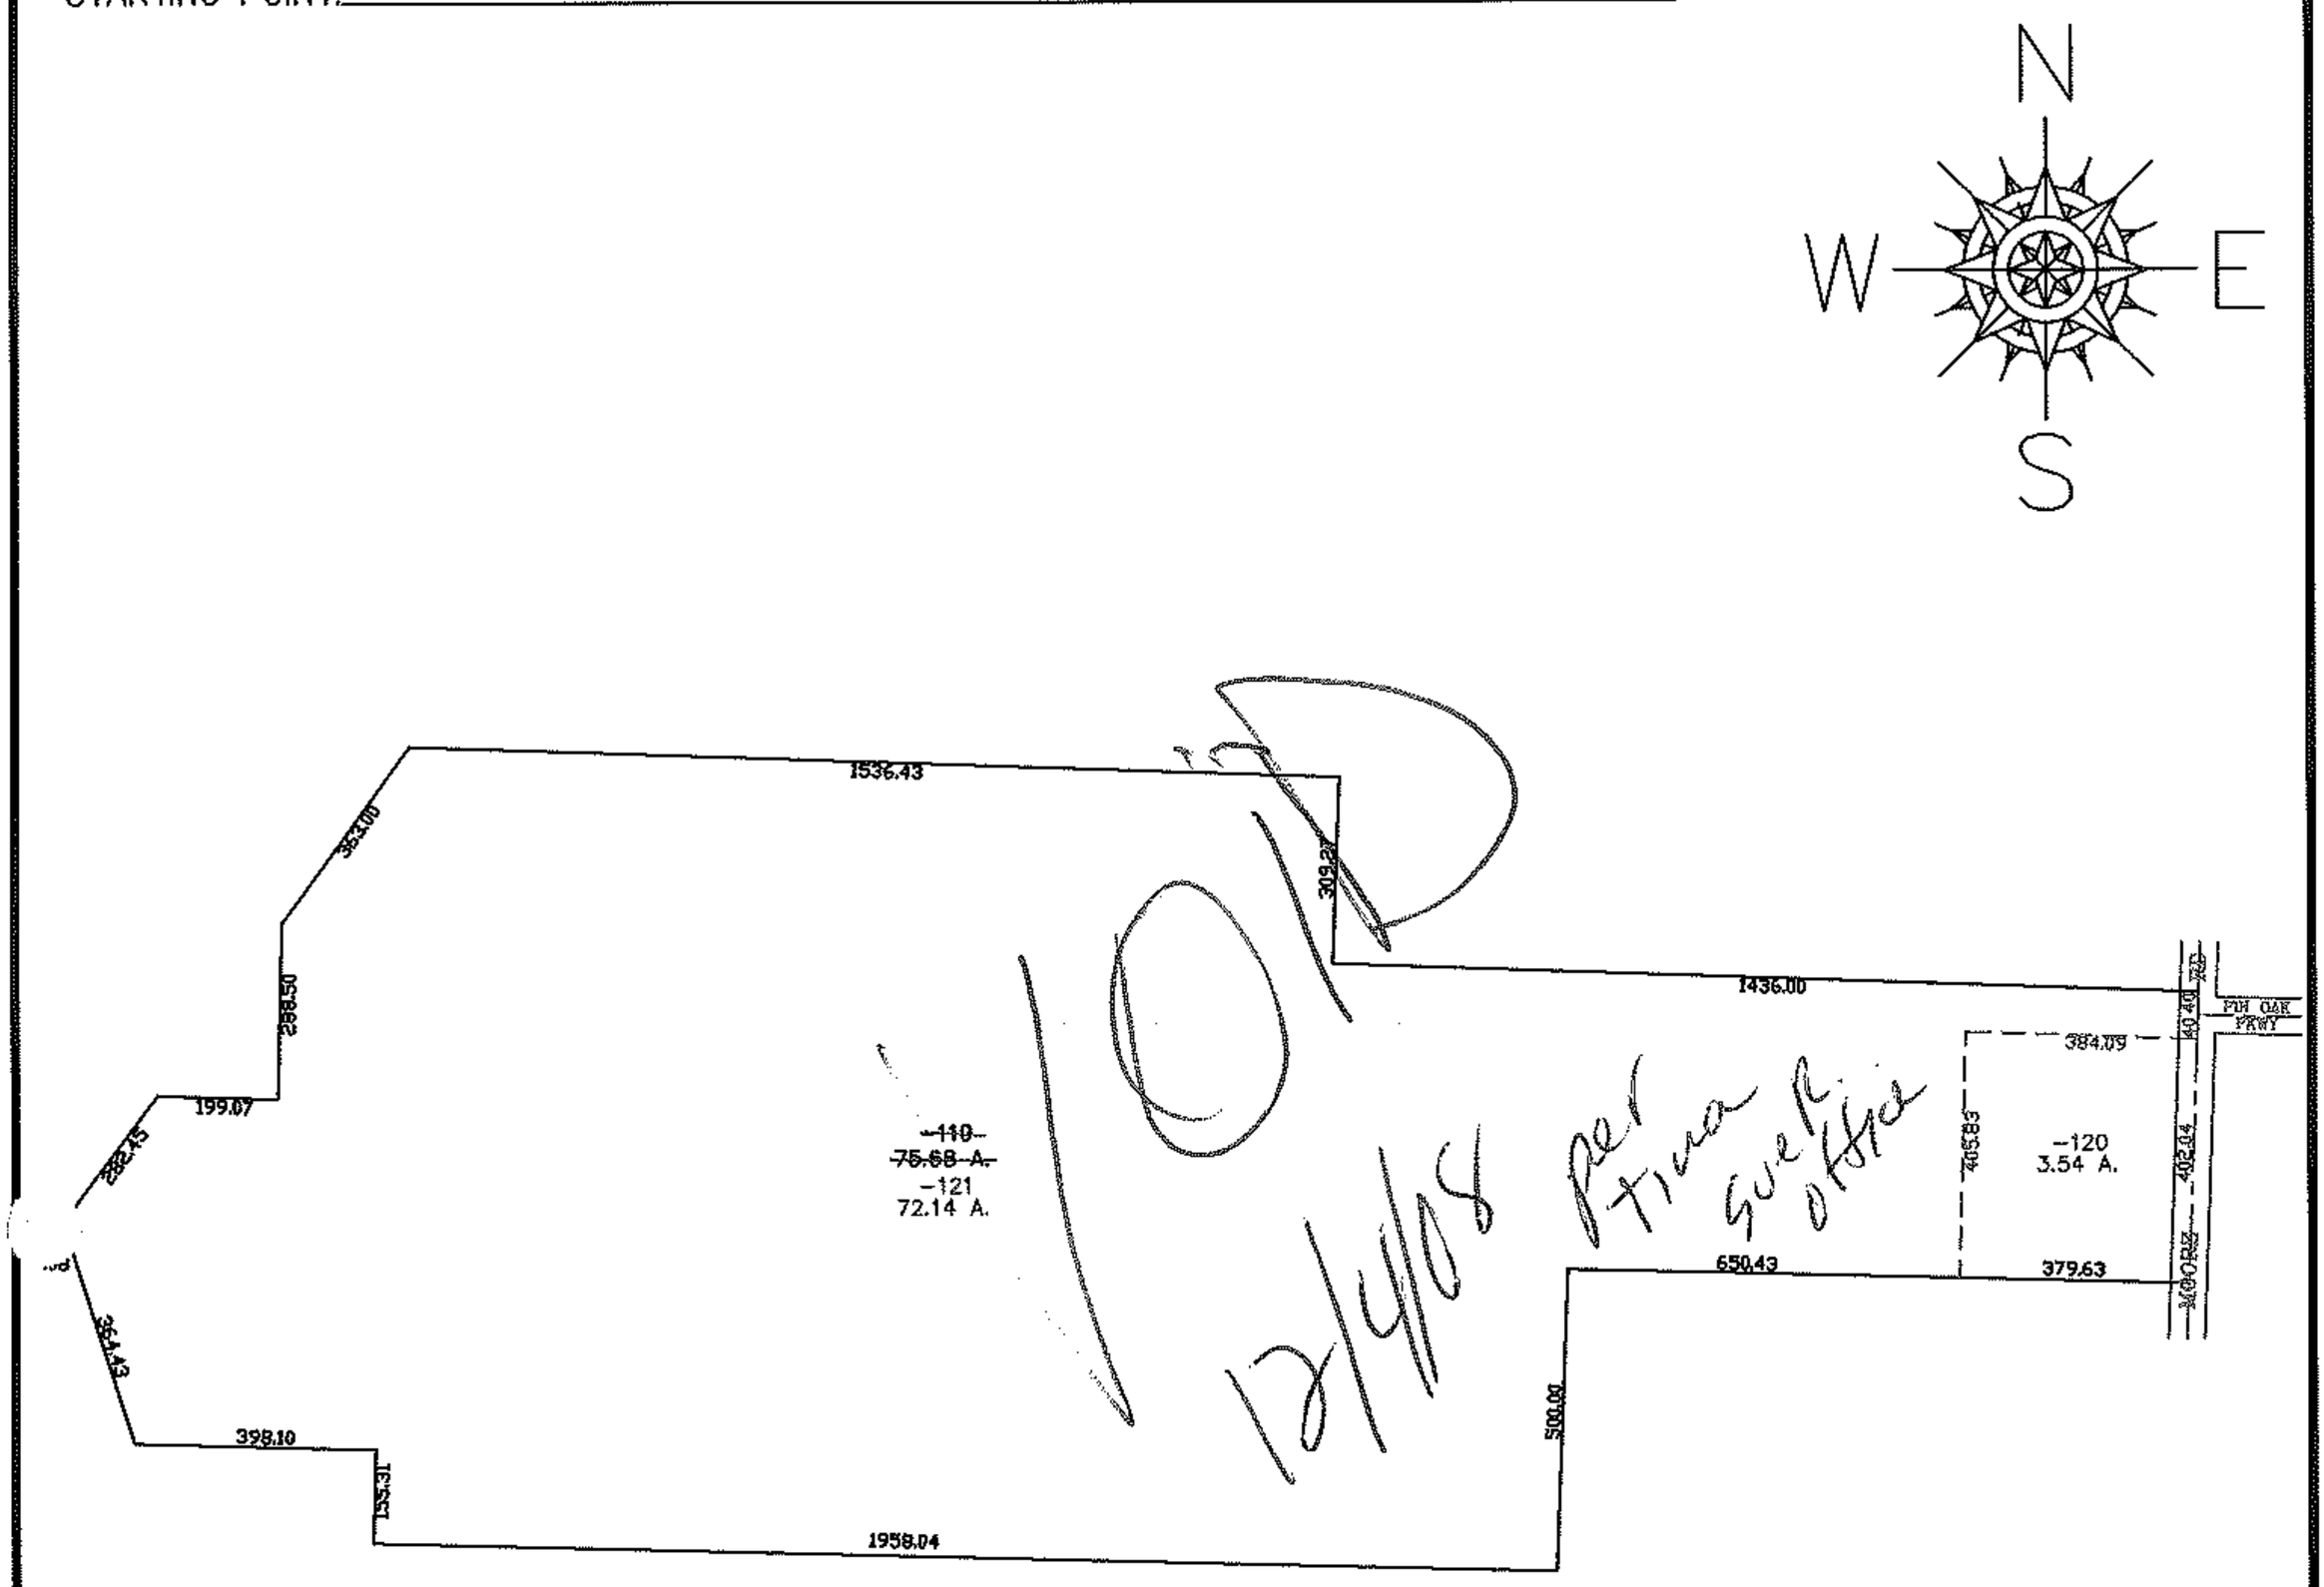

SPLITS/DEEDS PROCESSED

LORAIN COUNTY TAX MAP DEPARTMENT
226 MIDDLE AVE. ELYRIA, OHIO

SURVEYED BY: DALE HAYWOOD

CLOSURE: 0.00 : 10,000

MAP PAGE(S): 04-00-005-D

APPROVED BY: JAH DATE: 8-20-08

SCALE: 1"= 500 PRIOR INSTRUMENT: 20070185751