RASTER

PARENT PARCEL: 11-00-080-000-053, -022

CHILD PARCEL: 11-00-080-000-086 THRU -089

STARTING POINT: CENTERLINE OF ELM ST & O.L. 80

08-02613

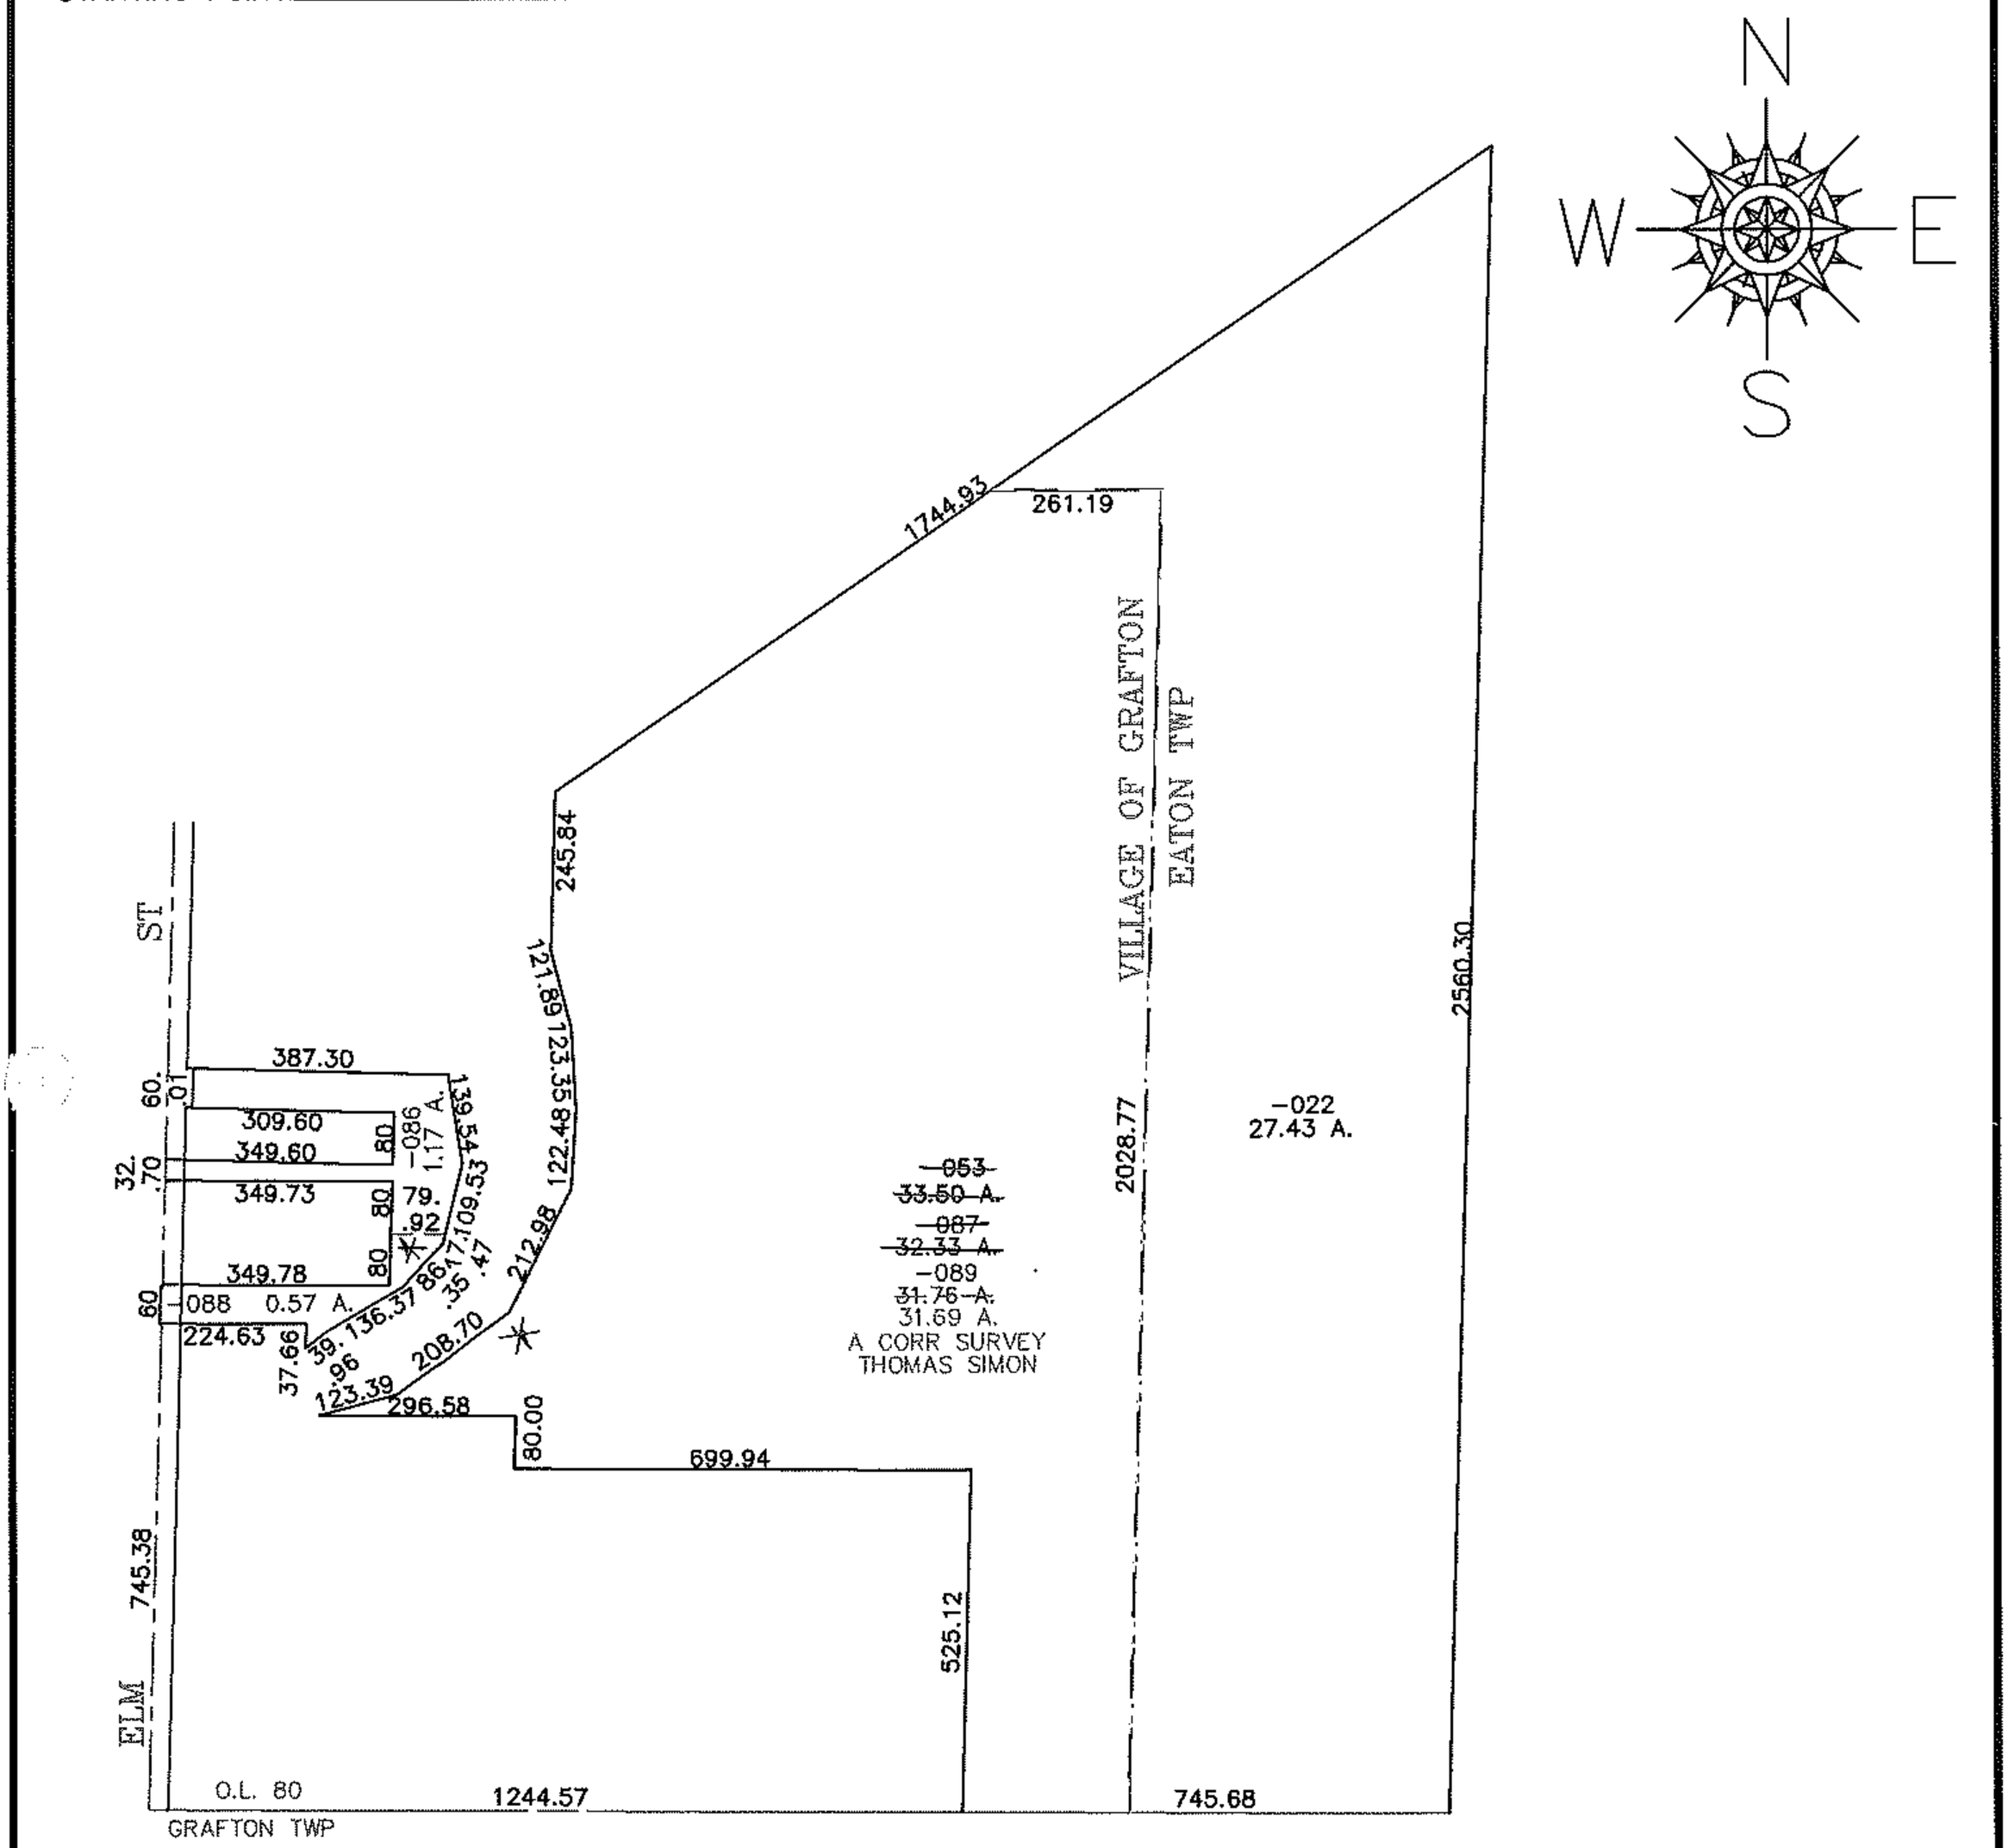

SPLITS/DEEDS PROCESSED

LORAIN COUNTY TAX MAP DEPARTMENT
226 MIDDLE AVE. ELYRIA, OHIO

SURVEYED BY: THOMAS SIMON

CLOSURE: 0.00 : 10,000

MAP PAGE(S): 11-00-080-A

APPROVED BY: JAH DATE: 9-30-08

SCALE: 1"= 400 PRIOR INSTRUMENT: 19970504872