PARENT PARCEL: 07-00-011-102-012, -009, -013, -014

CHILD PARCEL: 07-00-011-102-148 THRU -150

STARTING POINT: CENTERLINE OF BAGLEY RD & WOODBRIDGE CT

08-02616

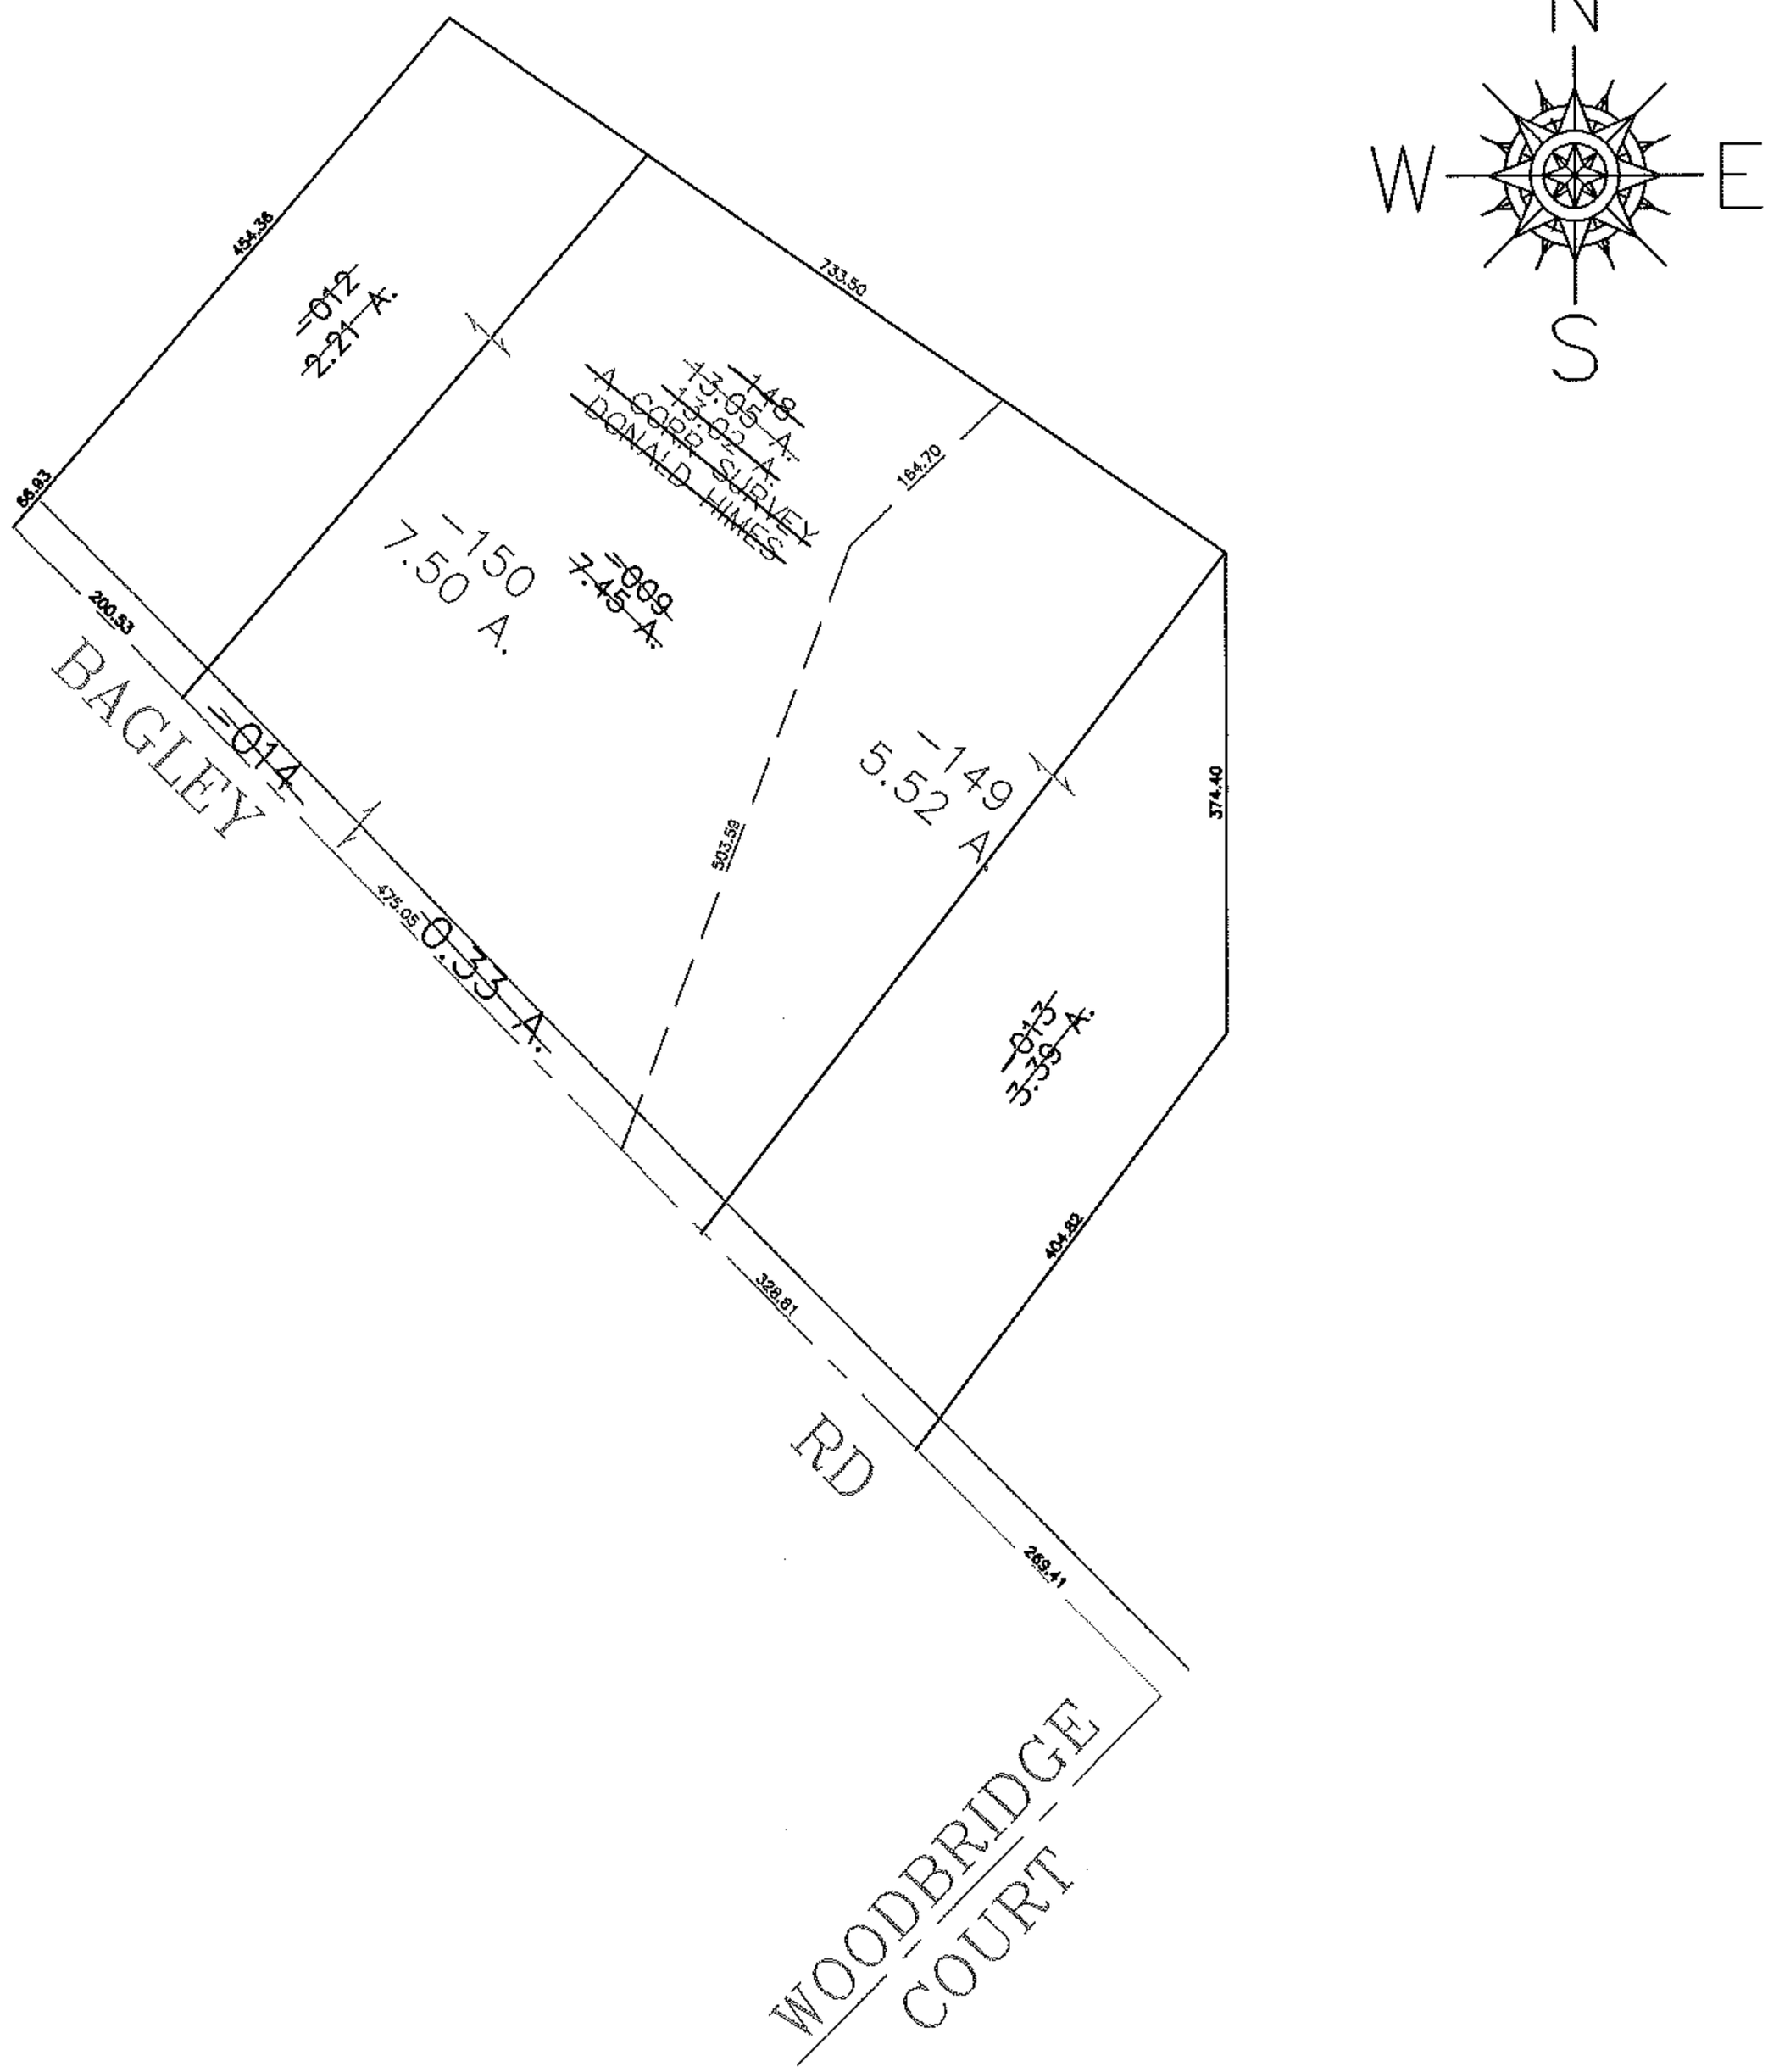

SPLITS/DEEDS PROCESSED

LORAIN COUNTY TAX MAP DEPARTMENT
226 MIDDLE AVE. ELYRIA, OHIO

SURVEYED BY: DONALD E HIMES

CLOSURE: 0.00 : 10,000

MAP PAGE(S): 07-00-011-A

APPROVED BY: JAH DATE: 10-1-08

SCALE: 1"= 200 PRIOR INSTRUMENT: 20060154208