PARENT PARCEL: 04-00-009-000-059

CHILD PARCEL:

STARTING POINT: AT A MON BOX AT THE INTERSECTION OF C/L OF CHESTER RD. AND C/L OF MOORE RD.

12-02622-D

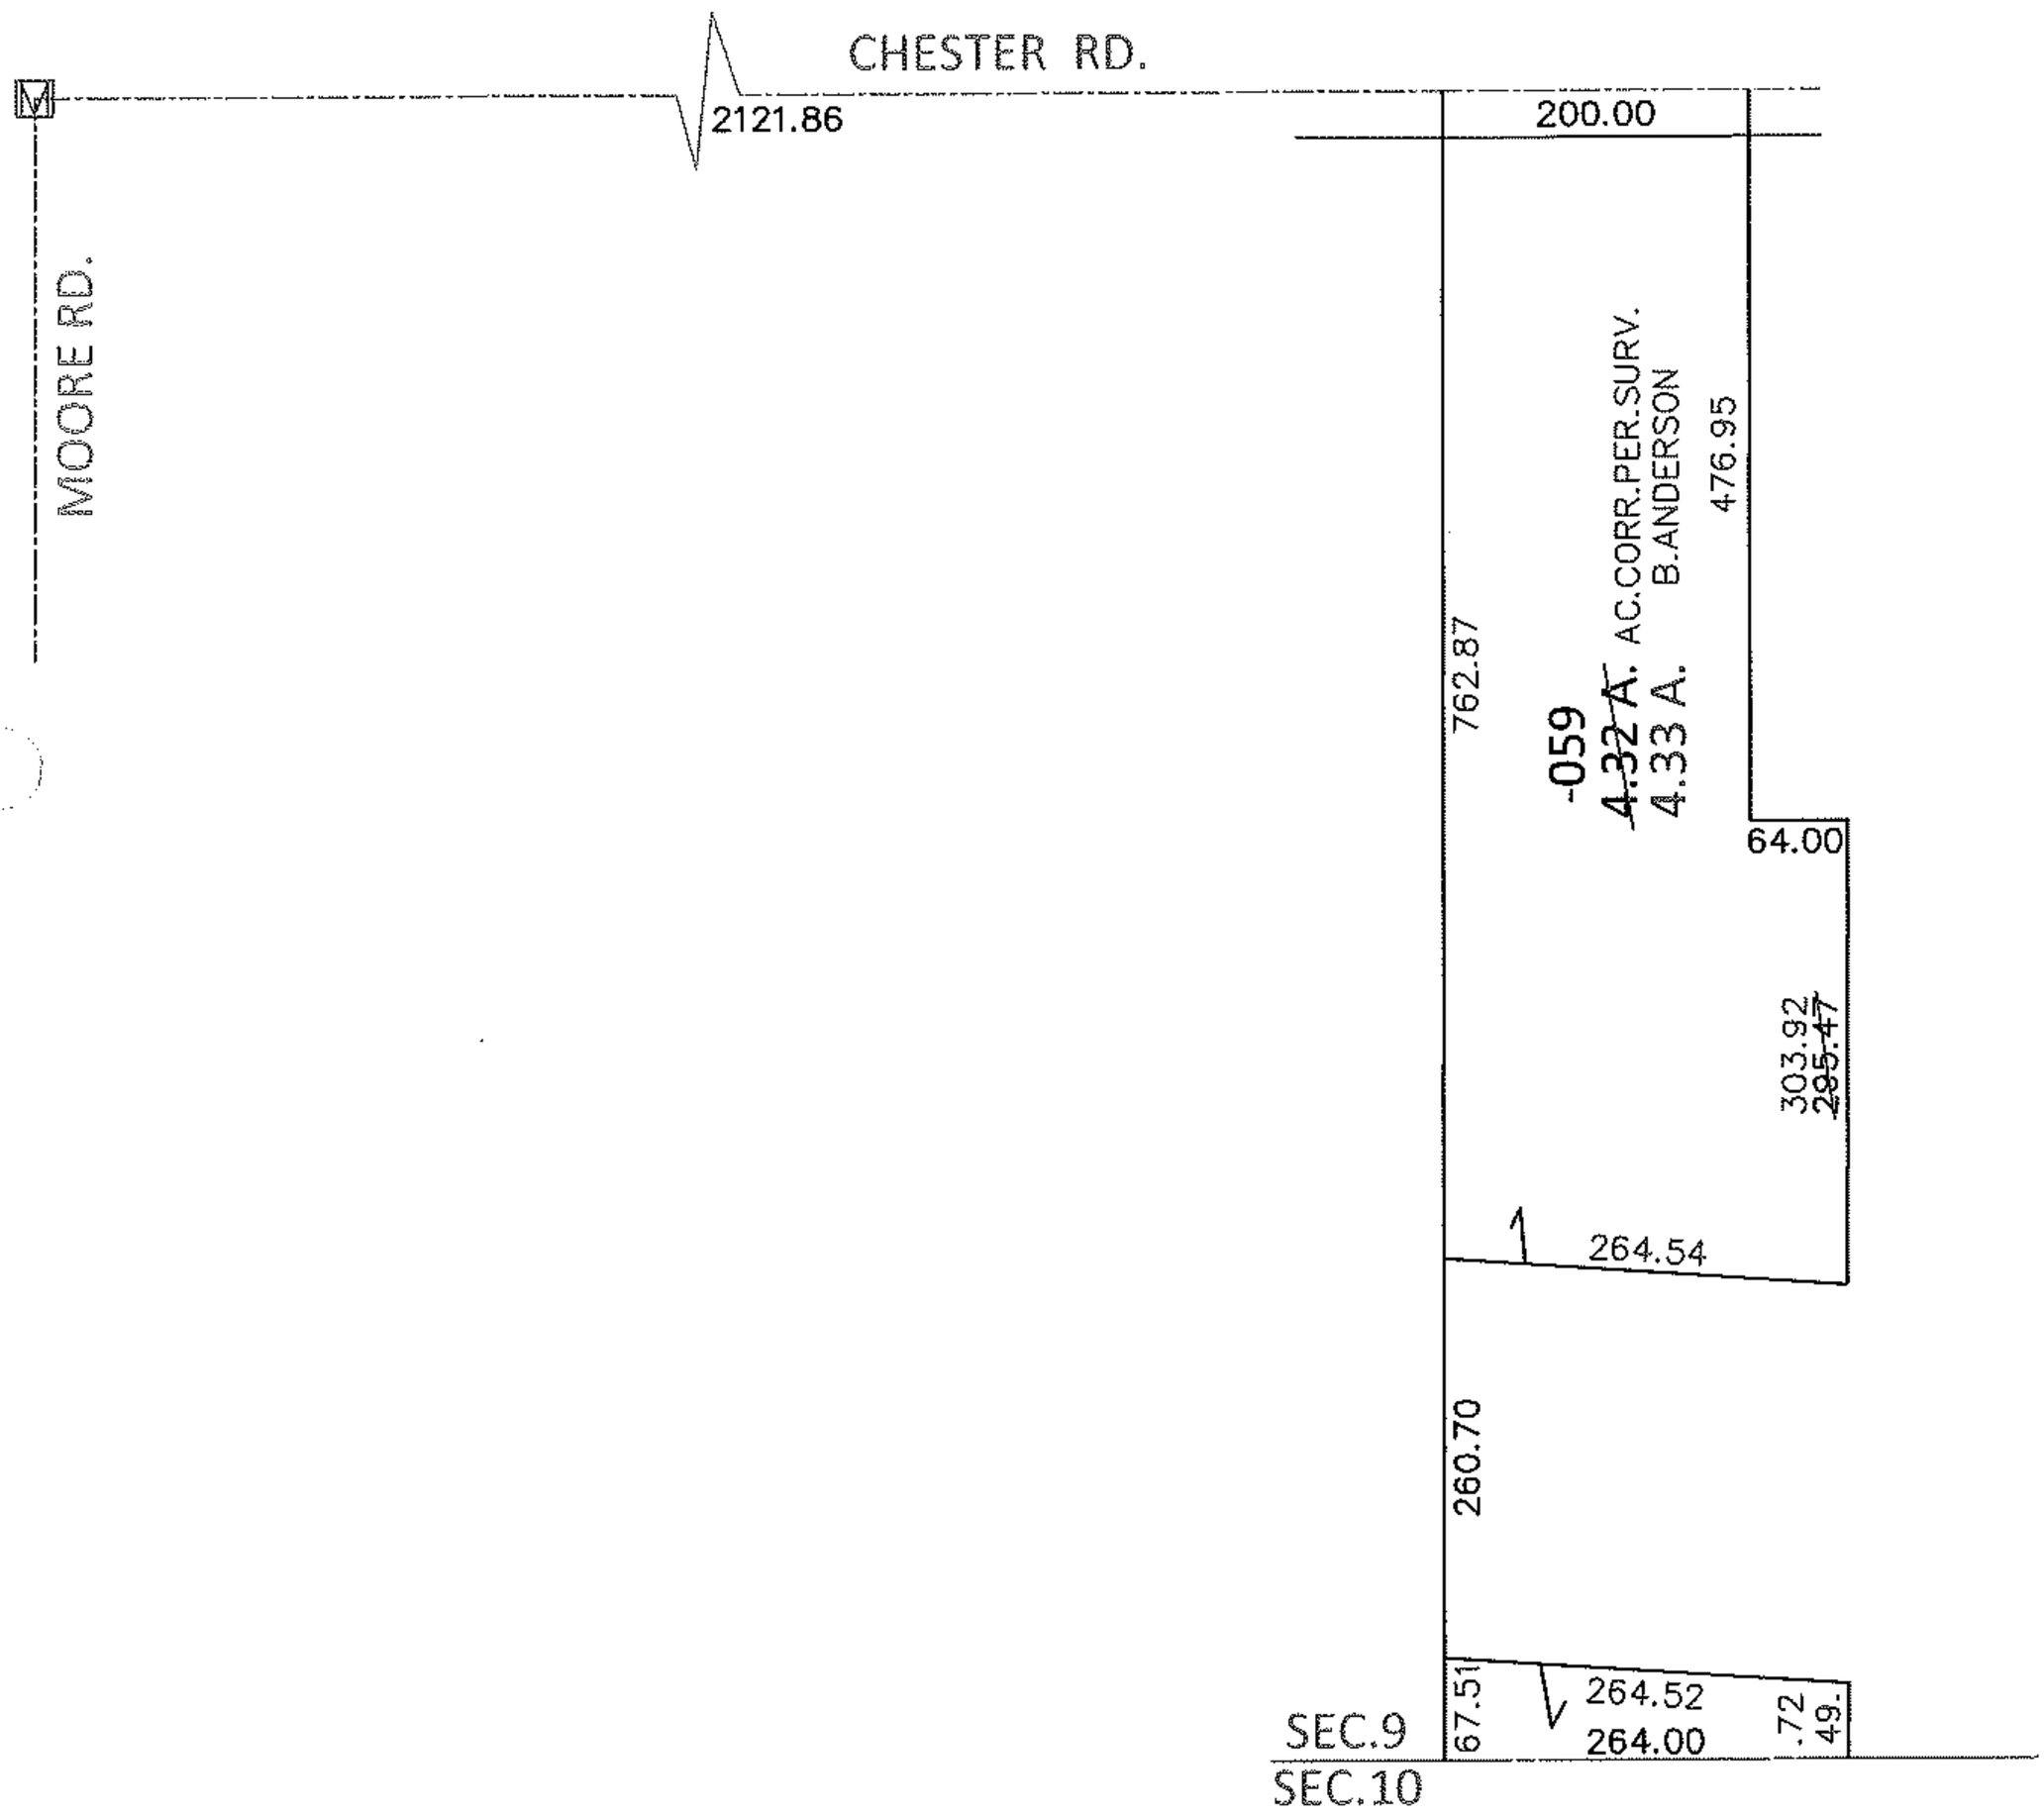

SPLITS/DEEDS PROCESSED

LORAIN COUNTY TAX MAP DEPARTMENT
226 MIDDLE AVE. ELYRIA, OHIO

SURVEYED BY: BRENT D. ANDERSON

CLOSURE: .01:10,000

MAP PAGE(S): 4-00-009-F

APPROVED BY: RRM DATE: 11-29-12

SCALE: 1"= 200 PRIOR INST.: 20090285202